




Date: 06.26.15	EX05
Scale: 1/4" = 1'-0"	
Drawn By: HV	



RIGHT SIDE ELEVATION

Multi-Family
Residential
Property

21 Cherry St.,
Somerville MA

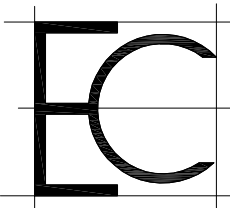

Existing Conditions Surveys Inc.
398 Columbus Avenue #334
Boston, MA 02116 USA

T 617.247.9161
F 617.249.0746
E info@existingconditions.com
www.existingconditions.com

**The Most Accurate
Existing Conditions Surveys and
As-Built Surveys**

All projects are measured using the most advanced laser measuring equipment and our best standards and practices. All work will be field verified by client prior to design or construction or other use, please visit www.existingconditions.com for terms and conditions of use.

www.existingconditions.com

Revision Schedule		
Revision Number	Revision Description	Revision Date

Right Side
Elevation


Date: 06.26.15

Scale: 1/4" = 1'-0"

Drawn By: HV


EX04

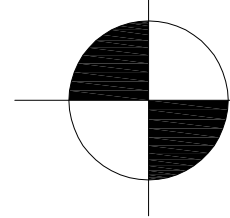

 LEFT SIDE ELEVATION

Multi-Family
Residential
Property

21 Cherry St.,
Somerville MA

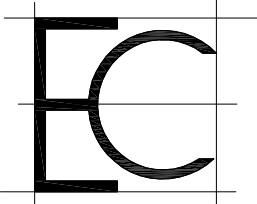

Existing Conditions Surveys Inc.
398 Columbus Avenue #334
Boston, MA 02116 USA

T 617.247.9161
F 617.249.0746
E info@existingconditions.com
www.existingconditions.com

The Most Accurate
Existing Conditions Surveys and
As-Built Surveys

All projects are measured using the most advanced laser measuring equipment and our best standards and practices. All work will be field verified by client prior to design or construction or other use, please visit www.existingconditions.com for terms and conditions of use.

www.existingconditions.com

Revision Schedule		
Revision Number	Revision Description	Revision Date

Left Side
Elevation


Date: 06.26.15

Scale: 1/4" = 1'-0"

Drawn By: HV


EX03

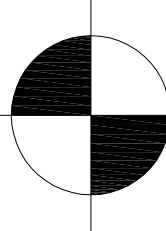

 REAR ELEVATION

Multi-Family
Residential
Property

21 Cherry St.,
Somerville MA

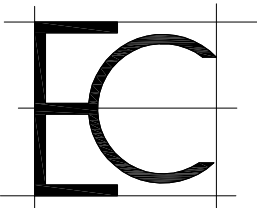

Existing Conditions Surveys Inc.
398 Columbus Avenue #334
Boston, MA 02116 USA

T 617.247.9161
F 617.249.0746
E info@existingconditions.com
www.existingconditions.com

The Most Accurate
Existing Conditions Surveys and
As-Built Surveys

All projects are measured using the most advanced laser measuring equipment and our best standards and practices. All work will be field verified by client prior to design or construction or other use, please visit www.existingconditions.com for terms and conditions of use.

www.existingconditions.com

Revision Schedule

Revision Number	Revision Description	Revision Date


Rear Elevation

Date: 06.26.15

Scale: 1/4" = 1'-0"

Drawn By: HV

EX06

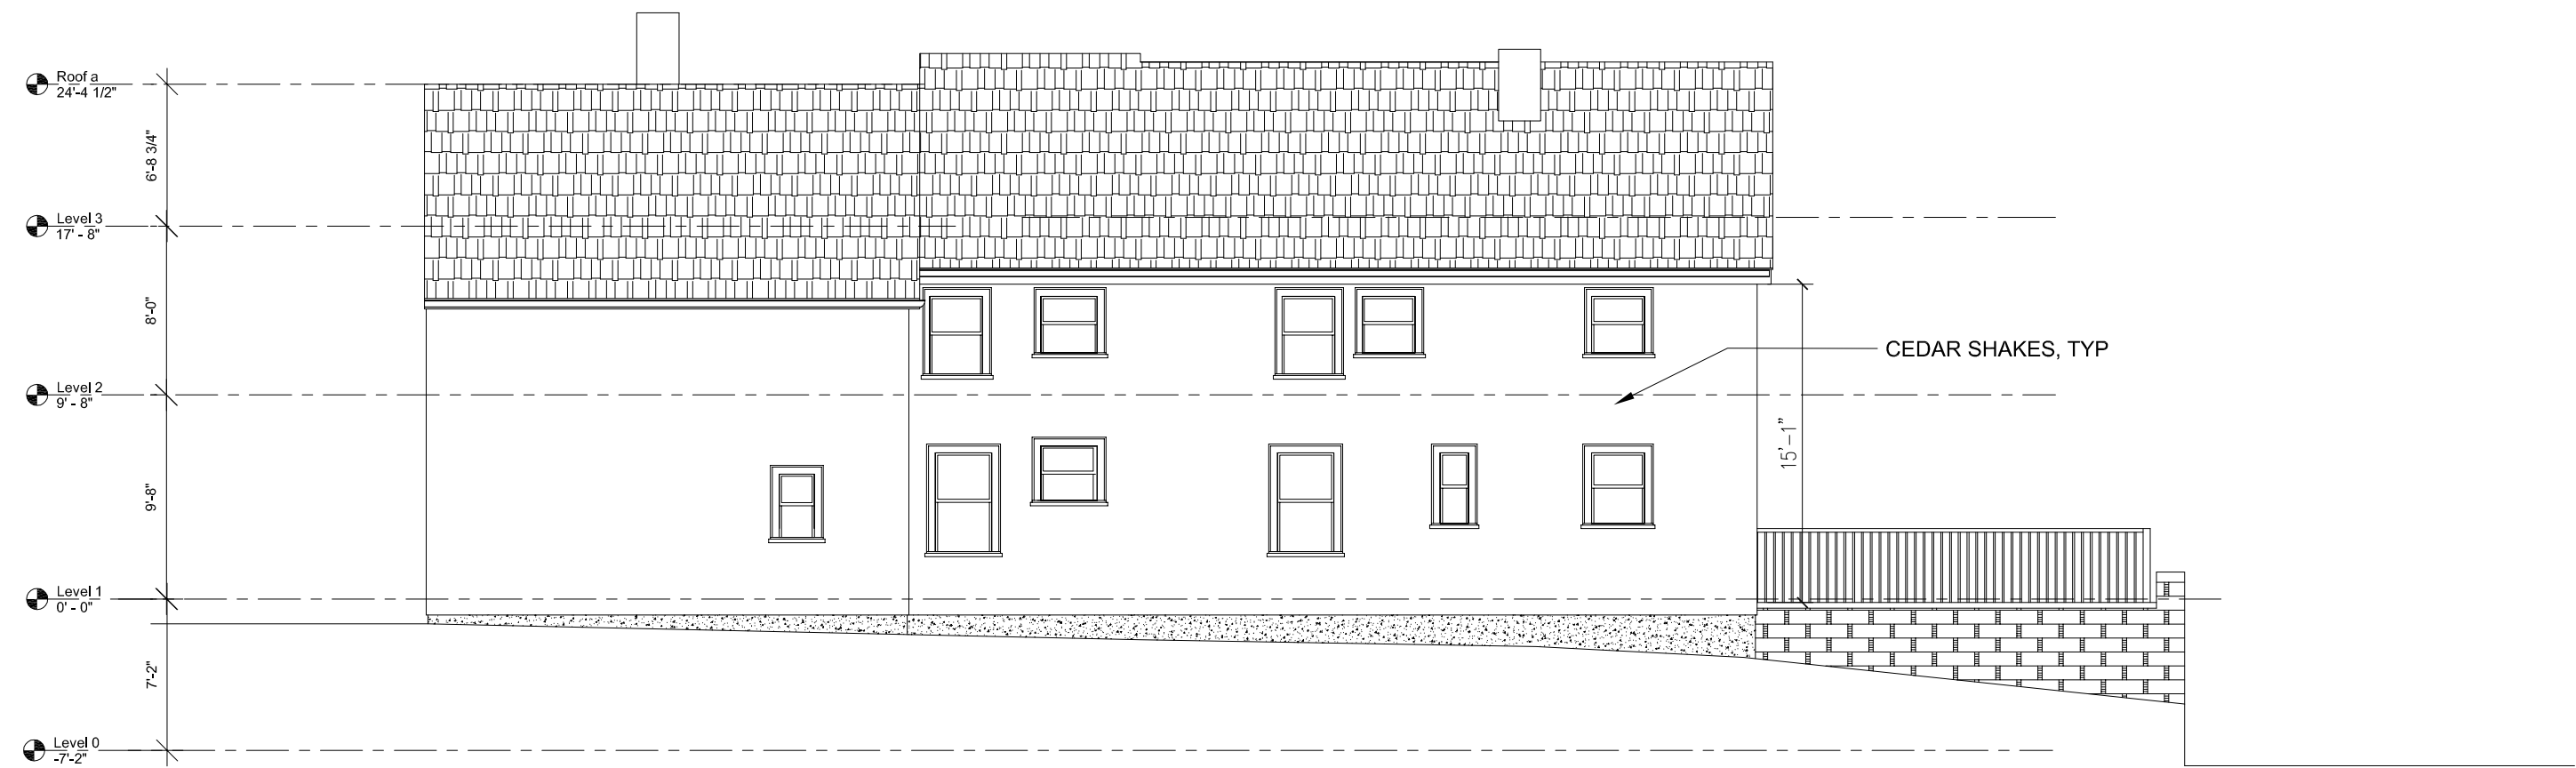

LEFT SIDE ELEVATION



REAR ELEVATION




RIGHT SIDE ELEVATION



CHERRY ST ELEVATION

Multi Family Residence Property

21 Cherry St.,
Somerville MA

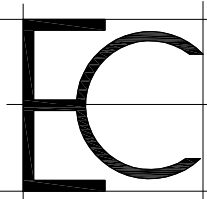

Existing Conditions Surveys Inc.

398 Columbus Avenue #334
Boston, MA 02116 USA

T 617.247.9161
F 617.249.0746
E info@existingconditions.com
www.existingconditions.com

The Most Accurate Existing Conditions Surveys and As-Built Surveys

All projects are measured using the most advanced laser measuring equipment and our best standards and practices. All work will be field verified by client prior to design or construction or other use, please visit www.existingconditions.com for terms and conditions of use.

www.existingconditions.com

Revision Schedule

Revision Number	Revision Description	Revision Date

Existing Elevations


Date: 06.26.15

Scale: 1/8" = 1'-0"

Drawn By: hv


EX01

BASEMENT FLOOR PLAN
869 gsf TOTAL

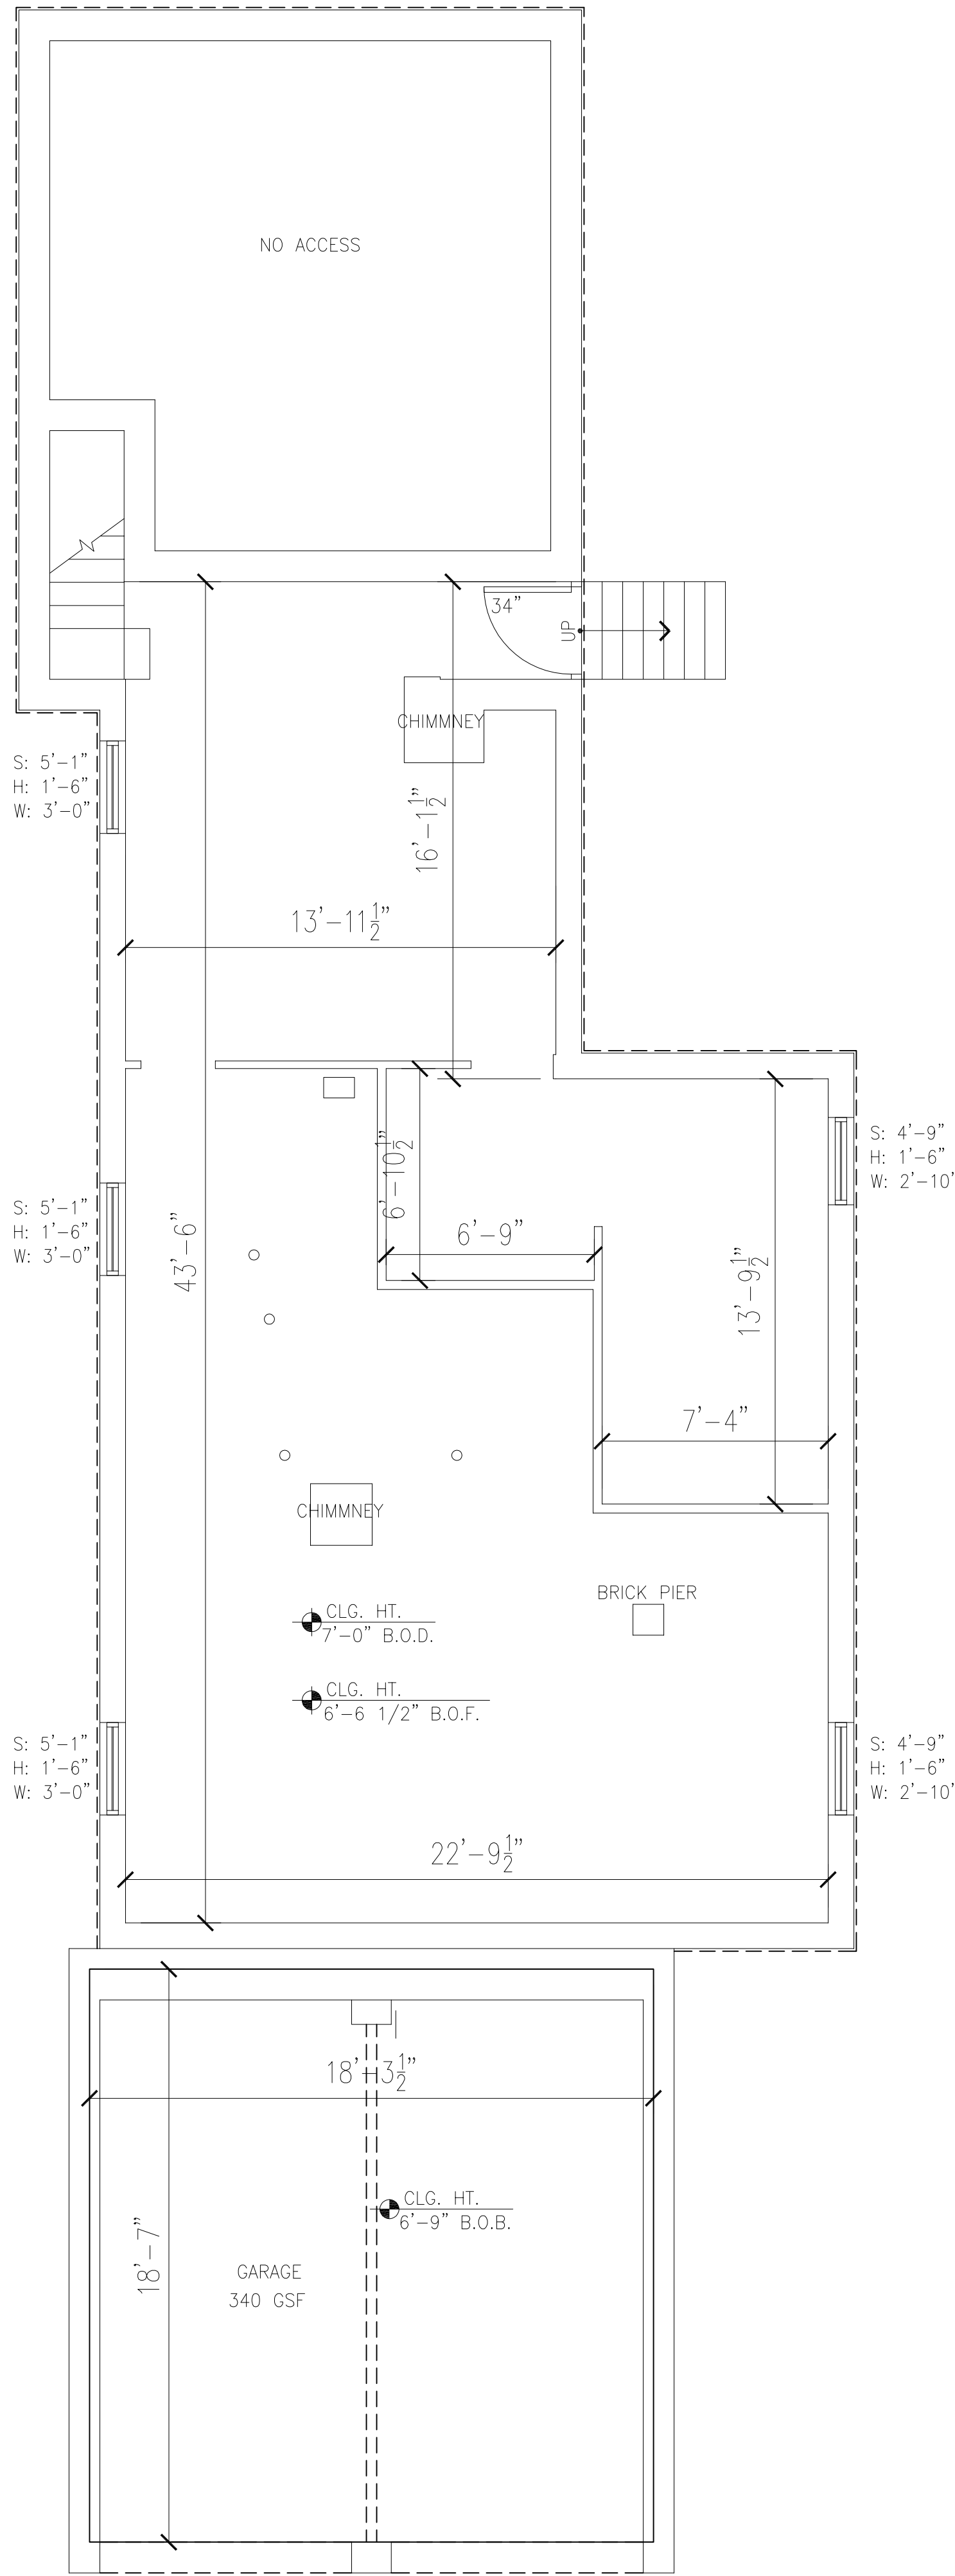

Multi-Family
Residential
Property

21 Cherry St.,
Somerville MA

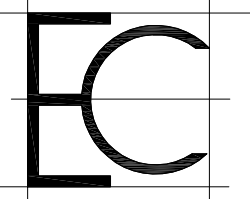

Existing Conditions Surveys Inc.
398 Columbus Avenue #334
Boston, MA 02116 USA

T 617.247.9161
F 617.249.0746
E info@existingconditions.com
www.existingconditions.com

The Most Accurate
Existing Conditions Surveys and
As-Built Surveys

All projects are measured using the most advanced laser measuring equipment and our best standards and practices. All work will be field verified by client prior to design or construction or other use, please visit www.existingconditions.com for terms and conditions of use.


www.existingconditions.com

Revision Schedule		
Revision Number	Revision Description	Revision Date

Basement Floor
Plan

Date: 06.26.15
Scale: 1/4" = 1'-0"
Drawn By: HV


EX00

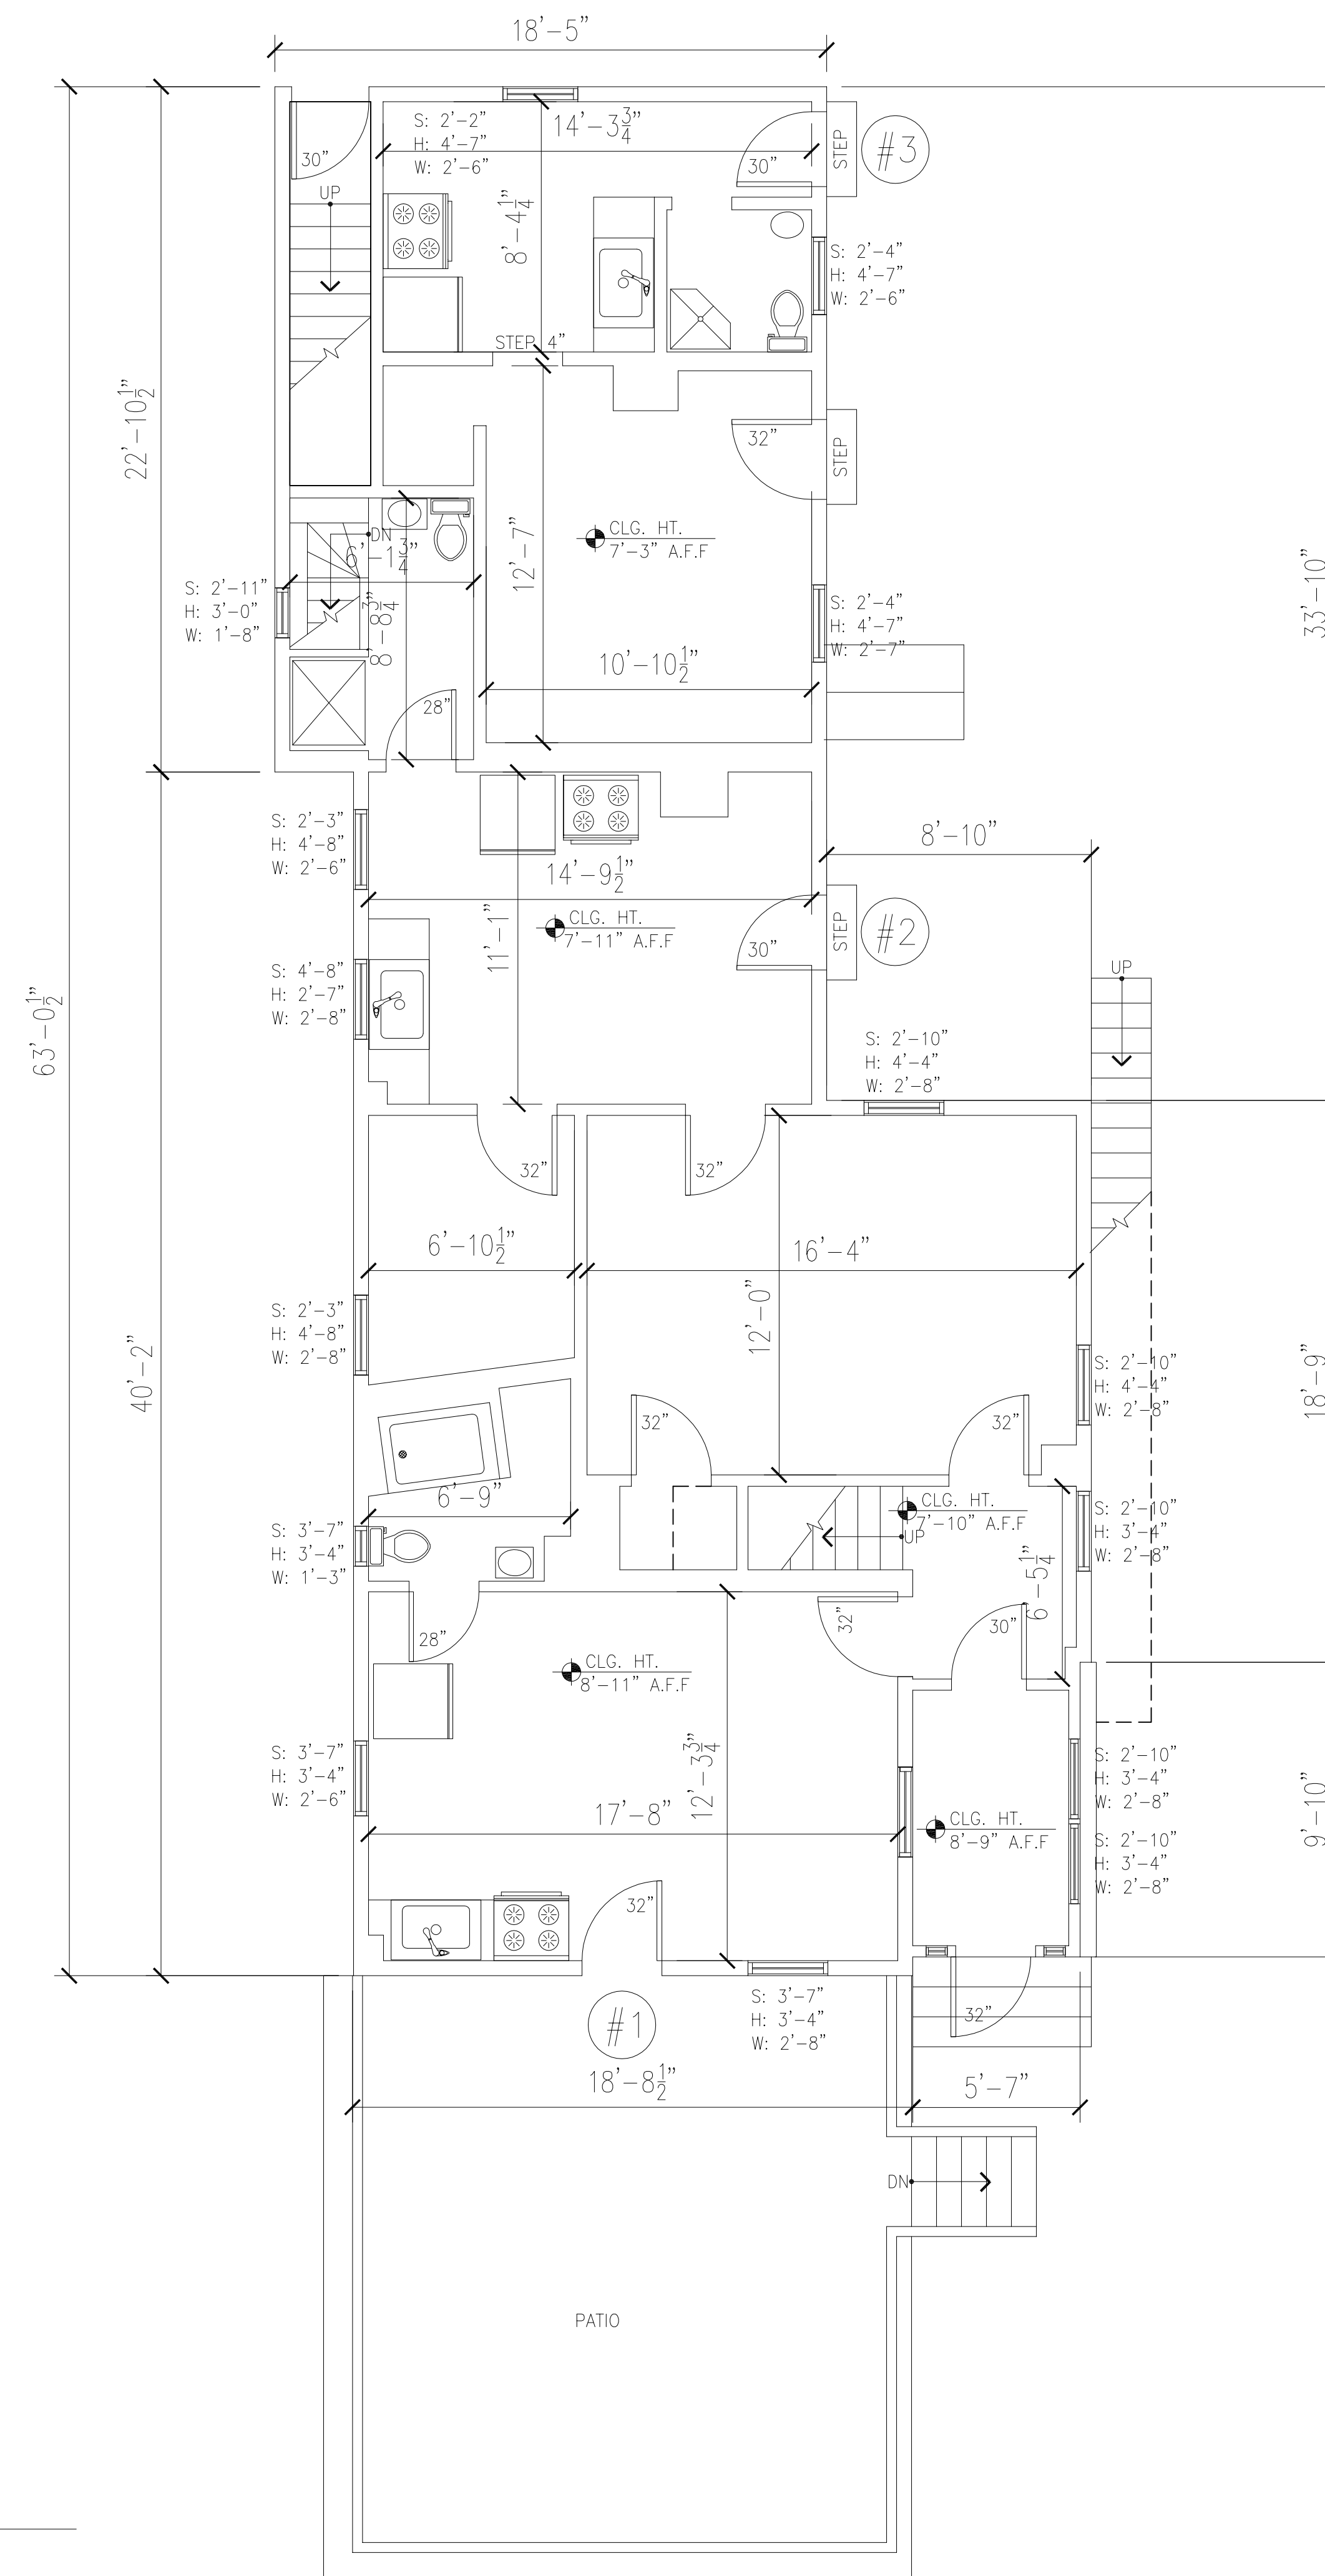

FIRST FLOOR PLAN
1,218 gsf TOTAL

Multi-Family
Residential
Property

21 Cherry St.,
Somerville MA

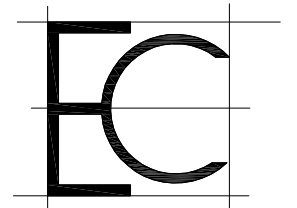

Existing Conditions Surveys Inc.
398 Columbus Avenue #334
Boston, MA 02116 USA

T 617.247.9161
F 617.249.0746
E info@existingconditions.com
www.existingconditions.com

**The Most Accurate
Existing Conditions Surveys and
As-Built Surveys**


All projects are measured using the most advanced laser measuring equipment and our best standards and practices. All work will be field verified by client prior to design or construction or other use, please visit www.existingconditions.com for terms and conditions of use.

www.existingconditions.com


[illegible]

First Floor Plan

Date: 06.26.15	EX01
Scale: 1/4" = 1'-0"	
Drawn By: HV	

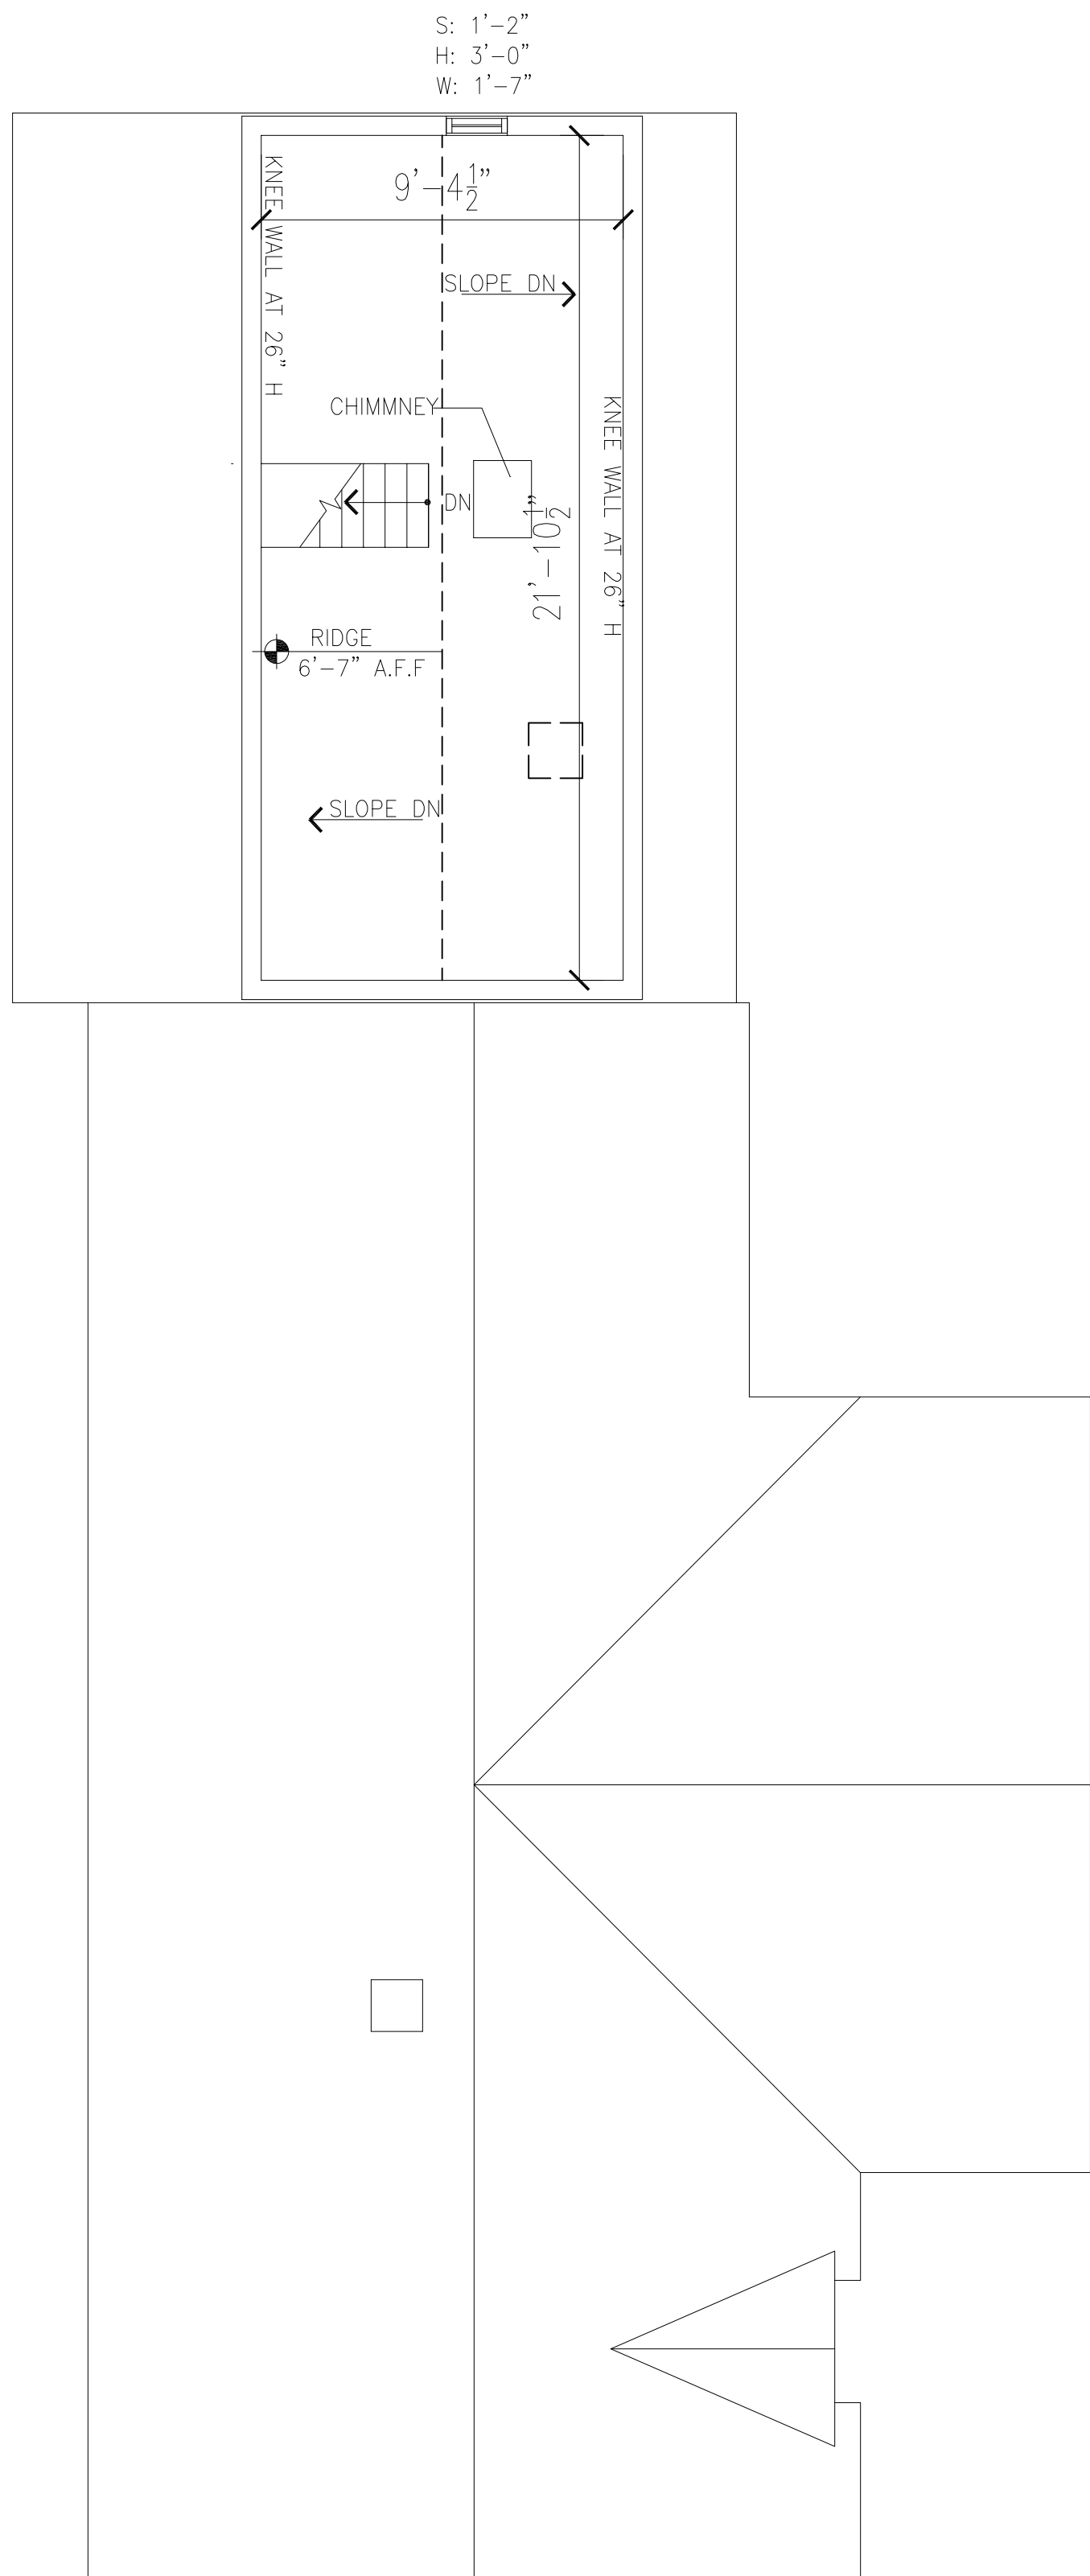


ATTIC FLOOR PLAN
205 gsf TOTAL

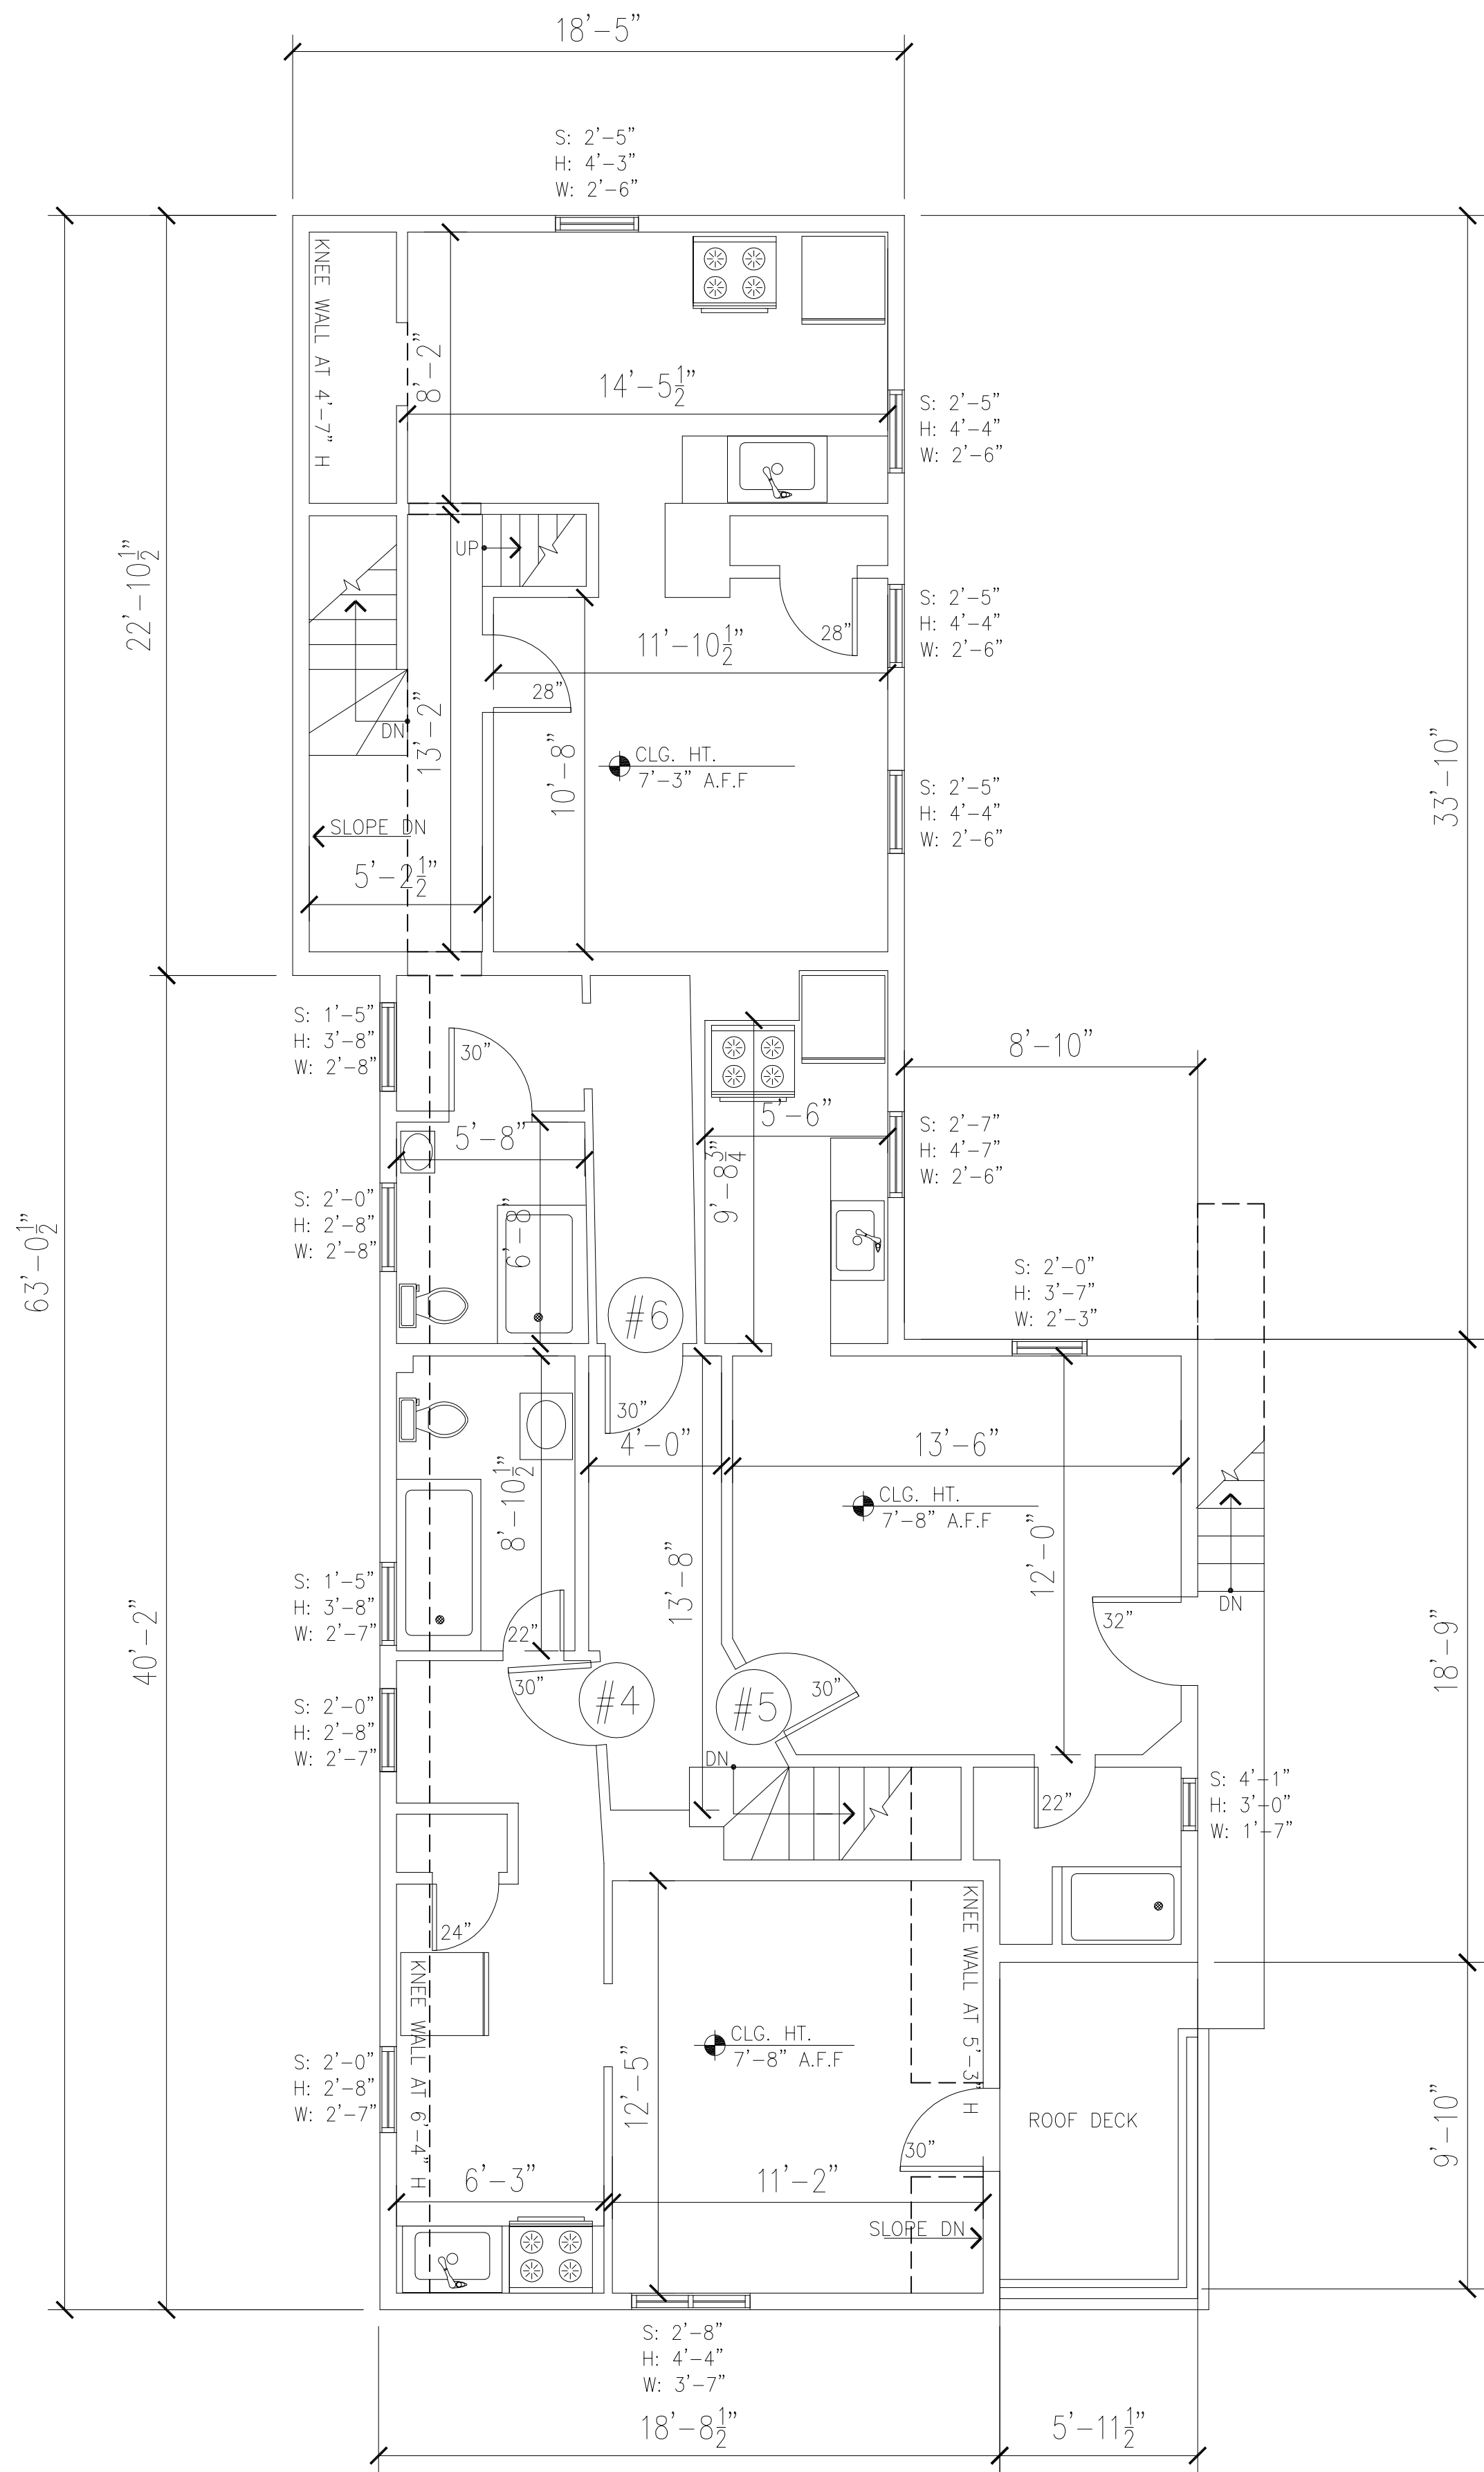

SECOND FLOOR PLAN
1,161 gsf TOTAL

Multi-Family
Residential
Property

21 Cherry St.,
Somerville MA

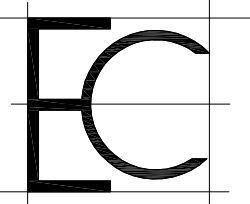

Existing Conditions Surveys Inc.
398 Columbus Avenue #334
Boston, MA 02116 USA

T 617.247.9161
F 617.249.0746
E info@existingconditions.com
www.existingconditions.com

The Most Accurate
Existing Conditions Surveys and
As-Built Surveys

All projects are measured using the most advanced laser measuring equipment and our best standards and practices. All work will be field verified by client prior to design or construction or other use. please visit www.existingconditions.com for terms and conditions of use.


www.existingconditions.com

Revision Schedule		
Revision Number	Revision Description	Revision Date


Second Floor and
Attic Plan

Date: 06.26.15
Scale: 1/4" = 1'-0"
Drawn By: HV

EX02

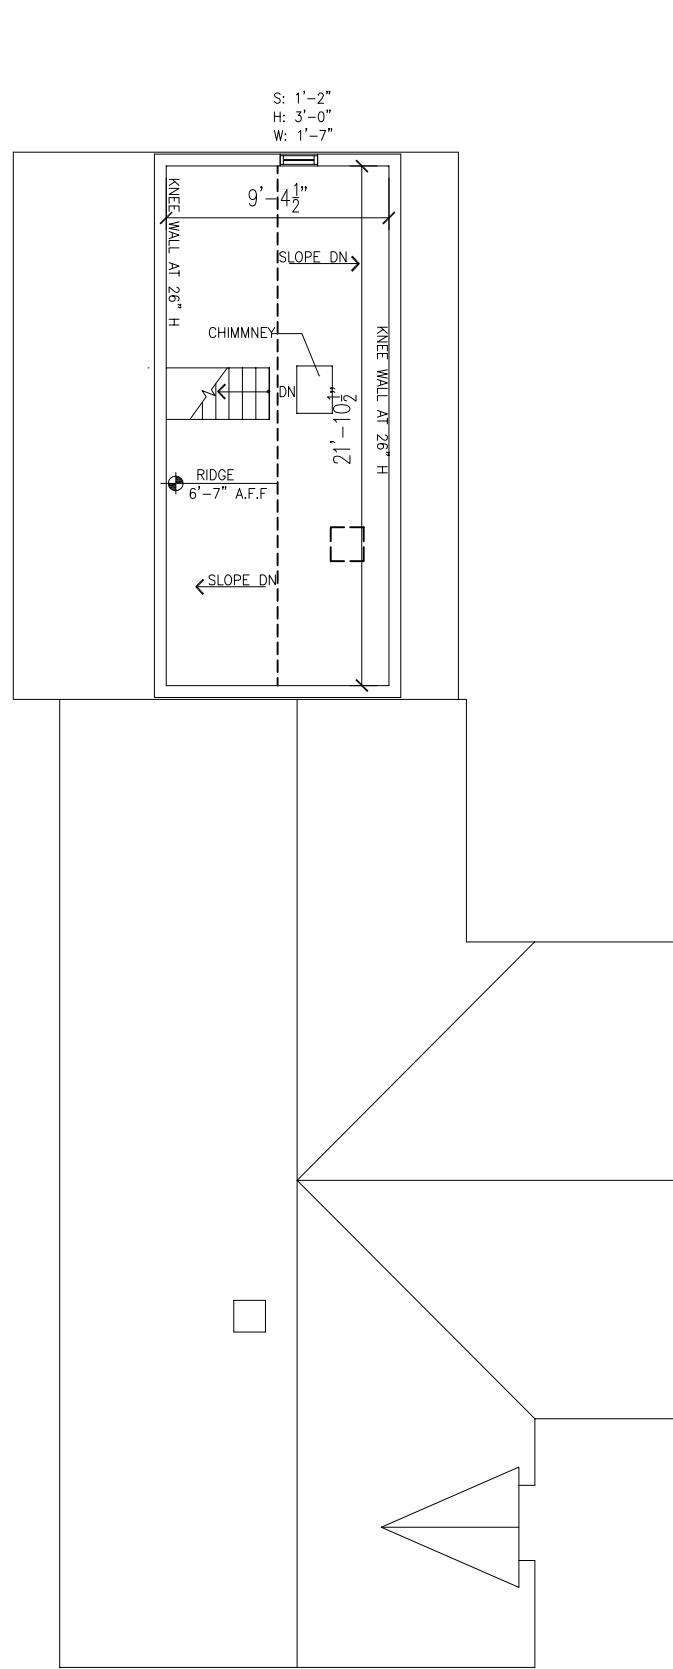


ATTIC FLOOR PLAN
205 gsf TOTAL

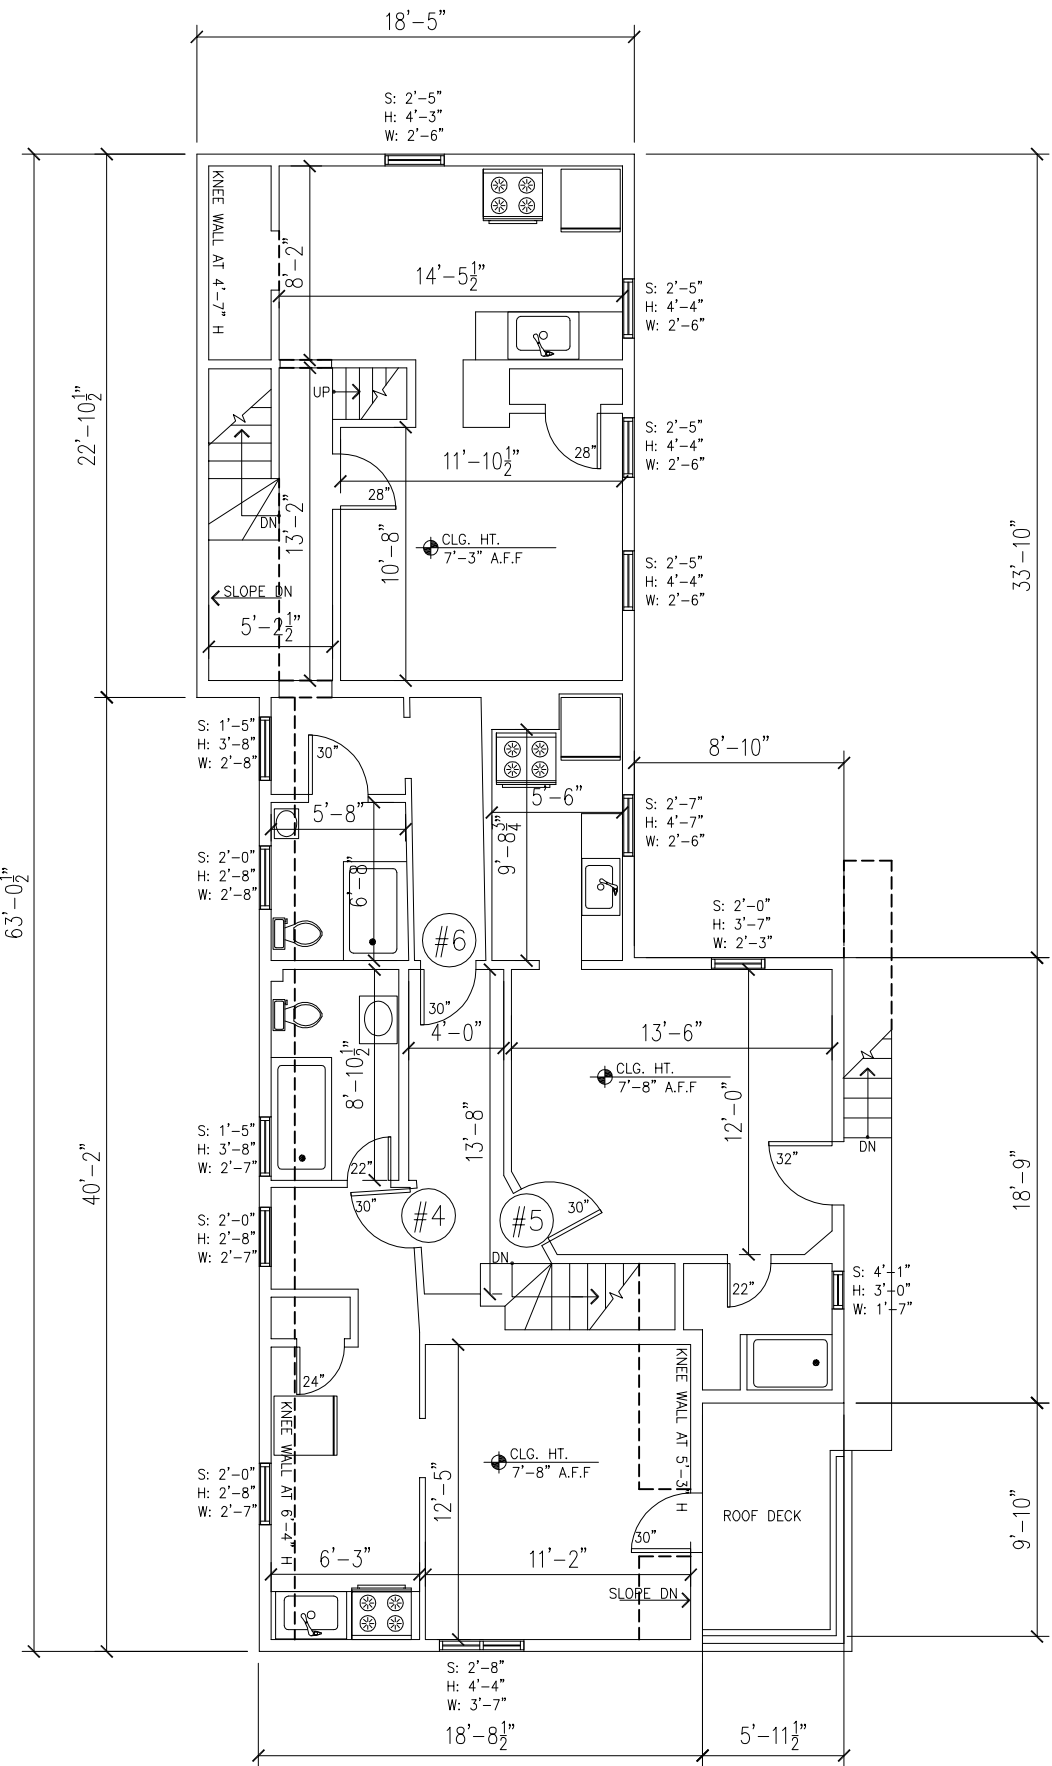


SECOND FLOOR PLAN
1,161 gsf TOTAL

309 gsf UNIT 4
252 gsf UNIT 5
723 gsf UNIT 6

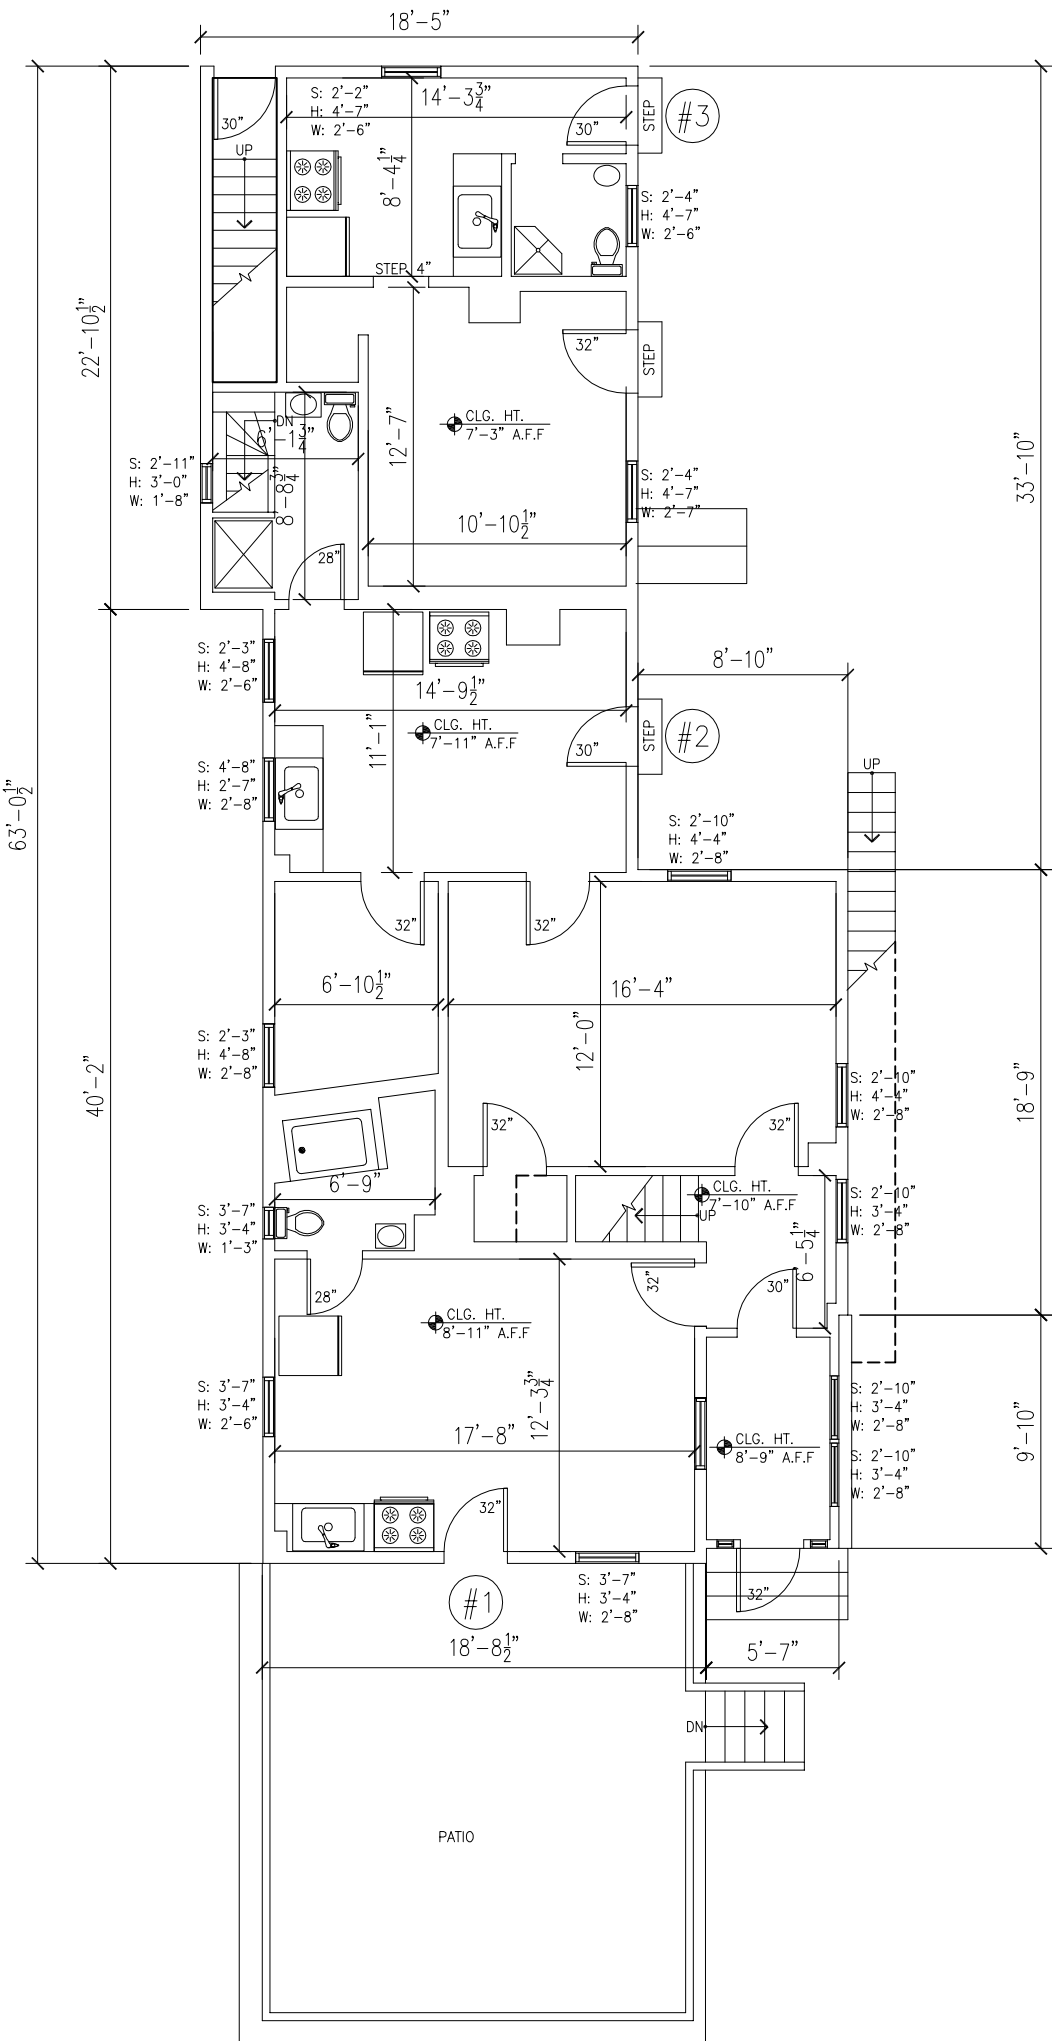

FIRST FLOOR PLAN
1,218 gsf TOTAL


260 gsf UNIT 1
497 gsf UNIT 2
277 gsf UNIT 3

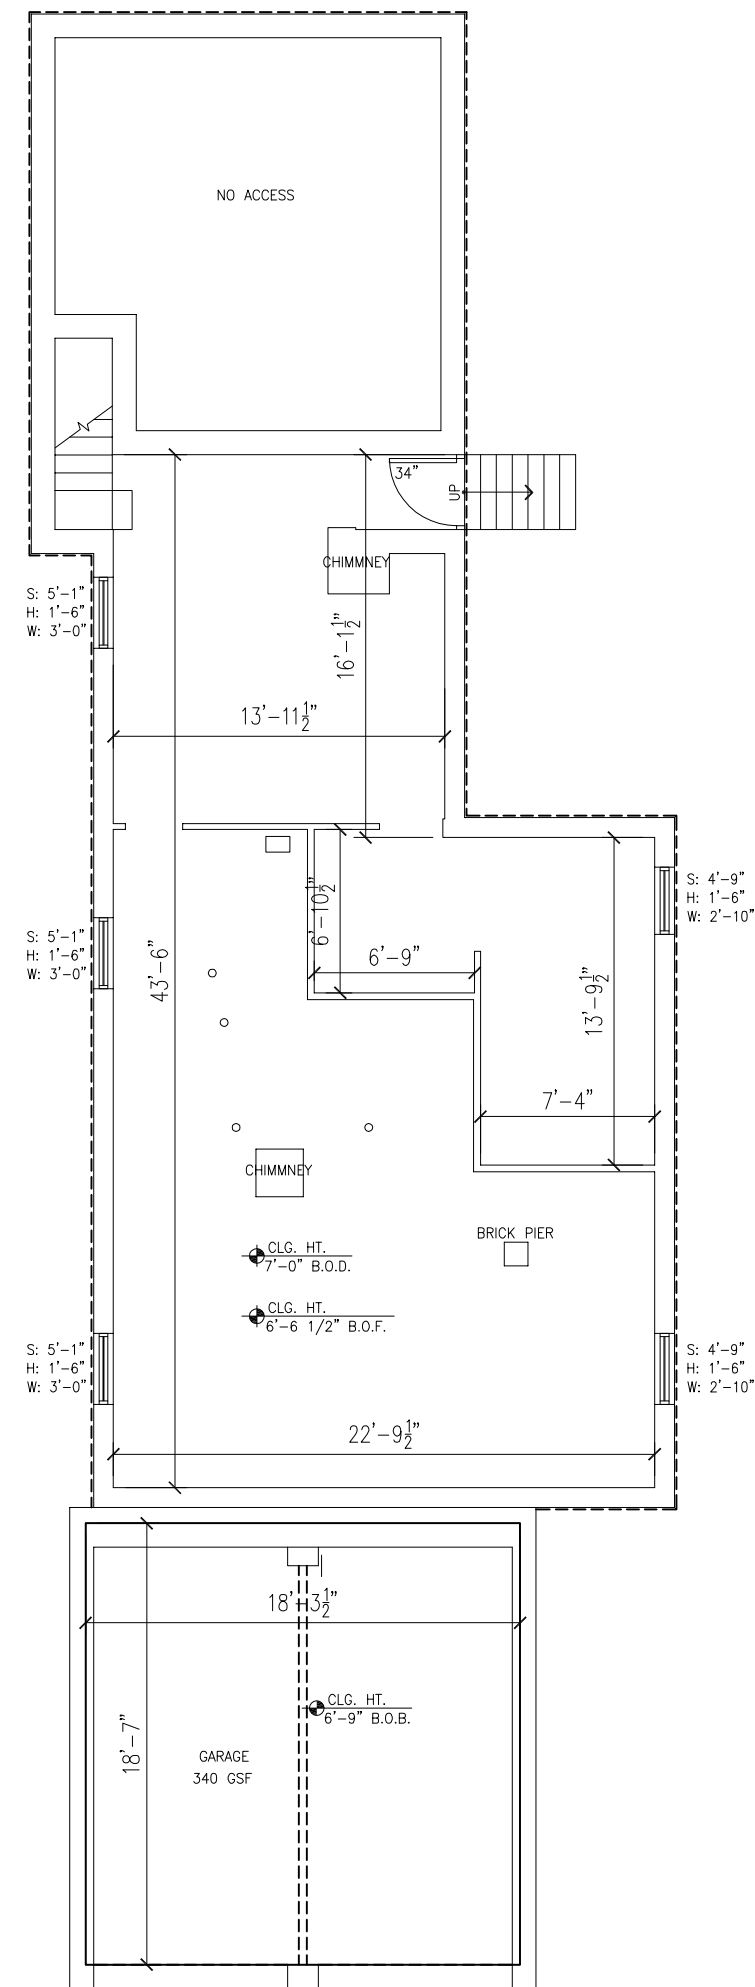

BASEMENT FLOOR PLAN
869 gsf

Multi Family Residence Property

21 Cherry St.,
Somerville MA

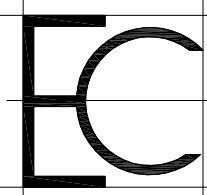

Existing Conditions Surveys Inc.

398 Columbus Avenue #334
Boston, MA 02116 USA

T 617.247.9161
F 617.249.0746
E info@existingconditions.com
www.existingconditions.com

The Most Accurate Existing Conditions Surveys and As-Built Surveys

All projects are measured using the most advanced laser measuring equipment and our best standards and practices. All work will be field verified by client prior to design or construction or other use, please visit www.existingconditions.com for terms and conditions of use.

www.existingconditions.com

Revision Schedule		
Revision Number	Revision Description	Revision Date

Existing Floor Plans

Date: 06.26.15

Scale: 1/8" = 1'-0"

Drawn By: hv

EX00