

Site Plans

Issued for: **Final Level PUD Approval- Final Submission**

Date Issued: January 22, 2013

Latest Issue: January 22, 2013

Sheet Index

Number	Drawing Title	Latest Issue
C-1	Legend and General Notes	01/22/2013
C-2	Neighborhood Context Map 1	01/22/2013
C-3	Neighborhood Context Map 2	01/22/2013
C-4	Overall Site Plan 1	01/22/2013
C-5	Overall Site Plan 2	01/22/2013
C-6	Layout and Materials Plan	01/22/2013
C-7	Grading, Drainage and Erosion Control Plan	01/22/2013
C-8	Utility Plan	01/22/2013

Bound Separately


A-1	Architectural Plans	09/10/2012
-----	---------------------	------------

Reference Plans

1-13	As Built Utility Plans	03/09/2012
1-18	Main Street Plaza Plans	06/01/2012

Assembly Square Block 2A

Assembly Square Drive
Somerville, Massachusetts

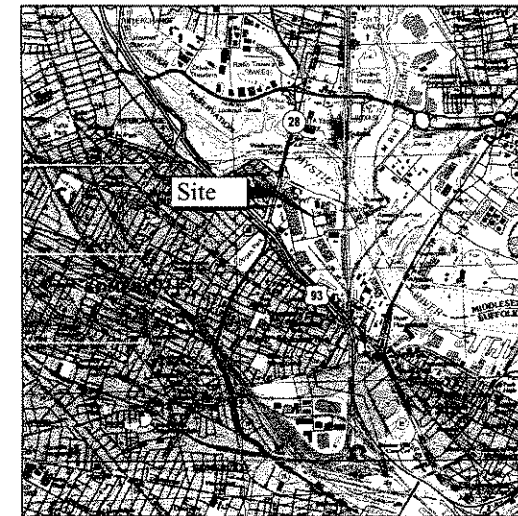


Site Location Map



0 1000 2000 Feet

Property Owners

Federal Realty
INVESTMENT TRUST

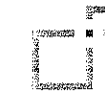


Owner/Applicant:
Street Retail, Inc.
1626 East Jefferson Street
Rockville, MD 20852
(P) 617-684-1500



Vanasse Hangen Brustlin, Inc.
Transportation
Land Development
Environmental Services

101 Walnut Street, P.O. Box 9151
Watertown, Massachusetts 02471
617.924.1770 • FAX 617.924.2286

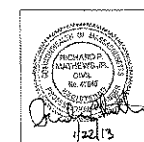

Vanasse Hangen Brustlin, Inc.

Transportation
Land Development
Environmental Services

101 Walnut Street, P.O. Box 9151
Watertown, Massachusetts 02471
617.924.1770 • FAX 617.924.2286

MURRAY BOX CULVERT (BRICK) FOR
CHARLESTOWN PUMPING STATION

RAILROAD

INDUSTRIAL

RETAIL

HOMEDEPOT

INTERSTATE ROUTE 93

KENSINGTON
AVENUE

ADDITIONAL PRETREATMENT FACILITY

[illegible]

Assembly Square
Block 2A
Pavilion
Assembly Square Drive
Somerville, Massachusetts

Final Level PUD Approval -
Final Submission
Not Approved for Construction

Neighborhood
Context Map 2


 RICHARD P. MATTHEWS, JR.
 CIVIL
 No. 41845
 Registered Professional Engineer
 State of Massachusetts
 1/22/13

Drawing Number
C-3
 Sheet of 4 9
 Project Number
 08518.05



101 Walnut Street, P.O. Box 9151
Watertown, Massachusetts 02471
617.924.1770 • FAX 617.924.2286

Project number
08518.05

Parking Summary Chart													
Descriptive	Size	Office	Retail	Restaurant	Residential	Hotel	Cinema	IKEA	Mail	Descriptive	Size	Office	Retail
STANDARD SPACES	9' x 18'	1,722	324	2,340	2,088	96	60	330	1,214	1,008	1,100	1,722	324
STANDARD ACCESSIBLE SPACES*	12' x 18' - 14' x 18'	22	6	2	2	1	1	2	17	4	8	22	6
VAN ACCESSIBLE SPACES*	16' x 18' - 17' x 18'	5	1	1	1	1	1	1	4	1	2	5	1
TOTAL SPACES		1,769	332	2,343	2,100	100	63	340	1,235	1,013	1,110	1,769	332

* ADA/STATE/LOCAL REQUIREMENTS (MINIMUM)

Mixed Use Area Loading Requirements:

OFFICE:	0 - 10,000 SF	(0)	= 12
	10,001 - 100,000 SF	(1)	
	EACH ADD. 100,000 SF	(1)	
RETAIL:	0 - 5,000 SF	(0)	= 9
	5,001 - 20,000 SF	(1)	
	20,001 - 30,000 SF	(2)	
	30,001 - 50,000 SF	(3)	
	EACH ADD. 50,000 SF	(1)	
RESTAURANT:	0 - 4,000 SF	(0)	= 5
	4,001 - 6,000 SF	(1)	
	6,001 - 10,000 SF	(2)	
	10,001 - 40,000 SF	(3)	
	EACH ADD. 40,000 SF	(1)	
HOTEL:	AS NEEDED		= 1
CINEMA:	AS NEEDED		= 1
TOTAL LOADING REQUIRED			= 28
TOTAL LOADING PROVIDED			= 28

Mixed Use Area Parking Requirements:

OFFICE:	1,750,000 SF x 1 SPACE / 1,000 SF = 1,750
RETAIL:	331,392 SF x 1 SPACE / 1,000 SF = 332
RESTAURANT:	118,258 SF x 1 SPACE / 500 SF = 237
CINEMA:	62,350 SF x 1 SPACE / 1,000 SF = 63
RESIDENTIAL:	2,100 UNITS x 1 SPACE / UNIT = 2,100
HOTEL:	200 GUEST ROOMS x 0.5 SPACES/GUEST ROOM = 100
TOTAL PARKING REQUIRED	= 4,582
TOTAL PARKING PROVIDED	= 7,858

Mixed Use Area Parking Requirements - Assumptions:

1 PARKING SPACE PER DWELLING UNIT (DU)
1 PARKING SPACE PER 1,000 SF OF OFFICE GSF
1 PARKING SPACE PER 1,000 SF OF RETAIL GSF
1 PARKING SPACE PER 500 SF OF RESTAURANT GSF
1 PARKING SPACE PER 1,000 SF OF CINEMA GSF
RESTAURANT SF BASED ON 25% OF TOTAL RETAIL SF
TOTAL PARKING PROVIDED = 7,858
(INCLUDES 160 ON-STREET PARKING SPACES)

* RETAIL AREA MAY BE RE-ALLOCATED TO OFFICE OR RESIDENTIAL USES AT ANY TIME, SO LONG AS ALSO PERMITTED BY NEW OR MODIFIED APPLICABLE ENTITLEMENTS. NO OTHER USE MAY BE COVERED.

RESIDENTIAL AREA MAY BE RE-ALLOCATED TO OFFICE USE AT ANY TIME, SO LONG AS PERMITTED BY NEW OR MODIFIED ENTITLEMENTS; AND

UP TO 400,000 SQUARE FEET OF THE NON-RESIDENTIAL USES (I.E., OFFICE, RETAIL, AND HOSPITALITY) MAY BE RE-ALLOCATED TO RESIDENTIAL USE, BUT NO SOONER THAN 10 YEARS FROM THE DATE THE PUD PLAN IS APPROVED, SO LONG AS PERMITTED BY NEW OR MODIFIED APPLICABLE ENTITLEMENTS.

IKEA Parking Requirements:

RETAIL:	340,000 SF x 1 SPACE / 1,000 SF = 340
TOTAL PARKING REQUIRED	= 340
TOTAL PARKING PROVIDED	= 1,287

Mail Parking Requirements:


RETAIL (ZONING):	340,000 SF x 1 SPACE / 1,000 SF = 340
BLOCK 10 (MAX. ZONING):	4,500 SF x 1 SPACE / 500 SF = 9
RETAIL (LEASE):	326,806 SF x 1 SPACE / 1,000 SF = 1,059
MAXIMUM PARKING REQUIRED (ZONING/LEASE):	= 1,068
TOTAL PARKING PROVIDED	= 1,123

Zoning Summary Chart

Zoning District(s): Assembly Square Mixed-Use District (ASMD)
Overlay District(s): Planned Unit Development Overlay District A (PUD-A), Waterfront Overlay District

Zoning Regulation Requirements	Required	Provided
MAX. LOT AREA	20,000 SF	56.2± AC
FRONT YARD SETBACK	NO MINIMUM	0 FT
SIDE YARD SETBACK	NO MINIMUM	0 FT
REAR YARD SETBACK	NO MINIMUM	0 FT
MAX. FLOOR AREA RATIO	10.0	2.3
MAX. BUILDING HEIGHT	150' OF MYSTIC RIVER BANK	NONE
	BETWEEN 150' AND 250'	70 FT
	BETWEEN 250' AND 300'	80 FT
	WITHIN 1,000' OF MBTA ENTRANCE	250 FT
ALL OTHER LOCATIONS	150 FT	40 FT
TOTAL OPEN SPACE	25%	26.3%
USABLE OPEN SPACE	15.5%	18.0%

* BLOCK 2 HEIGHT ALLOWED UP TO 90 FT (PER 21006-55/567-2010)

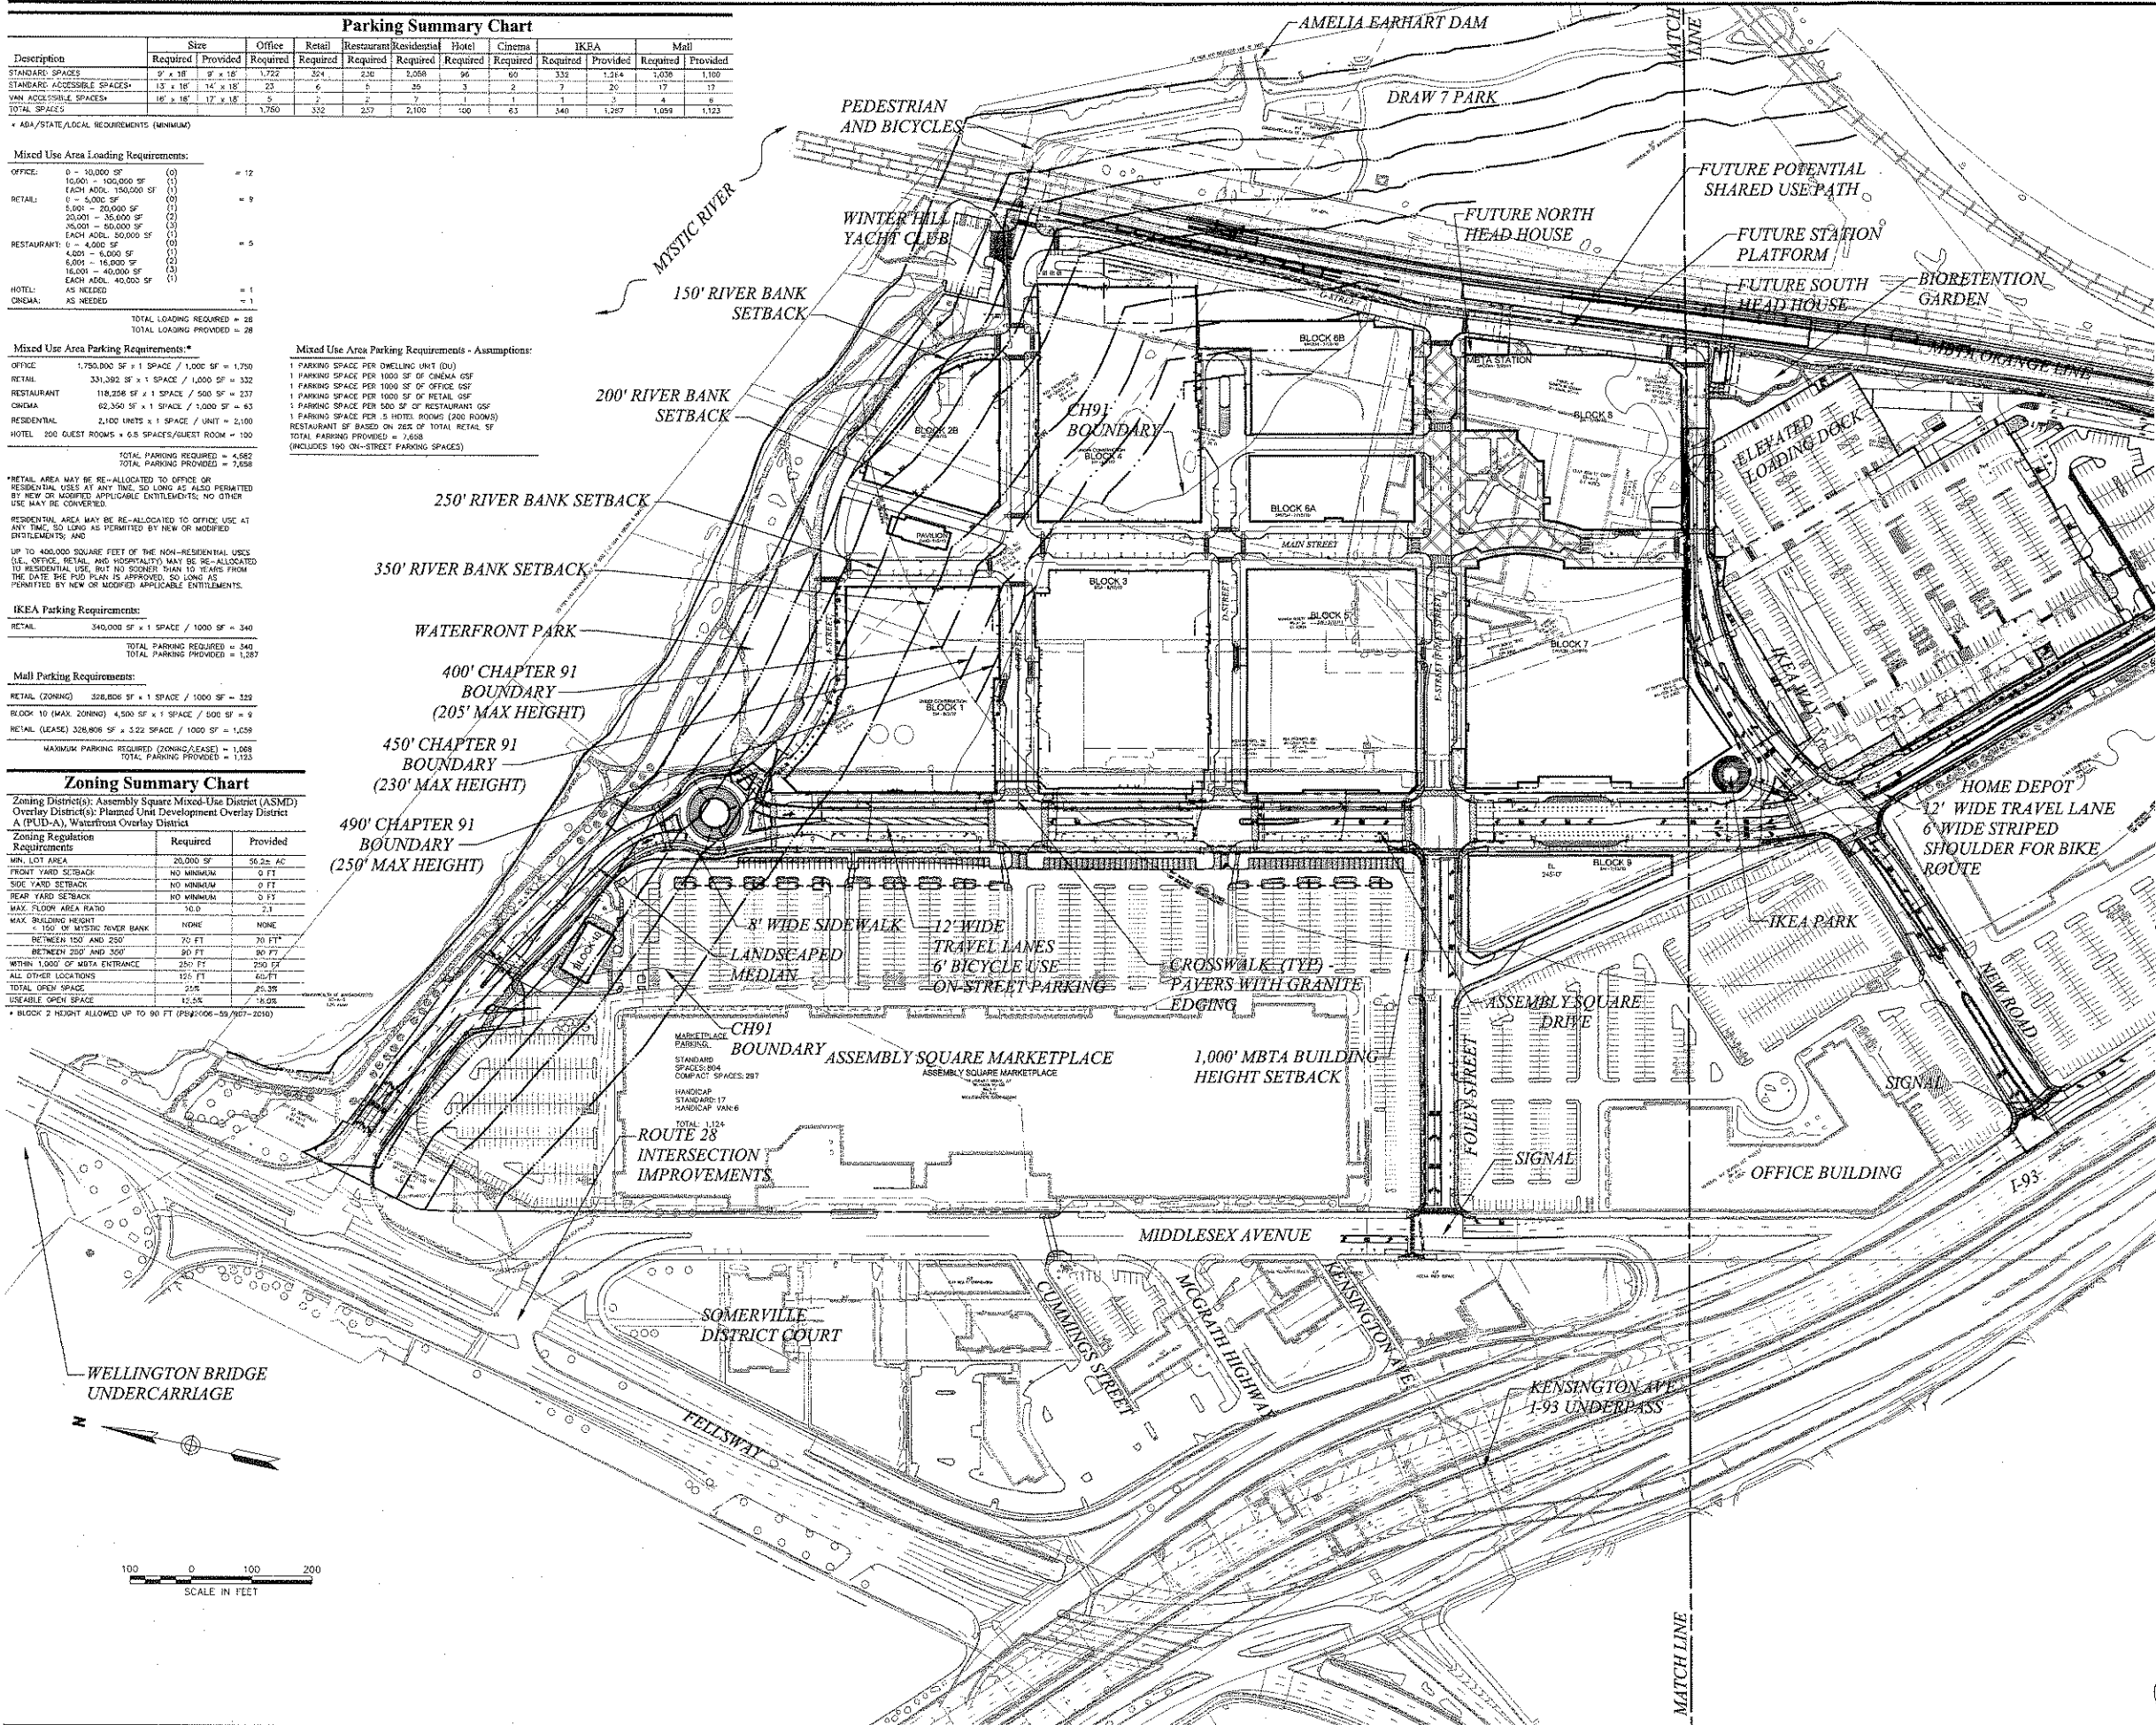

VHB
Vanasse Hangen Brustlin, Inc.
Transportation
Lead Development
Environmental Services
101 Walnut Street, P.O. Box 9151
Watertown, Massachusetts 02471
617.924.1770 • FAX 617.924.2286

Designed by	Drawn by	Checked by
CSO checked by	Approved by	
Scale 1"=100'	Date January 22, 2013	
Project Name		

Assembly Square
Block 2A
Pavilion
Assembly Square Drive
Somerville, Massachusetts
02144

Final Level PUD Approval -
Final Submission
Not Approved for Construction
Issued Date

Overall Site Plan 1


Sheet 5 of 9
Project Number 08518.05
Date 1/22/13
C-4



Vanasse Hangen Brustlin, Inc.

Transportation
Land Development
Environmental Services

101 Walnut Street, P.O. Box 9151
Watertown, Massachusetts 02471
617.924.1770 • FAX 617.924.2286

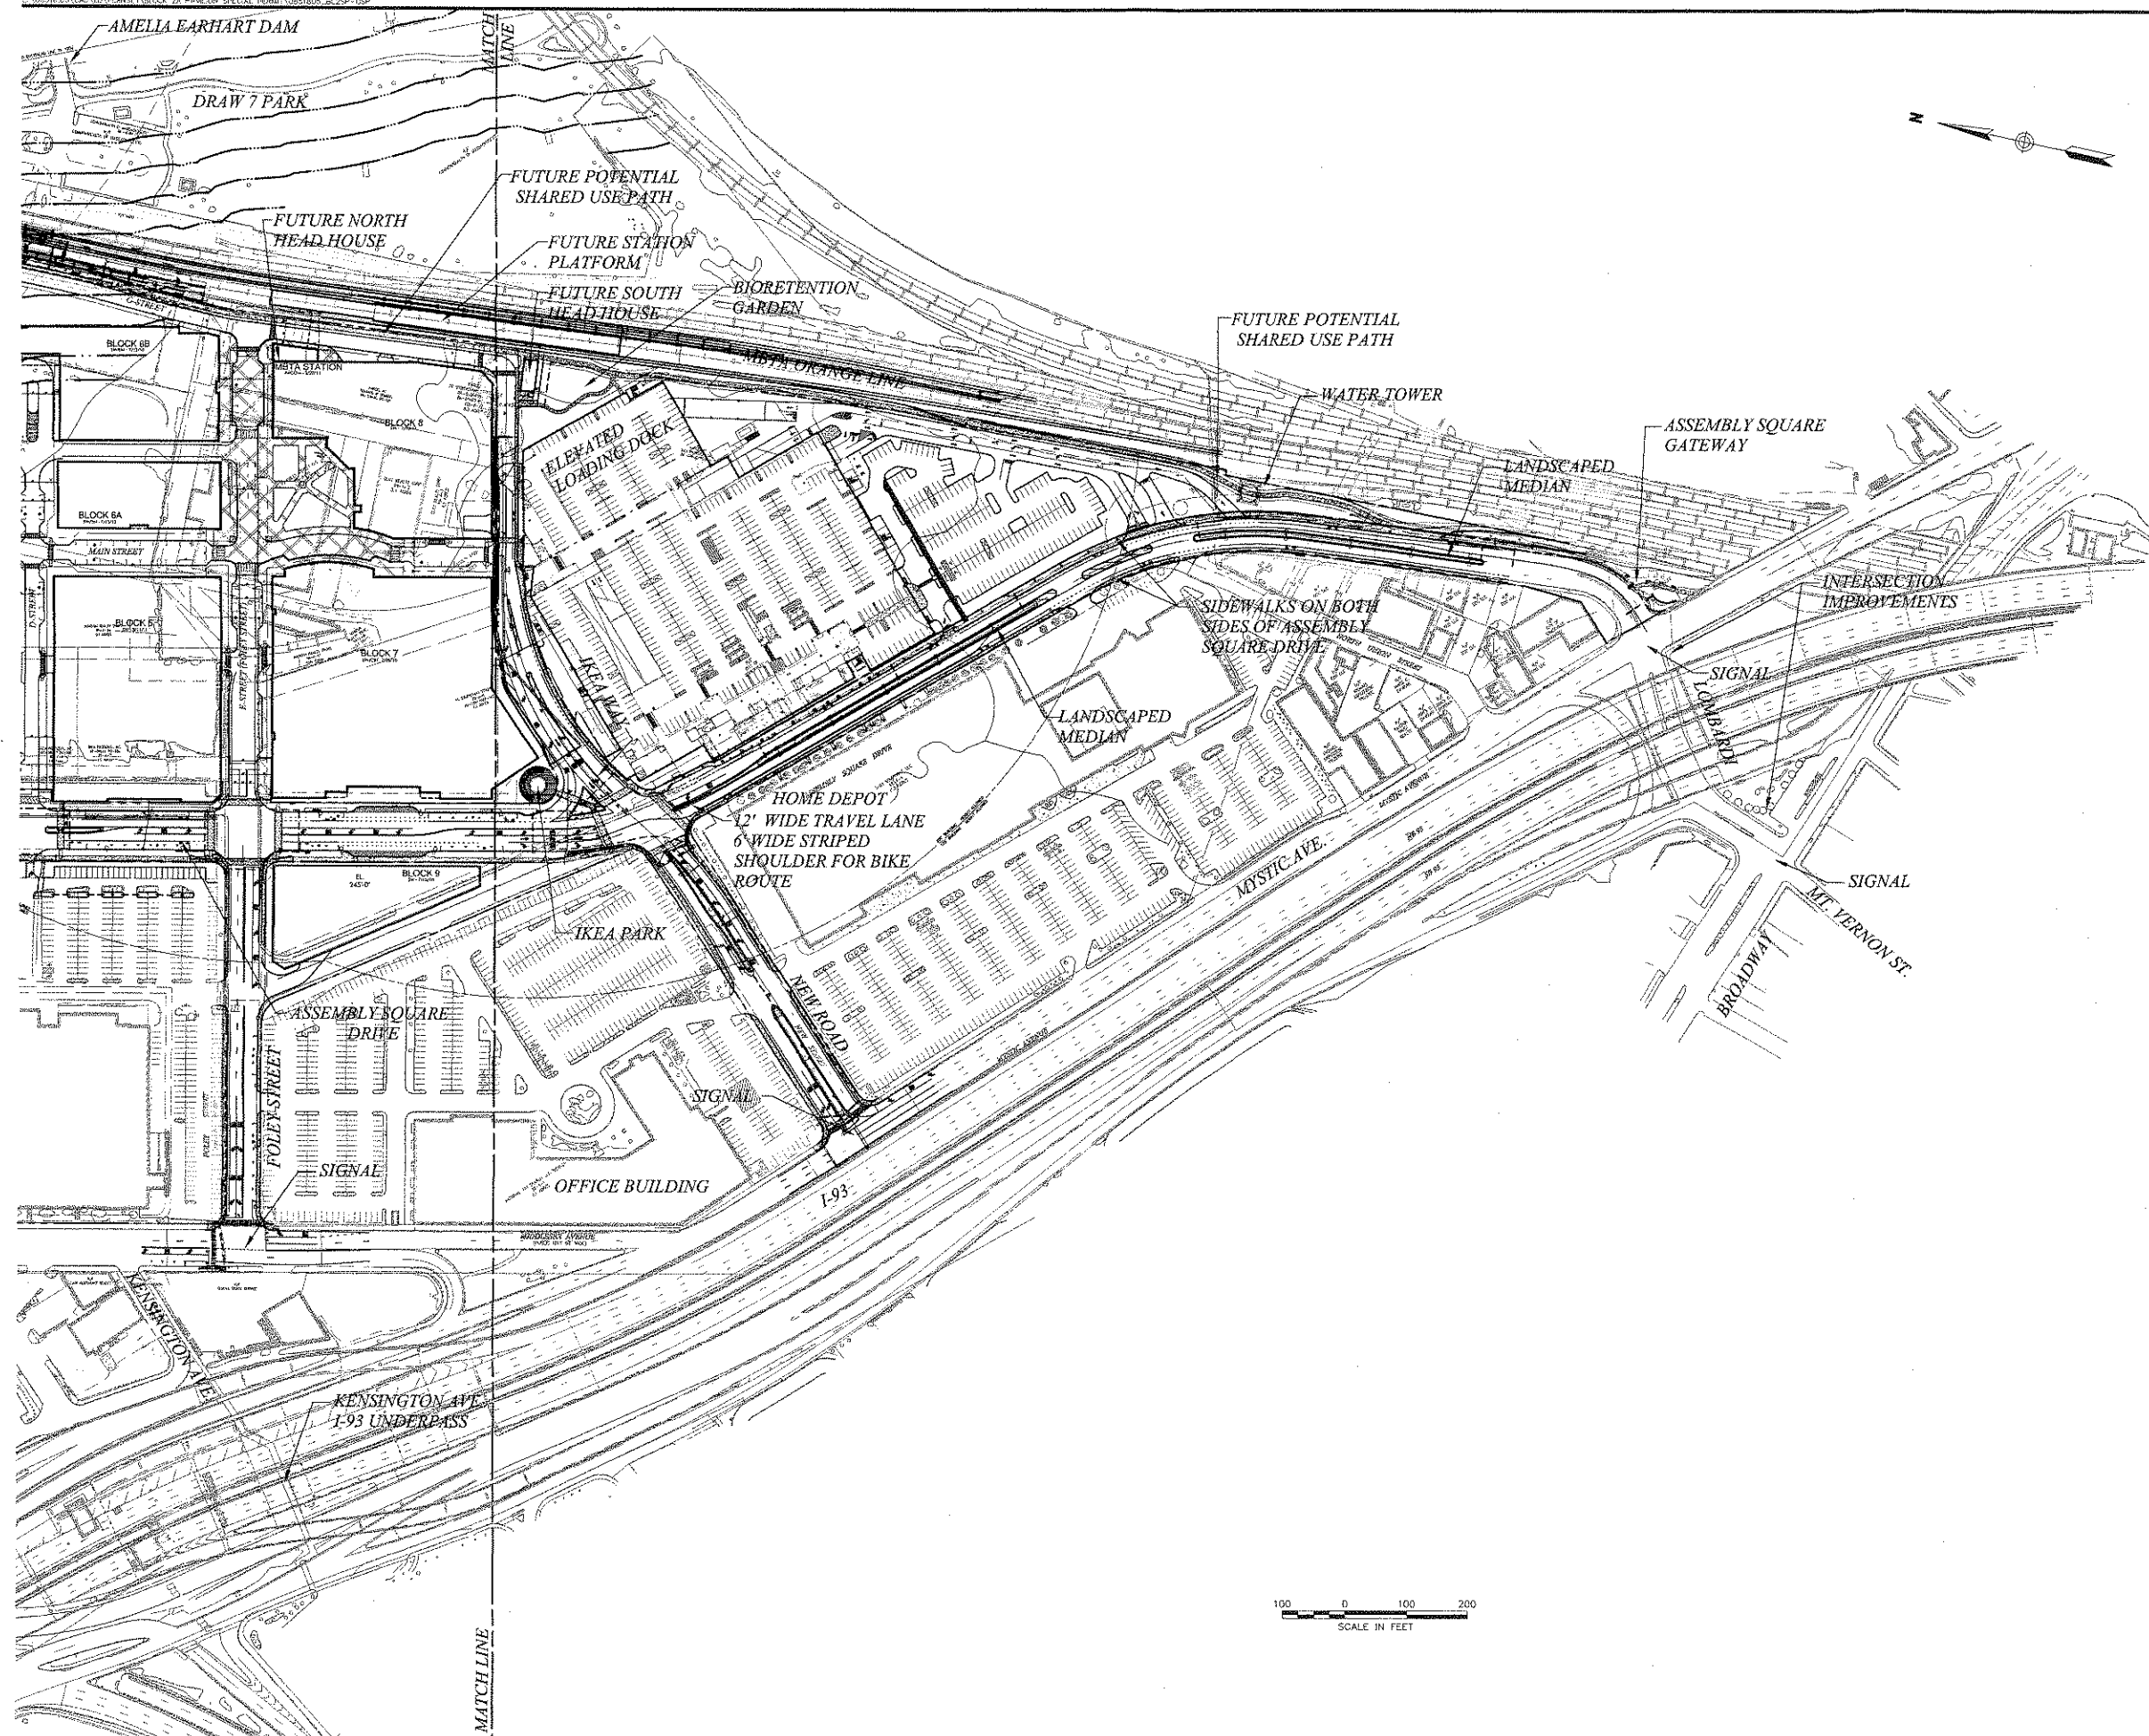

No.	Revolvs	Date
Prepared by	Checked by	Entered by
CAD checked by		Approved by
Scale 1"=100'	Date	January 22, 2011

Final Level PUD Approval -
Final Submission
Not Approved for Construction

Overall Site Plan 2





C-5

Street at

Project Number
09E1R-06

OS31803 6L25P-05C-D10

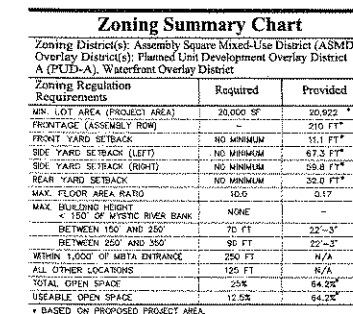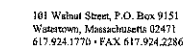


<u>Parking Requirements</u>	
RESTAURANTS	1 SPACE/ 500 SQ. FT.
PARKING REQUIRED	(3,000 SF > 1 SPACE/ 500 SQ. FT.)
<u>Bicycle Parking Requirements</u>	
NON-RESIDENTIAL	FROM 4 TO 14 PARKING SPACES REQUIRED =
PARKING REQUIRED	(1/4 SPACE/ 5 > 1 SPACE/ 10 RES. SPACES =



No.	Reason	Cost
Quoted by	Drawn by	Checked by
CAD checked by	Approved by	
Scale 1:100	Date January 22, 20	

Assembly Square
Block 2A
Pavilion
Assembly Square Drive
Somerville, Massachusetts

Final Level PUD Approval -
Final Submission
Not Approved for Construction


Layout and Materials Plan

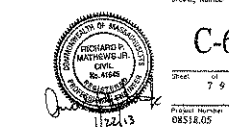

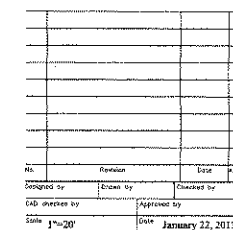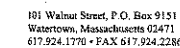


**Assembly Square
Block 2A
Pavilion**
Assembly Square Drive
Somerville, Massachusetts

Final Level PUD Approval -
Final Submission
Not Approved for Construction

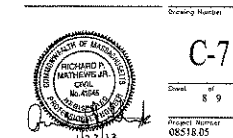Grading,
Drainage and
Erosion Control Plan



101 Walnut Street, P.O. Box 9151
Watertown, Massachusetts 02471
617.924.1770 • FAX 617.924.2286

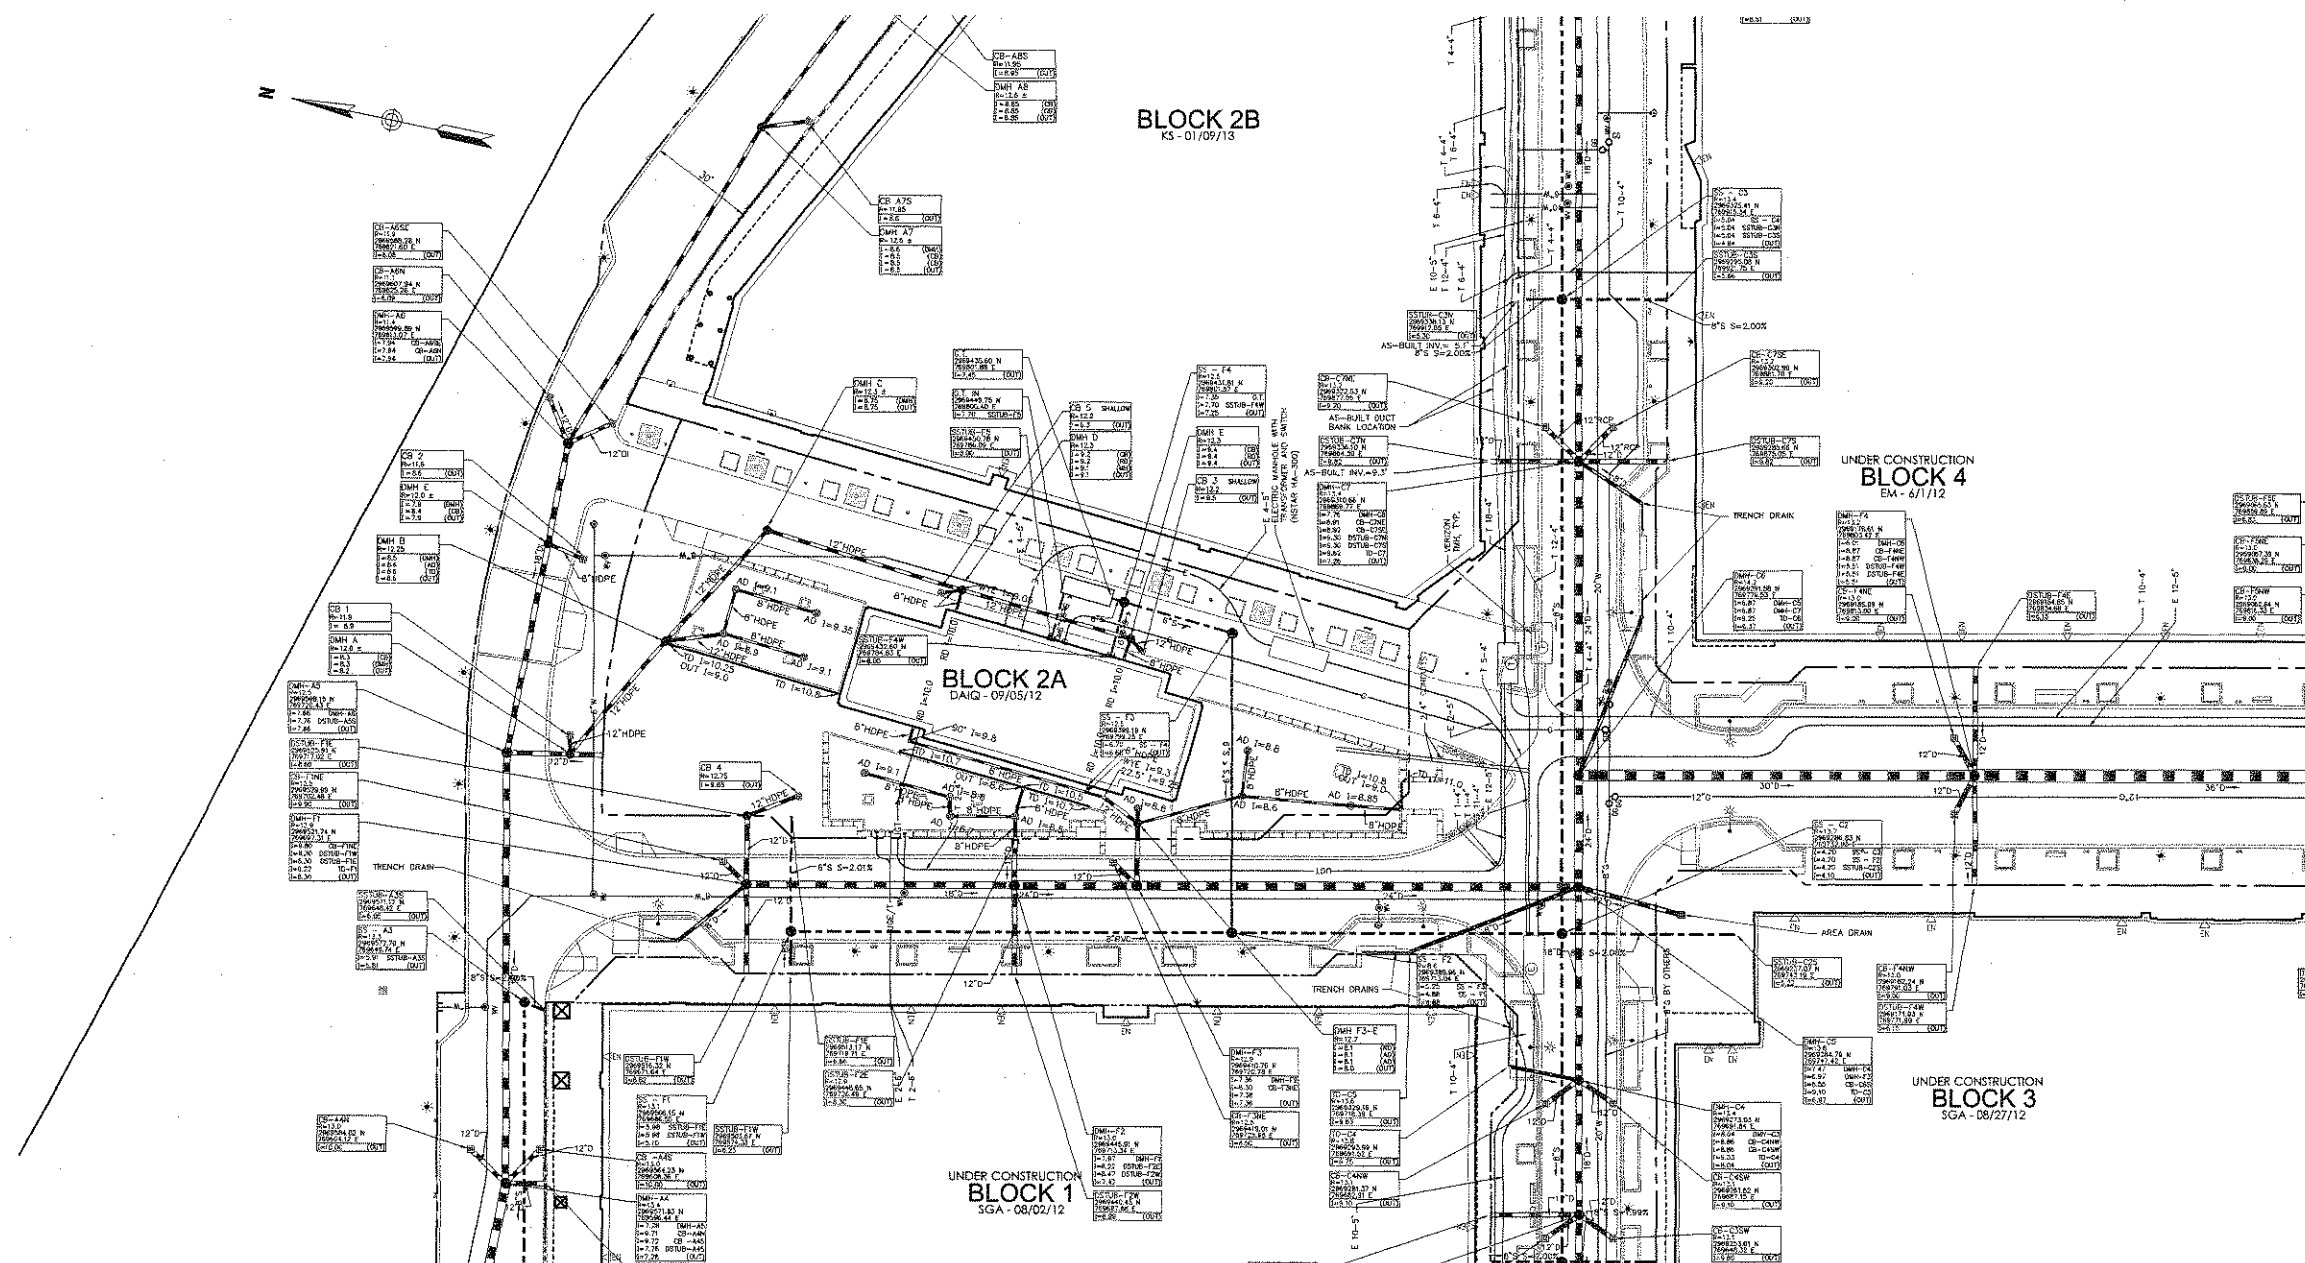


**Assembly Square
Block 2A
Pavilion**
Assembly Square Drive
Somerville, Massachusetts

Utility Plan



99

Project No. 08518.0

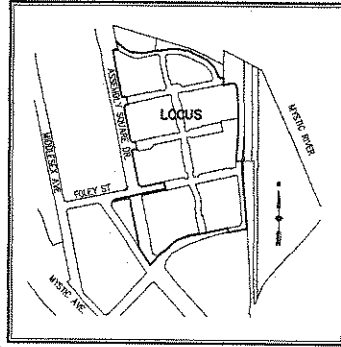


Locus Map
(NOT TO SCALE)



Vanasse Hangen Brustlin, Inc.

Transportation
Land Development
Environmental Services

101 Walnut Street, P.O. Box 9151
Watertown, Massachusetts 02471-9151
617 924 1770 • FAX 617 924 2286

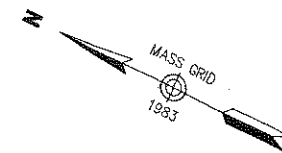

Legend

- ⊕ DRAIN MANHOLE
- ⊕ CATCH BASIN
- ⊕ SEWER MANHOLE
- ⊕ ELECTRIC MANHOLE
- ⊕ TELEPHONE MANHOLE
- ⊕ MANHOLE
- ⊕ HAND HOLE
- ⊕ WATER GATE
- ⊕ FIRE HYDRANT
- ⊕ GAS GATE
- ⊕ STREET SIGN
- ⊕ LIGHT POLE
- ⊕ UTILITY POLE
- ⊕ GUY POLE
- ⊕ GUY WIRE
- ⊕ MONITORING WELL
- ⊕ FLOOD LIGHT
- ⊕ WELL
- NO COULD NOT OPEN
- NPV NO PIPES VISIBLE

- F.F.E.=45.27' FINISHED FLOOR ELEVATION
- 100' BUFFER ZONE
- 100' RIVER FRONT AREA
- 200' RIVER FRONT AREA
- LIMIT MEAN ANNUAL HIGH WATER
- LIMIT OF BANK
- VEGETATED WETLAND BOUNDARY



Assembly Row
Assembly Square
PUD
Somerville, Massachusetts

Utility As-Built

Key Sheet



Sv-1

Sheet 1 of 13
Project Number 11763.08

Legend

- | | |
|--|---------------------------------------|
| | DRAIN MANHOLE |
| | CATCH BASIN |
| | SEWER MANHOLE |
| | ELECTRIC MANHOLE |
| | TELEPHONE MANHOLE |
| | MANHOLE |
| | HAND HOLE |
| | WATER GATE |
| | FIRE HYDRANT |
| | GAS GATE |
| | STREET SIGN |
| | LIGHT POLE |
| | UTILITY POLE |
| | GUY POLE |
| | GUY WIRE |
| | MONITORING WELL |
| | FLOOD LIGHT |
| | WELL |
| | COULD NOT OPEN |
| | NO PIPES VISIBLE |
| | F.F.E.=45.27 FINISHED FLOOR ELEVATION |
| | EDGE OF PAVEMENT |
| | CONCRETE CURB |
| | VERTICAL GRANITE CURB |
| | SLOPED GRANITE EDGE |
| | BITUMINOUS BERM |
| | BITUMINOUS CURB |
| | GUARD RAIL |
| | CHAIN LINK FENCE |
| | DRAINAGE LINE |
| | SEWER LINE |
| | OVERHEAD WIRE |
| | UNDERGROUND ELECTRIC |
| | TELEPHONE LINE |
| | GAS LINE |
| | WATER LINE |
| | STONE WALL |
| | TREE LINE |
| | 100'-FT BUFFER ZONE |
| | 100'-FT RIVER FRONT AREA |
| | 200'-FT RIVER FRONT AREA |
| | LIMIT MEAN ANNUAL HIGH WATER |
| | LIMIT OF BANK |
| | VEGETATED WETLAND BOUNDARY |

No.	Revision	Date	Appvd.
Designed by	Drawn by	Checked by	
CAD checked by	Approved by		
Scale 1"=40'	Date March 9, 2012		

Assembly Row
Assembly Square
PUD
Somerville, Massachusetts

Utility As-Built

Drawing Title

Utility Asbuilt

General Notes

1. THE PROPERTY LINES SHOWN ON THIS PLAN ARE BASED UPON AN ACTUAL FIELD SURVEY CONDUCTED BY VANASSE HANGEN BRUSTLIN, INC. IN MARCH 2008 AND FROM DEEDS AND PLANS OF RECORD.
2. THE EXISTING CONDITIONS OF WATER, SEWER DRAIN, TELEPHONE AND ELECTRIC DUCT BANKS SHOWN ON THIS PLAN ARE BASED UPON AN ACTUAL ON-THE-GROUND INSTRUMENT SURVEY PERFORMED BY VANASSE HANGEN BRUSTLIN, INC. IN SEPTEMBER THRU DECEMBER OF 2011.
3. THE LOCATIONS OF THE UNDERGROUND UTILITIES SHOWN ON THIS PLAN ARE BASED ON FIELD OBSERVATIONS OF EXPOSED ANGLE POINTS AND PARTIAL INSTALLMENTS DURING CONSTRUCTION. VHB DID NOT OBSERVE ALL LOCATIONS OF UNDERGROUND LINES OR LINES OF SIGHT DURING INSTALLMENT.
4. HORIZONTAL DATUM IS BASED ON NASS. GRID SYSTEM, NAD 1983. ELEVATIONS SHOWN ON THIS PLAN REFER TO NAVD OF 1988.

Drawing Number

Sv-12

Sheet of
12 13

Project number
11763.00



101 Walnut Street, P.O. Box 9151
Watertown, Massachusetts 02471-9151
617 924 1770 • FAX 617 924 2286

Legend

- ① DRAIN MANHOLE
 ② CATCH BASIN
 ③ SEWER MANHOLE
 ④ ELECTRIC MANHOLE
 ⑤ TELEPHONE MANHOLE
 ⑥ MANHOLE
 HHC ☐ HAND HOLE
 ⑦ WATER GATE
 ⑧ FIRE HYDRANT
 ⑨ GAS GATE
 — STREET SIGN
 ☆ LIGHT POLE
 ☆ UTILITY POLE
 ~ GUY POLE
 ~ GUY WIRE
 ⑩ MONITORING WELL
 ⑪ FLOOD LIGHT
 ⑫ WELL
 CNO COULD NOT OPEN
 NPV NO PIPES VISIBLE

4 F.F.E.=45.27' FINISHED FLOOR ELEVATION

- | SYMBOL | DESCRIPTION |
|--------------------------|------------------------------|
| FINISHED FLOOR ELEVATION | EDGE OF PAVEMENT |
| CONCRETE CURB | VERTICAL GRANITE CURB |
| SLOPED GRANITE CURB | BITUMINOUS BERM |
| BITUMINOUS CURB | GUARD RAIL |
| CHAIN LINK FENCE | DRAINAGE LINE |
| SEWER LINE | OVERHEAD WIRE |
| UNDERGROUND ELECTRIC | TELEPHONE LINE |
| GAS LINE | WATER LINE |
| STONE WALL | TREE LINE |
| 100-FT BUFFER ZONE | 100-FT RIVER FRONT AREA |
| 200-FT RIVER FRONT AREA | DMT NEAR WINDLIFT HIGH WATER |
| DMT NEAR BANK | VEGETATED WINDLIFT BOUNDARY |

[illegible]

No.	Revision	Date
Designed by	Drawn by	Checked by
CAO checked by	Approved by	
Scale 1"=40'	Date March 9, 2012	

Assembly Row
Assembly Square
PUD
Somerville, Massachusetts

Utility As-Built

Drawing Title

Utility Asbuilt

General Notes

1. THE PROPERTY LINES SHOWN ON THIS PLAN ARE BASED UPON AN ACTUAL FIELD SURVEY CONDUCTED BY VANASSE HANGEN BRUSTLIN, INC. IN MARCH 2008 AND FROM DEEDS AND PLANS OF RECORD.
2. THE EXISTING CONDITIONS OF WATER, SEWER DRAIN, TELEPHONE AND ELECTRIC DUCT BANKS SHOWN ON THIS PLAN ARE BASED UPON AN ACTUAL ON-THE-GROUND INSTRUMENT SURVEY PERFORMED BY VANASSE HANGEN BRUSTLIN, INC. IN SEPTEMBER THRU DECEMBER OF 2011.
3. THE LOCATIONS OF THE UNDERGROUND UTILITIES SHOWN ON THIS PLAN ARE BASED ON FIELD OBSERVATIONS OF EXPOSED ANGLE POINTS AND PARTIAL INSTALLMENTS DURING CONSTRUCTION. VHB DID NOT OBSERVE ALL LOCATIONS OF UNDERGROUND LINES OR LINES IF SIGHT DURING INSTALLMENT.
4. HORIZONTAL DATUM IS BASED ON MASS. GRID SYSTEM, NAD 1983. ELEVATIONS SHOWN ON THIS PLAN REFER TO NAVD OF 1988.




Discussion

Sv-13

Sheet of
13 13
Project Number
11763.00

SOMERVILLE
ASSEMBLY ROW - MAIN STREET PLAZA
OVERA SITE PLAN AND GENERAL NOES
L-100

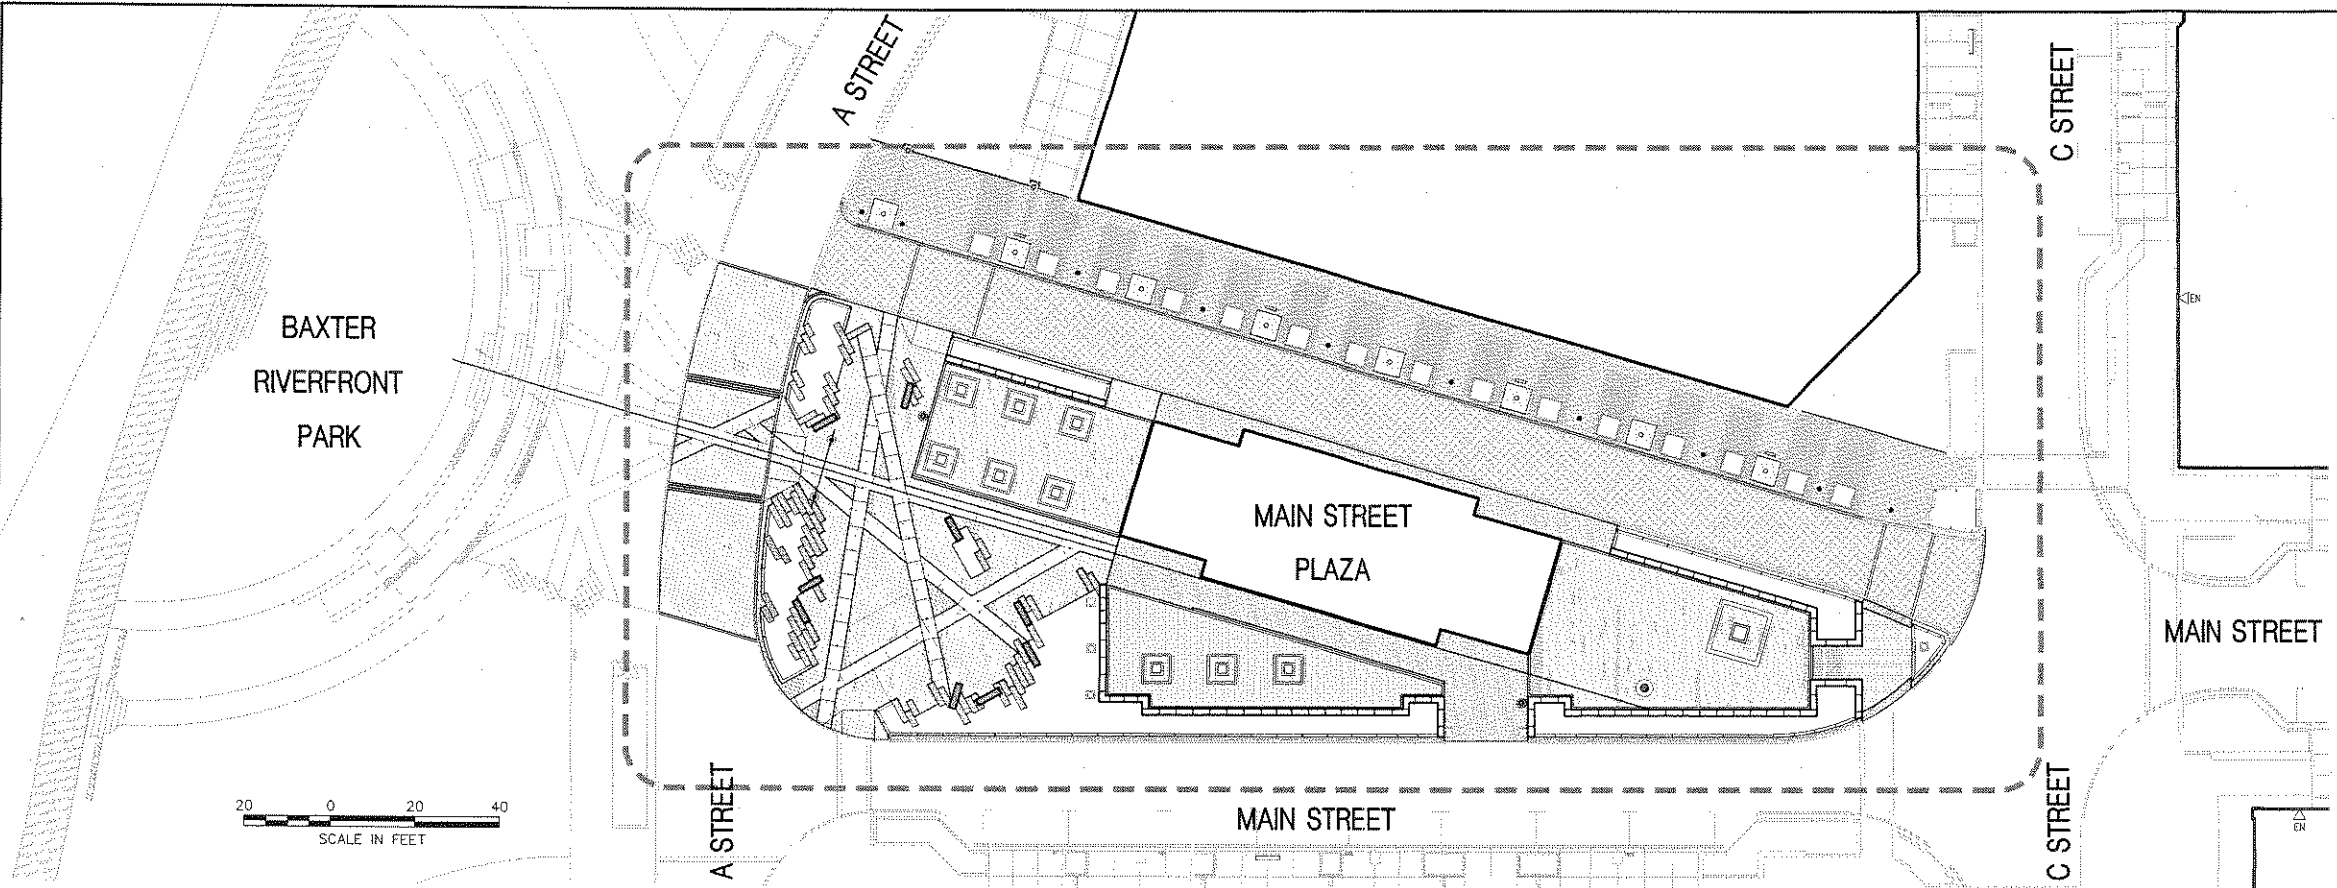

GENERAL NOTES

1. CONTRACTOR SHALL VERIFY ALL EXISTING CONDITIONS AND DIMENSIONS, AND NOTIFY LANDSCAPE ARCHITECT AT ONCE IN WRITING OF ANY DISCREPANCIES BETWEEN THE EXISTING CONDITIONS AS INDICATED ON THE PLAN AND ACTUAL FIELD CONDITIONS AND RECEIVE WRITTEN INSTRUCTIONS PRIOR TO PROCEEDING.
2. CONTRACTOR SHALL BE RESPONSIBLE FOR CHECKING EXISTING GRADES TO VERIFY THEIR ACCURACY.
3. CONTRACTOR SHALL VERIFY ALL UTILITY LOCATIONS AND ELEVATIONS PRIOR TO EXCAVATION. BEFORE CONSTRUCTION STARTS ALL UTILITY COMPANIES, PUBLIC AND PRIVATE MUST BE CONTACTED INCLUDING THOSE IN CONTROL OF UTILITIES NOT SHOWN ON THIS PLAN. CONTACT "LOCAL DIG SAFE" AND REPORT ANY DISCREPANCIES IN WRITING TO LANDSCAPE ARCHITECT AND RECEIVE WRITTEN INSTRUCTIONS PRIOR TO PROCEEDING.
4. THE CONTRACTOR SHALL ESTABLISH PERMANENT BENCH MARKS. MAINTAIN ALL ESTABLISHED BOUNDS AND BENCH MARKS AND REPLACE AS DIRECTED ANY WHICH ARE DESTROYED OR DISTURBED.
5. CONTRACTOR IS RESPONSIBLE FOR ALL DAMAGE DUE TO OPERATIONS OUTSIDE OF THE CONSTRUCTION LIMIT LINE. CONTRACTOR SHALL MEET LINE AND GRADE OF EXISTING CONDITIONS AT THE CONSTRUCTION LIMIT LINE. SEE SPECIFICATIONS FOR REQUIREMENTS REGARDING THE MAINTENANCE AND PROTECTION OF EXISTING UTILITIES INSIDE AND OUTSIDE THE CONTRACT LIMIT LINE. CONTRACTOR IS RESPONSIBLE FOR ALL DAMAGE DUE TO OPERATIONS INSIDE AND OUTSIDE OF THE CONSTRUCTION LIMIT LINE.
6. PROVIDE EXPANSION JOINTS IN BASE SLABS, AT ALL BUILDINGS, CURBS, WALLS, LIGHT POLE BASES, PULL BOXES, MANHOLES, TRAFFIC CONTROLLER BOXES AND/OR AS SHOWN ON THE DRAWINGS.
7. PROVIDE TREE PROTECTION FENCING AT AROUND ALL TREES TO REMAIN. CONTRACTOR SHALL MEET WITH LANDSCAPE ARCHITECT PRIOR TO REMOVING TREES WITHIN CONSTRUCTION LIMIT LINE.

LAYOUT NOTES

1. CONSULT ALL DRAWINGS AND SPECIFICATIONS FOR COORDINATION REQUIREMENTS BETWEEN ALL TRADES PRIOR TO COMMENCING NEW CONSTRUCTION.
2. CONTRACTOR SHALL VERIFY ALL CONDITIONS IN THE FIELD AND REPORT ANY AND ALL DISCREPANCIES TO THE OWNER'S REPRESENTATIVE. ANY ALTERATIONS TO THESE DRAWINGS MADE IN THE FIELD SHALL BE PROMPTLY REPORTED BY THE CONTRACTOR TO THE OWNER'S REPRESENTATIVE AND RECORDED ON DRAWINGS.
3. CONTRACTOR SHALL NOTIFY OWNER'S REPRESENTATIVE IMMEDIATELY OF ANY AND ALL CONFLICTS BETWEEN PROPOSED PLAYGROUND AND WORK OF ALL OTHER TRADES.
4. EXPANSION JOINTS AT ALL VERTICAL INTERFACES, CHANGES OF MATERIALS, CONCRETE COLORS, EVERY 20' O.C., AND AS SHOWN ON THE DRAWINGS.

GRADING NOTES

1. CONSULT ALL DRAWINGS AND SPECIFICATIONS FOR COORDINATION REQUIREMENTS BETWEEN ALL TRADES BEFORE COMMENCING NEW CONSTRUCTION. CONTRACTOR SHALL NOTIFY OWNER'S REPRESENTATIVE IMMEDIATELY OF ANY AND ALL CONFLICTS BETWEEN PROPOSED SITE WORK AND WORK OF ALL OTHER TRADES.
2. CONTRACTOR SHALL VERIFY ALL CONDITIONS IN THE FIELD AND REPORT ANY DISCREPANCIES TO THE OWNER'S REPRESENTATIVE PRIOR TO COMMENCING WORK. ANY ALTERATIONS TO THESE DRAWINGS MADE IN THE FIELD SHALL BE PROMPTLY REPORTED BY THE CONTRACTOR TO THE OWNER'S REPRESENTATIVE FOR REVIEW AND APPROVAL AND RECORDED ON RECORD DRAWINGS.
3. CONTRACTOR SHALL BE RESPONSIBLE FOR REPAIRING DAMAGE INSIDE AND OUTSIDE THE LIMIT OF WORK LINE DUE TO CONTRACT OPERATIONS. CONTRACTOR SHALL RESTORE DAMAGED AREAS BEYOND CONTRACT LIMITS TO THEIR ORIGINAL CONDITION AT NO ADDITIONAL COST TO THE OWNER.
4. LOCATION OF EXISTING ABOVEGROUND AND UNDERGROUND UTILITIES SHOWN ON THIS PLAN ARE DIAGRAMMATIC ONLY AND DO NOT REPRESENT ACCURATE LOCATIONS. THE CONTRACTOR SHALL CONTACT THE CITY OF METHUEN AND DIGSAFE TO CONFIRM THE LOCATIONS OF ALL EXISTING UTILITIES BEFORE COMMENCING WORK. ANY DAMAGE DUE TO THE FAILURE OF THE CONTRACTOR TO CONTACT AUTHORITIES SHALL BE BORN BY THE CONTRACTOR. THE CONTRACTOR SHALL REPAIR ANY DAMAGE INCURRED DURING CONSTRUCTION TO EXISTING UTILITIES SCHEDULED TO REMAIN AT NO COST TO THE OWNER.
5. PITCH EVENLY BETWEEN SPOT GRADES. ALL PAVING AREAS MUST PITCH TO DRAIN AT MIN. PITCH OF 1/8" PER FOOT UNLESS OTHERWISE SHOWN. REPORT ANY DISCREPANCIES BETWEEN EXISTING AND PROPOSED SPOT GRADES THAT DO NOT PITCH ACCORDINGLY TO THE OWNER'S REPRESENTATIVE BEFORE COMMENCING WORK.
6. WHERE NEW PAVING MEETS EXISTING PAVING, MEET LINE AND GRADE OF EXISTING SMOOTHLY WITH NEW CONSTRUCTION.
7. EXCAVATION ADJACENT TO EXISTING AND PROPOSED UTILITY LINES AND EXISTING TREES SHALL BE DONE BY HAND. CONTRACTOR SHALL PROTECT ALL EXPOSED UTILITIES.
8. CONTRACTOR SHALL PROTECT EXISTING UTILITIES, EXISTING STRUCTURES, IMPROVEMENTS, APPURTENANCES AND VEGETATION TO REMAIN. CONTRACTOR SHALL REPAIR ANY DAMAGE INCURRED AT NO COST TO OWNER.
9. CONTRACTOR SHALL COMPLY WITH ALL REQUIREMENTS OF PERMITS AND LICENSEES ISSUED BY THE FEDERAL, STATE AND LOCAL AGENCIES.
9. CONTRACTOR SHALL COORDINATE ALL SITE UTILITY IMPROVEMENTS WITH THE PROPER AUTHORITIES.
10. MAINTAIN A MAXIMUM OF 2.0% CROSS SLOPE ON ALL PAVED PATHWAYS, UNLESS OTHERWISE NOTED.
11. ALL MANHOLES, DRAINAGE STRUCTURES, STEAM MANHOLES, ELECTRIC MANHOLE FRAMES AND COVERS WITHIN THE PROJECT WORK AREA SHALL BE ADJUSTED TO FINISH GRADES UNLESS OTHERWISE NOTED.


DRAWING LIST

L-100	COVER SHEET
LM-101	MATERIALS PLAN
LM-102	SITE FURNITURE PLAN
LM-401	MATERIALS ENLARGEMENT PLANS
LS-101	SITE LAYOUT PLAN
LS-401	LAYOUT ENLARGEMENT PLANS
LS-402	LAYOUT ENLARGEMENT PLANS
LG-101	GRADING PLAN
LP-101	PLANTING PLAN
LP-501	PLANTING NOTES AND SCHEDULE
LS-501	SITE DETAILS
LS-502	SITE DETAILS
LS-503	SITE DETAILS
LS-504	SITE DETAILS
IR-93	IRRIGATION PLAN
IR-94	IRRIGATION SLEEVING PLAN
IR-95	IRRIGATION DETAILS
IR-96	IRRIGATION DETAILS

SOMERVILLE
ASSEMBLY ROW - MAIN STREET PLAZA
MATERIALS PLAN
LM-101

MATERIALS LEGEND

UNIT PAVER, TYPE (1)	SALVAGED GRANITE CURB, SET FLUSH WITH GRADE	DROP INLET AT PLANTED AREA	III(C)
UNIT PAVER, TYPE (2)	SALVAGED GRANITE CURB, SET AT HEIGHT OF ADJACENT PLANTER CURB	TRENCH DRAIN, CHANNEL/BASIN BY CIVIL ENGINEER	III(C)
VEHICULAR DEPTH TYPE (2A)	RAISED GRANITE SEATING PLINTH	LIGHT FIXTURE TYPE X-1	III(C)
UNIT PAVER, TYPE (3)	REQUIRED LOCATION FOR EXPANSION JOINT	LIGHT FIXTURE TYPE X-2	III(C)
UNIT PAVER, TYPE (4)	TREE PIT BELOW WOOD DECKING	LIGHT FIXTURE TYPE X-4	III(C)
CONCRETE PAVING,	MOVABLE PLANTER	LIGHT FIXTURE TYPE X-7	III(C)
WOOD DECKING	TREE GRATE	LIGHT FIXTURE TYPE X-8	III(C)
P.I.P. CONCRETE RETAINING/SEATWALL	BOLLARD	LIGHT FIXTURE TYPE X-9	III(C)
GRANITE PLANTER CURB	BIKE RACK	LIGHT FIXTURE TYPE X-10	III(C)
PLANTED AREA	TRASH RECEPTACLE	LIGHT FIXTURE TYPE X-19	III(C)
	DROP INLET BELOW WOOD DECKING	LIGHT FIXTURE TYPE X-19A	III(C)
	DROP INLET AT SURFACE		III(C)
		REFER TO SPECIFICATION SECTION 26.51.13 FOR LIGHT FIXTURE INFORMATION	

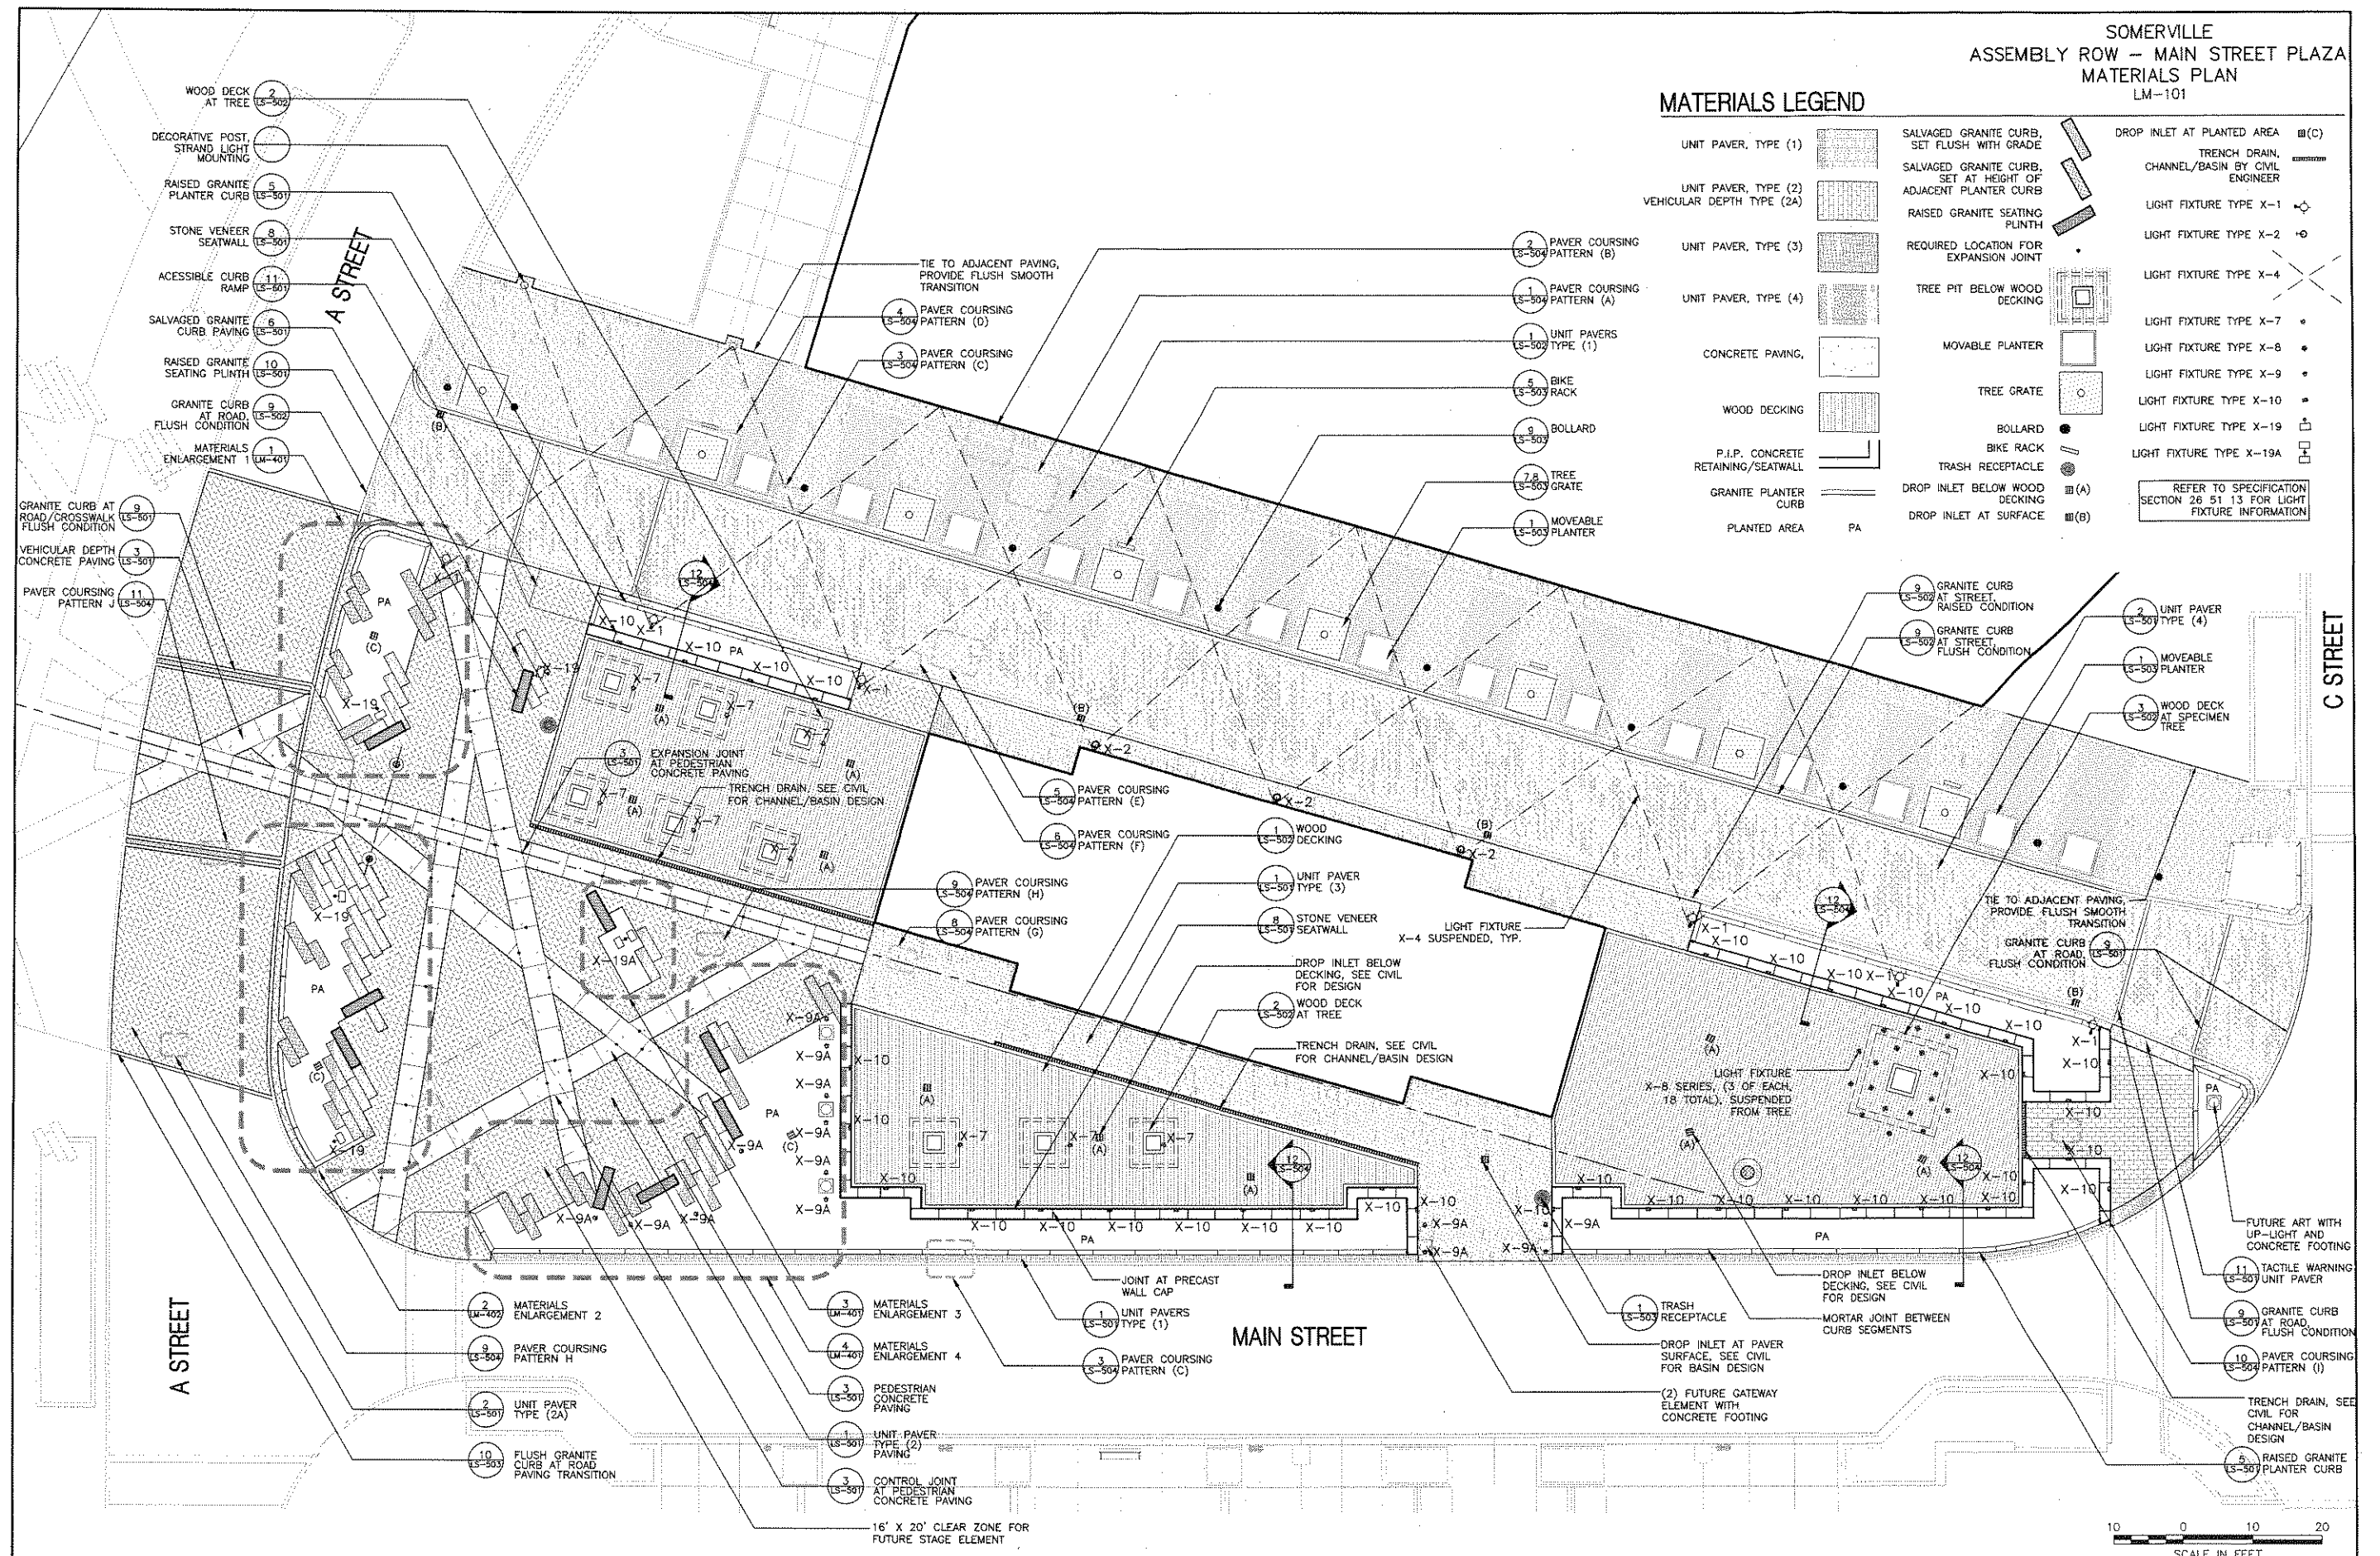


10 0 10 20
SCALE IN FEET

Sheet Worksheet: May 09, 2012 11:06:37 AM BOLLER Plotted Wednesday, May 09, 2012 3:36:53 PM Brett Oliver


SOMERVILLE
ASSEMBLY ROW - MAIN STREET PLAZA
SITE FURNITURE PLAN
LM-102

SITE FURNITURE LEGEND


- | | | | |
|-----------------------------------|--|------------------------------|--|
| (3) ALUMINUM, LOW GARDEN TABLE | | (5) WOOD, TABLE 48" ROUND | |
| (9) ALUMINUM, LOW TABLE FOOT REST | | (8) WOOD, TABLE 39" ROUND | |
| (9) STEEL, 30" BISTRO TABLE | | (22) WOOD, SIDE TABLE | |
| (18) ALUMINUM CHAIR | | (7) WOOD, COCKTAIL TABLE | |
| (12) ALUMINUM CHAIR, WITH ARMREST | | (7) WICKER FIBER SOFA | |
| (30) STEEL BISTRO CHAIR | | (20) WOOD CHAIR | |
| | | (32) WOOD CHAIR WITH ARMREST | |
| | | (44) WOOD LOUNGE CHAIR | |

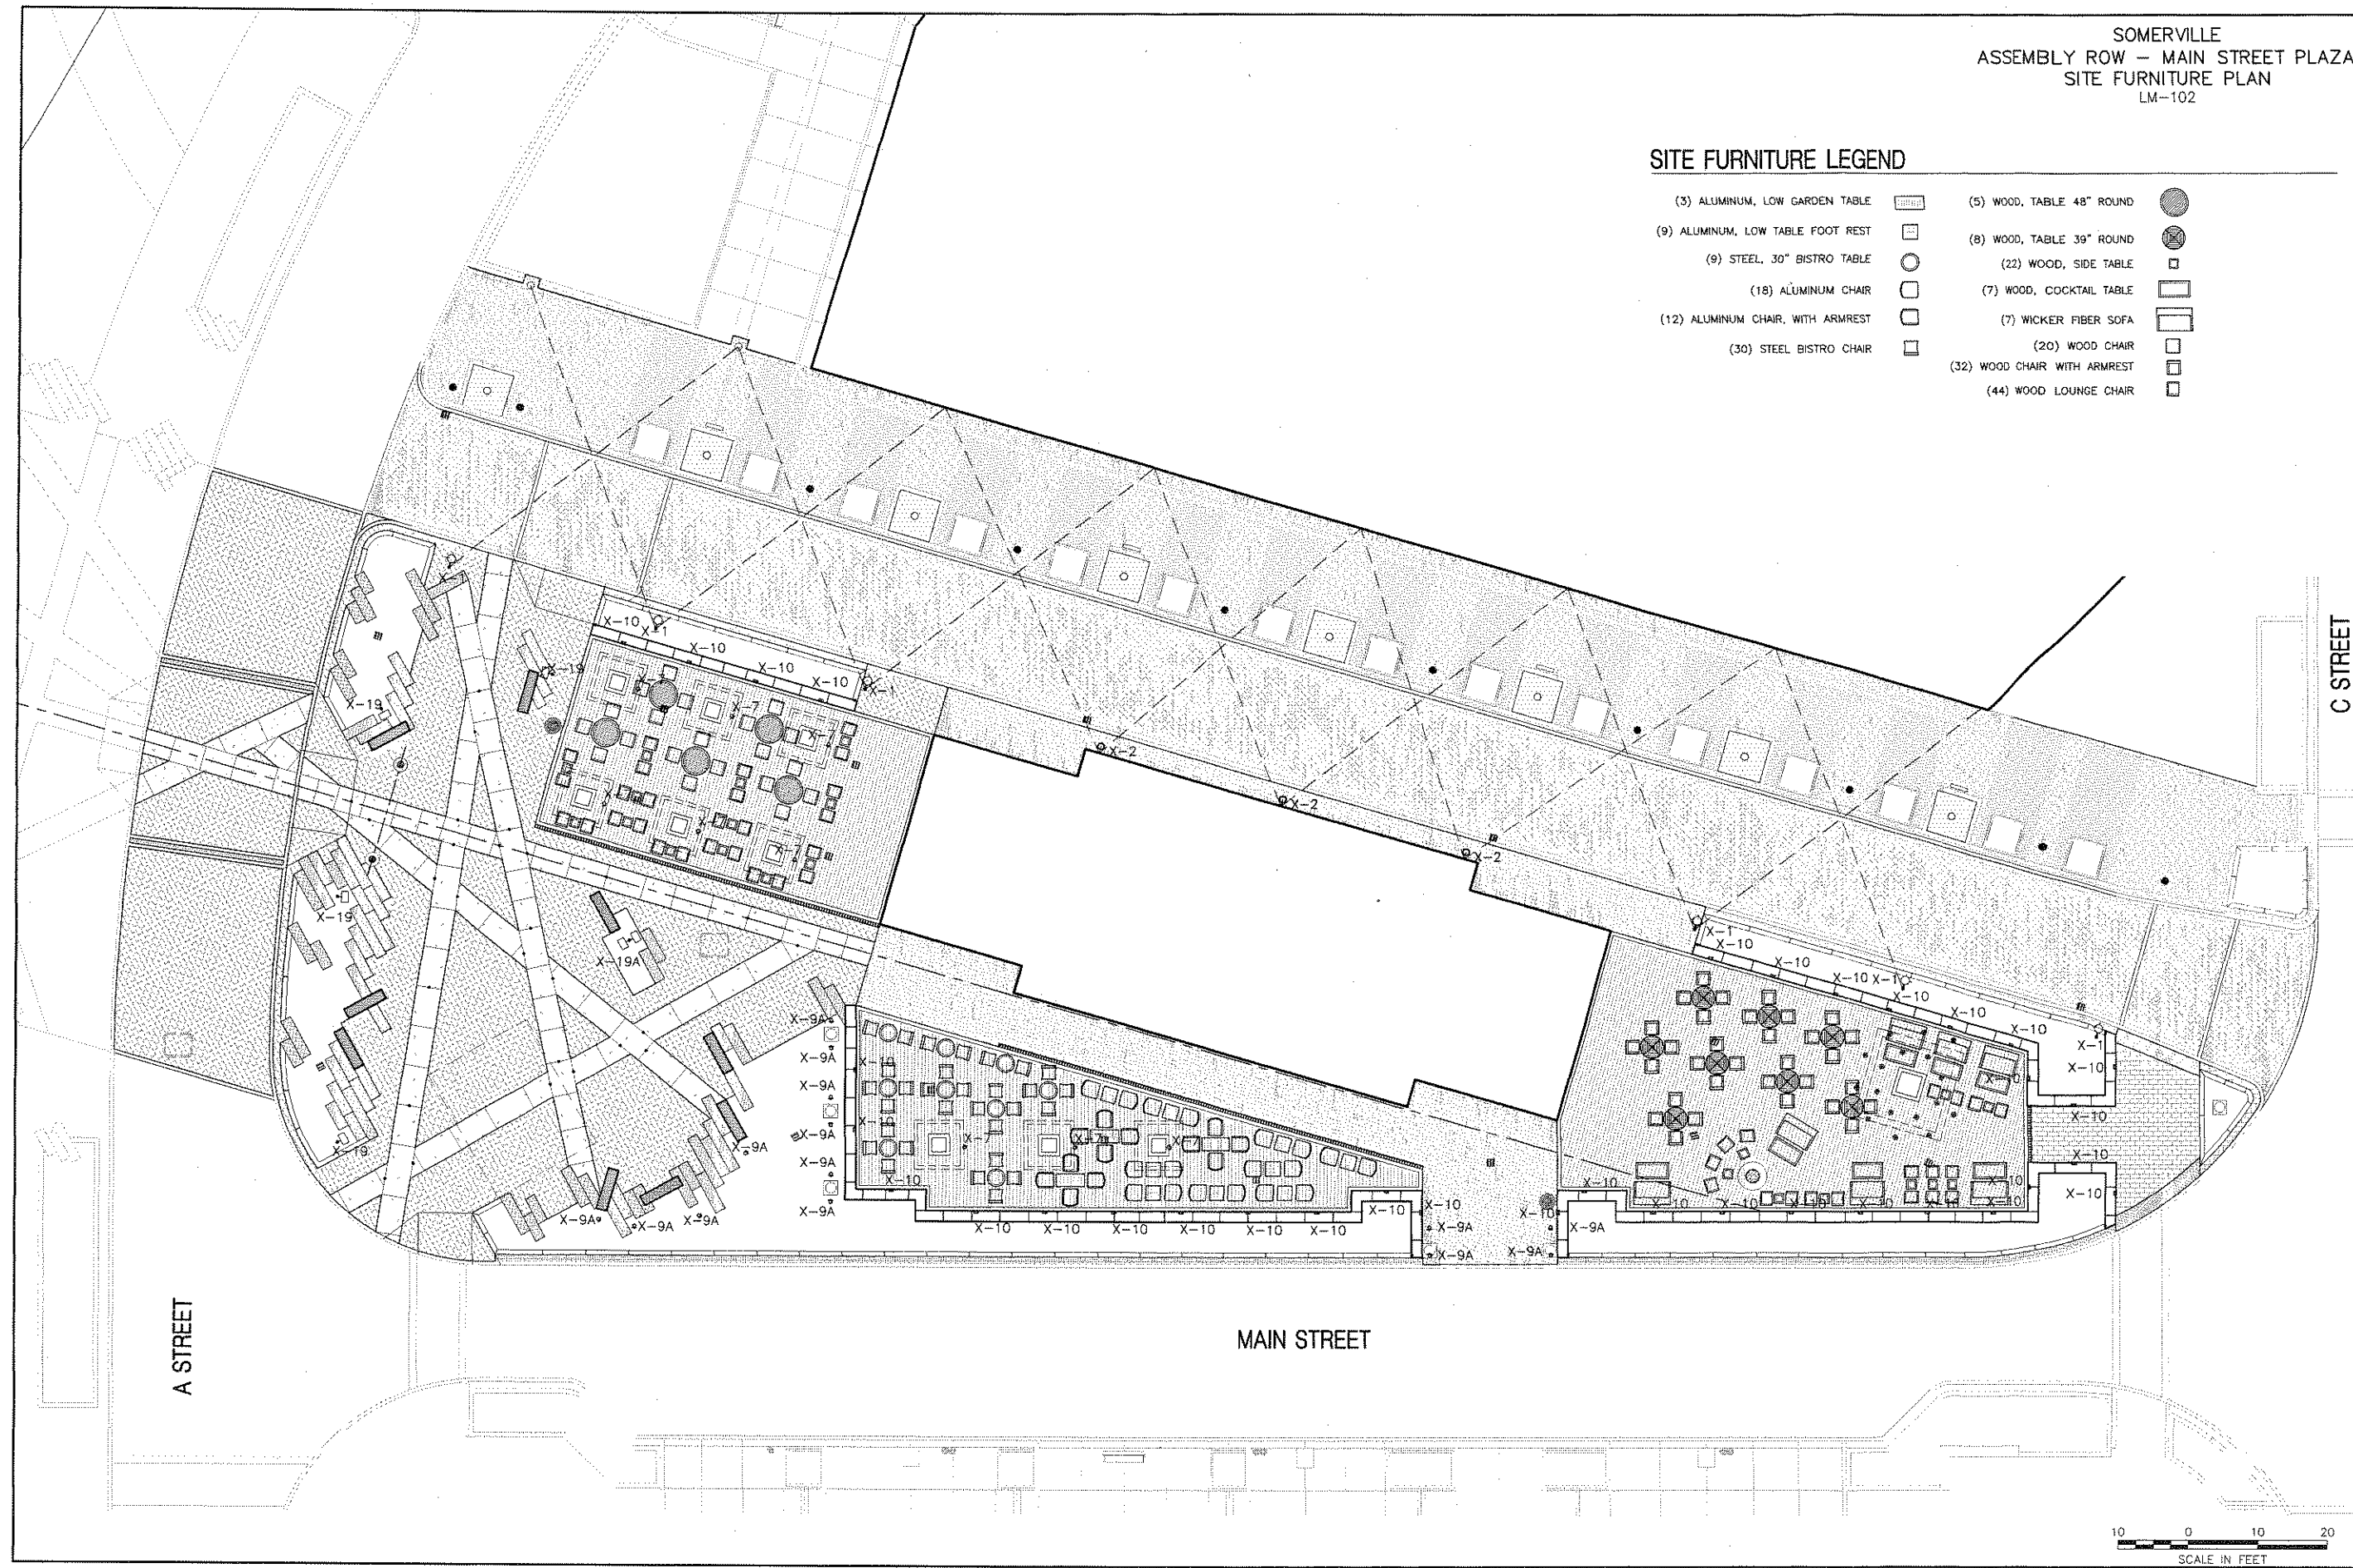


SOMERVILLE
ASSEMBLY ROW - MAIN STREET PLAZA
MATERIALS ENLARGEMENT PLAN
LM-401

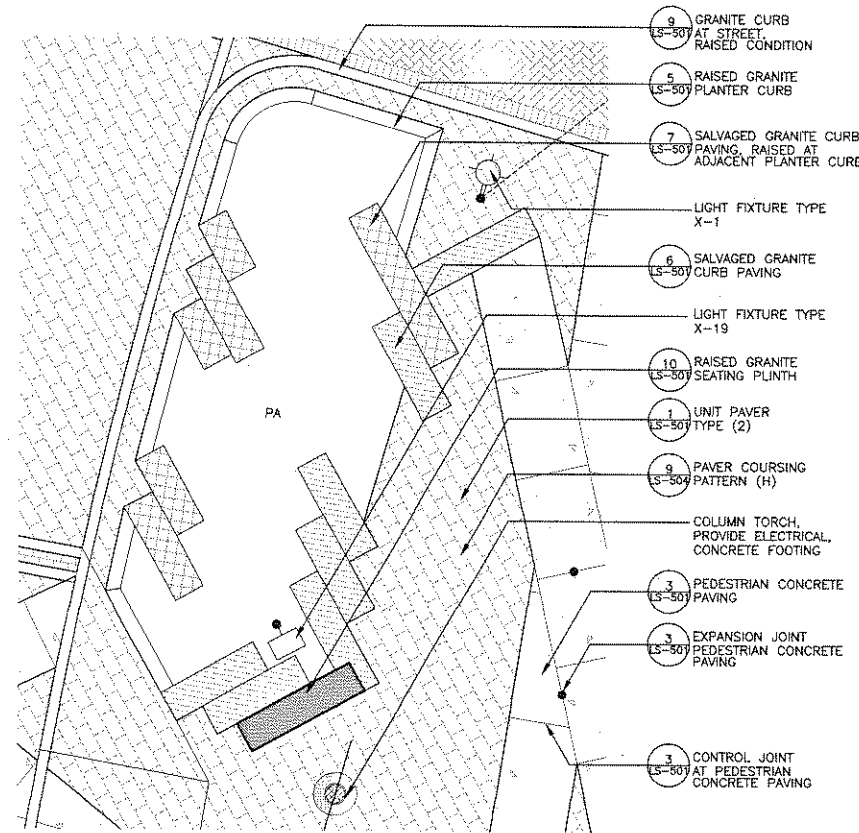


1 MATERIALS ENLARGEMENT 1
SCALE: 1/4" = 1'-0"

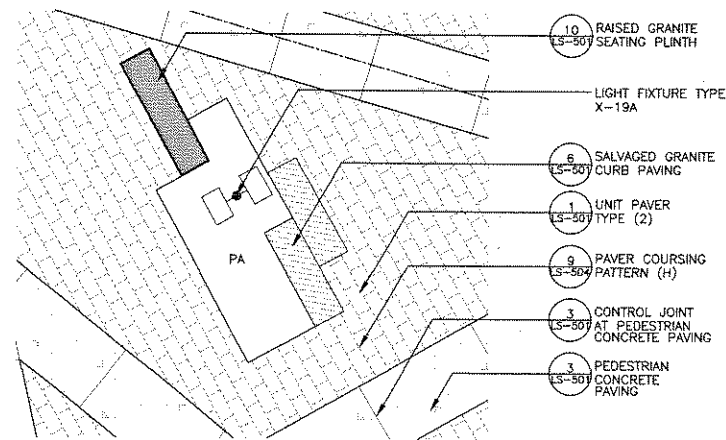

3 MATERIALS ENLARGEMENT 3
SCALE: 1/4" = 1'-0"

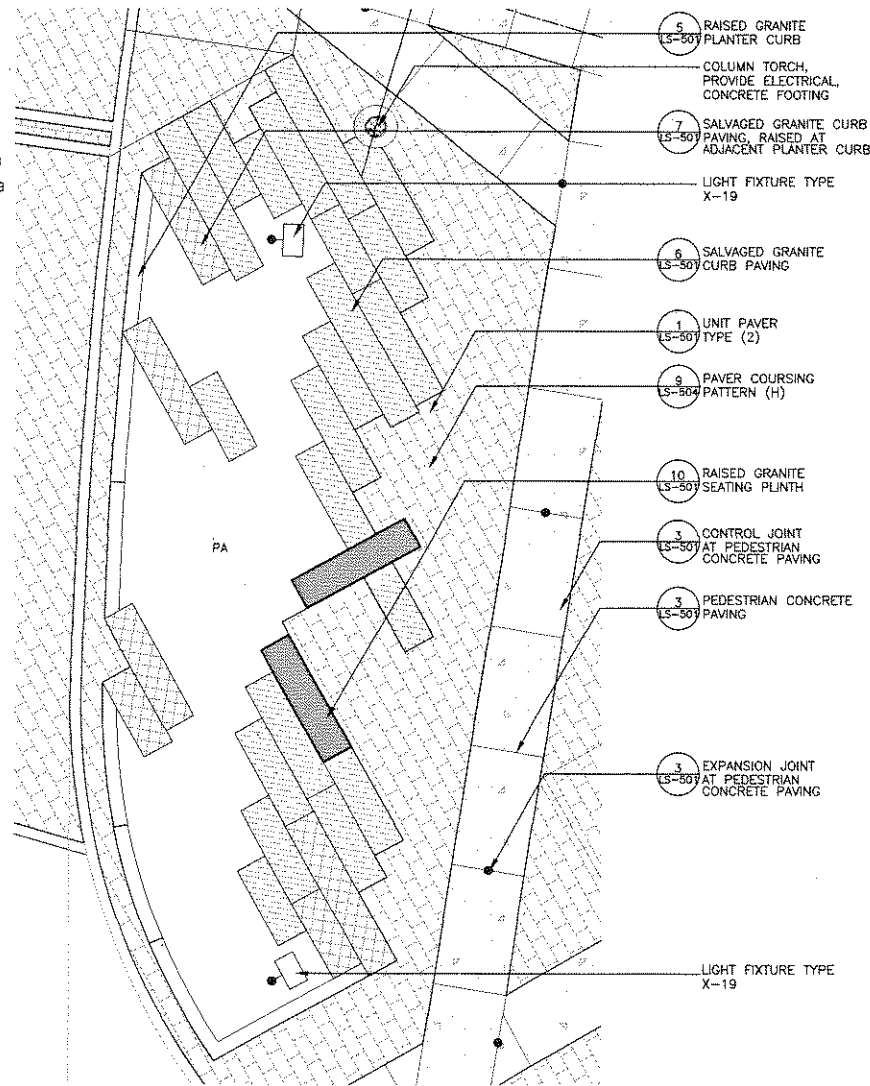

2 MATERIALS ENLARGEMENT 2
SCALE: 1/4" = 1'-0"

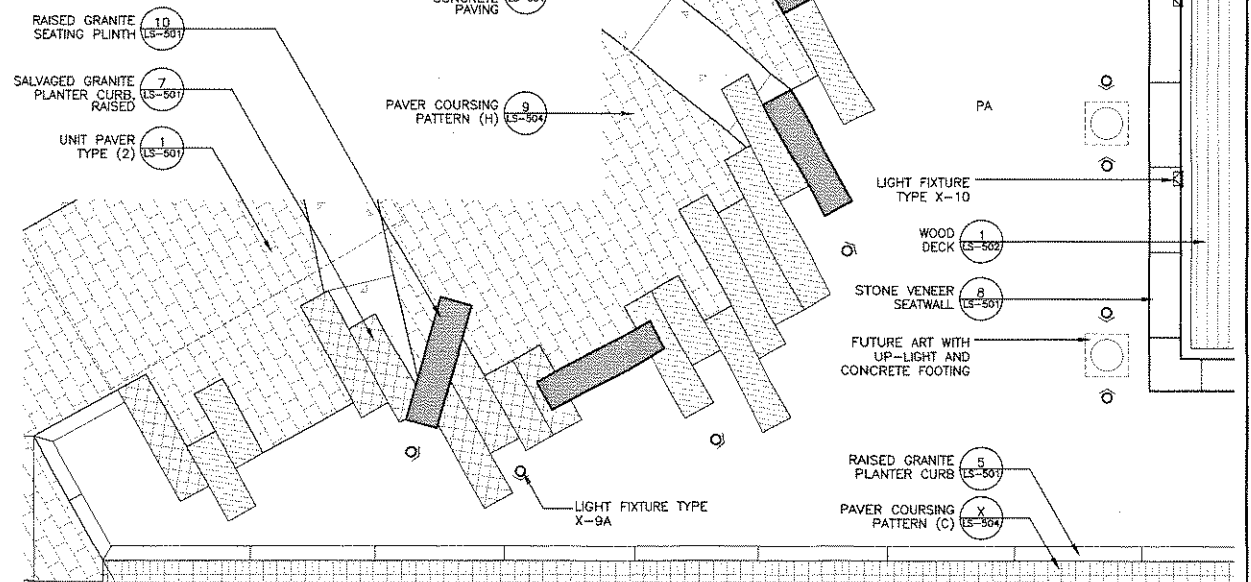

4 MATERIALS ENLARGEMENT 4
SCALE: 1/4" = 1'-0"


SOMERVILLE
ASSEMBLY ROW - MAIN STREET PLAZA
GRADING PLAN
LG-101

GRADING LEGEND

2%	DIRECTION OF PROPOSED SLOPE	TC	TOP OF CURB
10.00	PROPOSED SPOT ELEVATION	BC	BOTTOM OF CURB
10.00	PROPOSED SPOT ELEVATION, PER ROADWAY DESIGN	TW	TOP OF WALL
10.00	PROPOSED SPOT ELEVATION AT TOP OF CONCRETE SLAB BELOW WOOD DECK STRUCTURE	TS	TOP OF STAIR
10.00	PROPOSED SPOT ELEVATION AT INLET GRATE IN CONCRETE SLAB BELOW WOOD DECK STRUCTURE, SEE CIVIL FOR DRAINAGE SYSTEM DESIGN	BS	BOTTOM OF STAIR
10.00	PROPOSED SPOT ELEVATION AT INLET GRATE IN CONCRETE SLAB BELOW WOOD DECK STRUCTURE, SEE CIVIL FOR DRAINAGE SYSTEM DESIGN	HP	HIGH POINT
10.00	PROPOSED SPOT ELEVATION AT INLET GRATE IN CONCRETE SLAB BELOW WOOD DECK STRUCTURE, SEE CIVIL FOR DRAINAGE SYSTEM DESIGN	LP	LOW POINT
10.00	PROPOSED SPOT ELEVATION AT INLET GRATE IN CONCRETE SLAB BELOW WOOD DECK STRUCTURE, SEE CIVIL FOR DRAINAGE SYSTEM DESIGN	R	RIM
10.00	PROPOSED SPOT ELEVATION AT INLET GRATE IN CONCRETE SLAB BELOW WOOD DECK STRUCTURE, SEE CIVIL FOR DRAINAGE SYSTEM DESIGN	INV	INVERT ELEVATION
10.00	PROPOSED SPOT ELEVATION AT INLET GRATE IN CONCRETE SLAB BELOW WOOD DECK STRUCTURE, SEE CIVIL FOR DRAINAGE SYSTEM DESIGN	G	SURFACE GRADE ELEVATION
10.00	PROPOSED SPOT ELEVATION AT INLET GRATE IN CONCRETE SLAB BELOW WOOD DECK STRUCTURE, SEE CIVIL FOR DRAINAGE SYSTEM DESIGN	TD	ELEVATION AT TRENCH DRAIN OPENING


GRADING NOTES

1. CONSULT ALL DRAWINGS AND SPECIFICATIONS FOR COORDINATION REQUIREMENTS BETWEEN ALL TRADES BEFORE COMMENCING NEW CONSTRUCTION. CONTRACTOR SHALL NOTIFY OWNER'S REPRESENTATIVE IMMEDIATELY OF ANY AND ALL CONFLICTS BETWEEN PROPOSED SITE WORK AND WORK OF ALL OTHER TRADES.
2. CONTRACTOR SHALL VERIFY ALL CONDITIONS IN THE FIELD AND REPORT ANY DISCREPANCIES TO THE OWNER'S REPRESENTATIVE PRIOR TO COMMENCING WORK. ANY ALTERATIONS TO THESE DRAWINGS MADE IN THE FIELD SHALL BE PROMPTLY REPORTED BY THE CONTRACTOR TO THE OWNER'S REPRESENTATIVE FOR REVIEW AND APPROVAL AND RECORDED ON RECORD DRAWINGS.
3. CONTRACTOR SHALL BE RESPONSIBLE FOR REPAIRING DAMAGE INSIDE AND OUTSIDE THE LIMIT OF WORK LINE DUE TO CONTRACT OPERATIONS. CONTRACTOR SHALL RESTORE DAMAGED AREAS BEYOND CONTRACT LIMITS TO THEIR ORIGINAL CONDITION AT NO ADDITIONAL COST TO THE OWNER.
4. LOCATION OF EXISTING ABOVEGROUND AND UNDERGROUND UTILITIES SHOWN ON THIS PLAN ARE DIAGRAMMATIC ONLY AND DO NOT REPRESENT ACCURATE LOCATIONS. THE CONTRACTOR SHALL CONTACT THE CITY OF METHUEN AND DIGSAFE TO CONFIRM THE LOCATIONS OF ALL EXISTING UTILITIES BEFORE COMMENCING WORK. ANY DAMAGE DUE TO THE FAILURE OF THE CONTRACTOR TO CONTACT AUTHORITIES SHALL BE BORN BY THE CONTRACTOR. THE CONTRACTOR SHALL REPAIR ANY DAMAGE INCURRED DURING CONSTRUCTION TO EXISTING UTILITIES SCHEDULED TO REMAIN AT NO COST TO THE OWNER.
5. PITCH EVENLY BETWEEN SPOT GRADES. ALL PAVING AREAS MUST PITCH TO DRAIN AT MIN. PITCH OF 1/8" PER FOOT UNLESS OTHERWISE SHOWN. REPORT ANY DISCREPANCIES BETWEEN EXISTING AND PROPOSED SPOT GRADES THAT DO NOT PITCH ACCORDINGLY TO THE OWNER'S REPRESENTATIVE BEFORE COMMENCING WORK.
6. WHERE NEW PAVING MEETS EXISTING PAVING, MEET LINE AND GRADE OF EXISTING SMOOTHLY WITH NEW CONSTRUCTION.
7. EXCAVATION ADJACENT TO EXISTING AND PROPOSED UTILITY LINES AND EXISTING TREES SHALL BE DONE BY HAND. CONTRACTOR SHALL PROTECT ALL EXPOSED UTILITIES.
8. CONTRACTOR SHALL PROTECT EXISTING UTILITIES, EXISTING STRUCTURES, IMPROVEMENTS, APPURTENANCES AND VEGETATION TO REMAIN. CONTRACTOR SHALL REPAIR ANY DAMAGE INCURRED AT NO COST TO OWNER.
9. CONTRACTOR SHALL COMPLY WITH ALL REQUIREMENTS OF PERMITS AND LICENSES ISSUED BY THE FEDERAL, STATE AND LOCAL AGENCIES.
9. CONTRACTOR SHALL COORDINATE ALL SITE UTILITY IMPROVEMENTS WITH THE PROPER AUTHORITIES.
10. MAINTAIN A MAXIMUM OF 2.0% CROSS SLOPE ON ALL PAVED PATHWAYS, UNLESS OTHERWISE NOTED.
11. ALL MANHOLES, DRAINAGE STRUCTURES, STEAM MANHOLES, ELECTRIC MANHOLE FRAMES AND COVERS WITHIN THE PROJECT WORK AREA SHALL BE ADJUSTED TO FINISH GRADES UNLESS OTHERWISE NOTED.

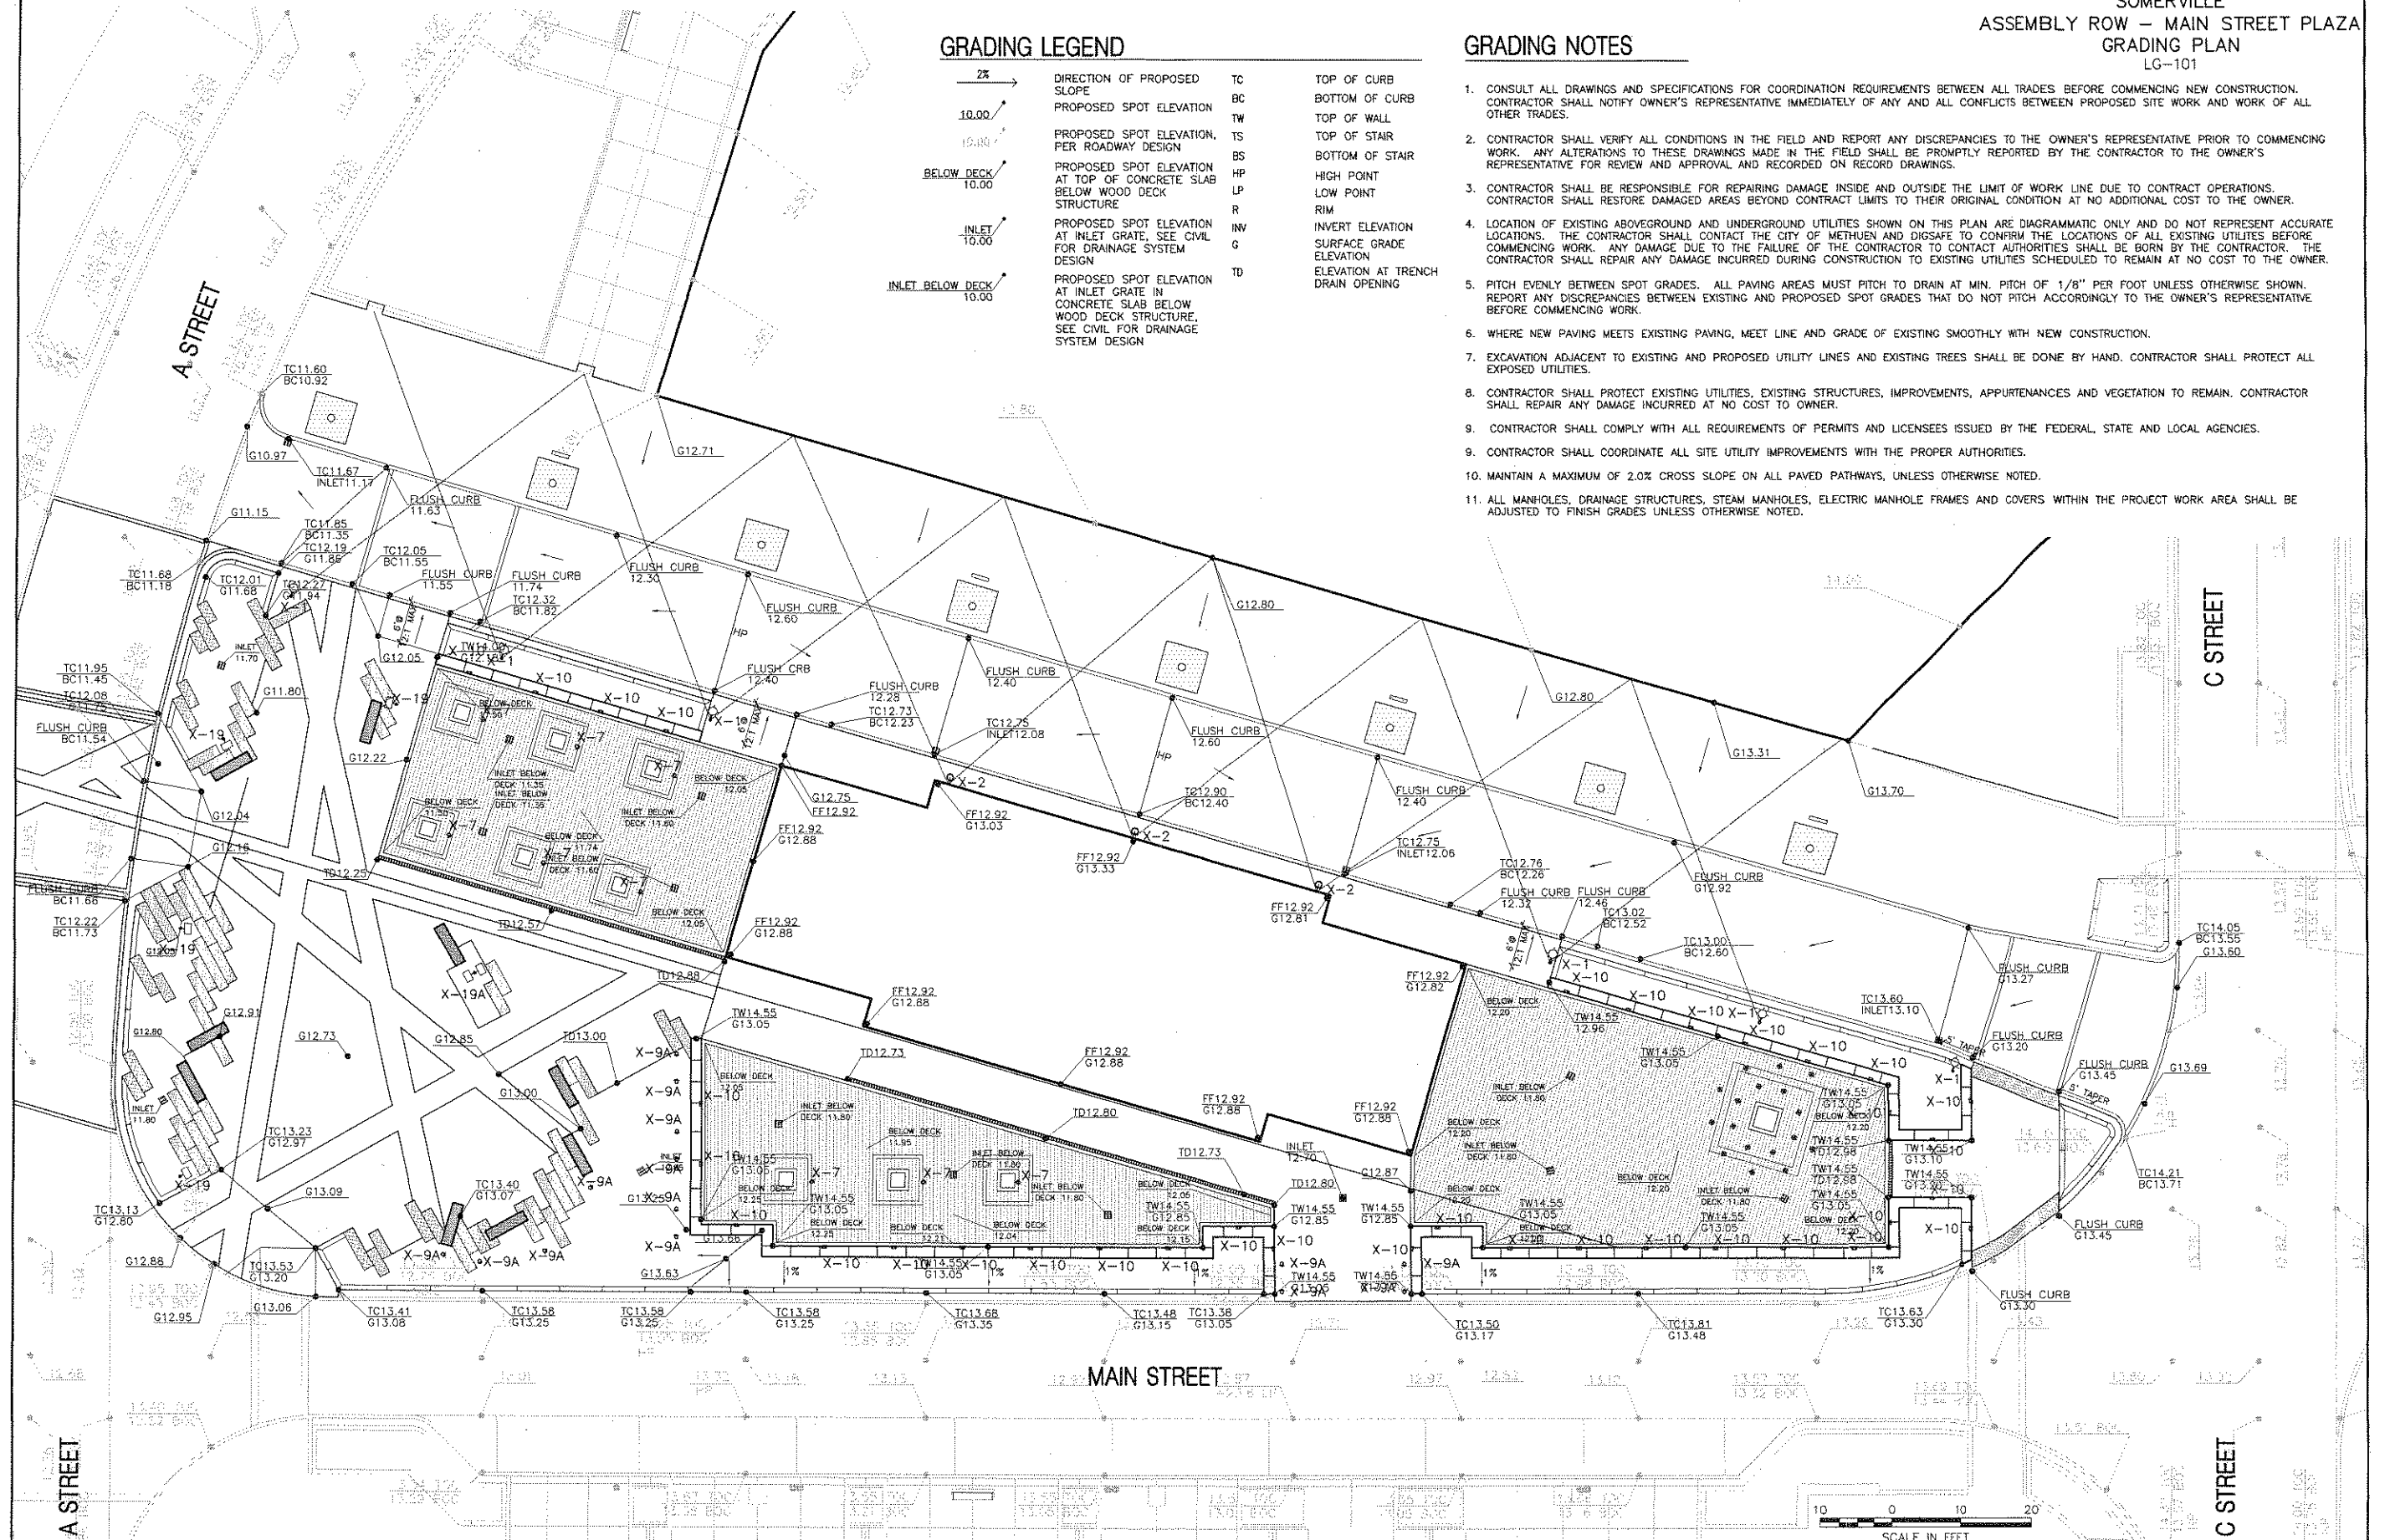


LAYOUT NOTES

1. CONSULT ALL DRAWINGS AND SPECIFICATIONS FOR COORDINATION REQUIREMENTS BETWEEN ALL TRADES PRIOR TO COMMENCING NEW CONSTRUCTION.
2. CONTRACTOR SHALL VERIFY ALL CONDITIONS IN THE FIELD AND REPORT ANY AND ALL DISCREPANCIES TO THE OWNER'S REPRESENTATIVE. ANY ALTERATIONS TO THESE DRAWINGS MADE IN THE FIELD SHALL BE PROMPTLY REPORTED BY THE CONTRACTOR TO THE OWNER'S REPRESENTATIVE AND RECORDED ON DRAWINGS.
3. CONTRACTOR SHALL NOTIFY OWNER'S REPRESENTATIVE IMMEDIATELY OF ANY AND ALL CONFLICTS BETWEEN PROPOSED PLAYGROUND AND WORK OF ALL OTHER TRADES.
4. EXPANSION JOINTS AT ALL VERTICAL INTERFACES, CHANGES OF MATERIALS, CONCRETE COLORS, EVERY 20' O.C. AND AS SHOWN ON THE DRAWINGS.

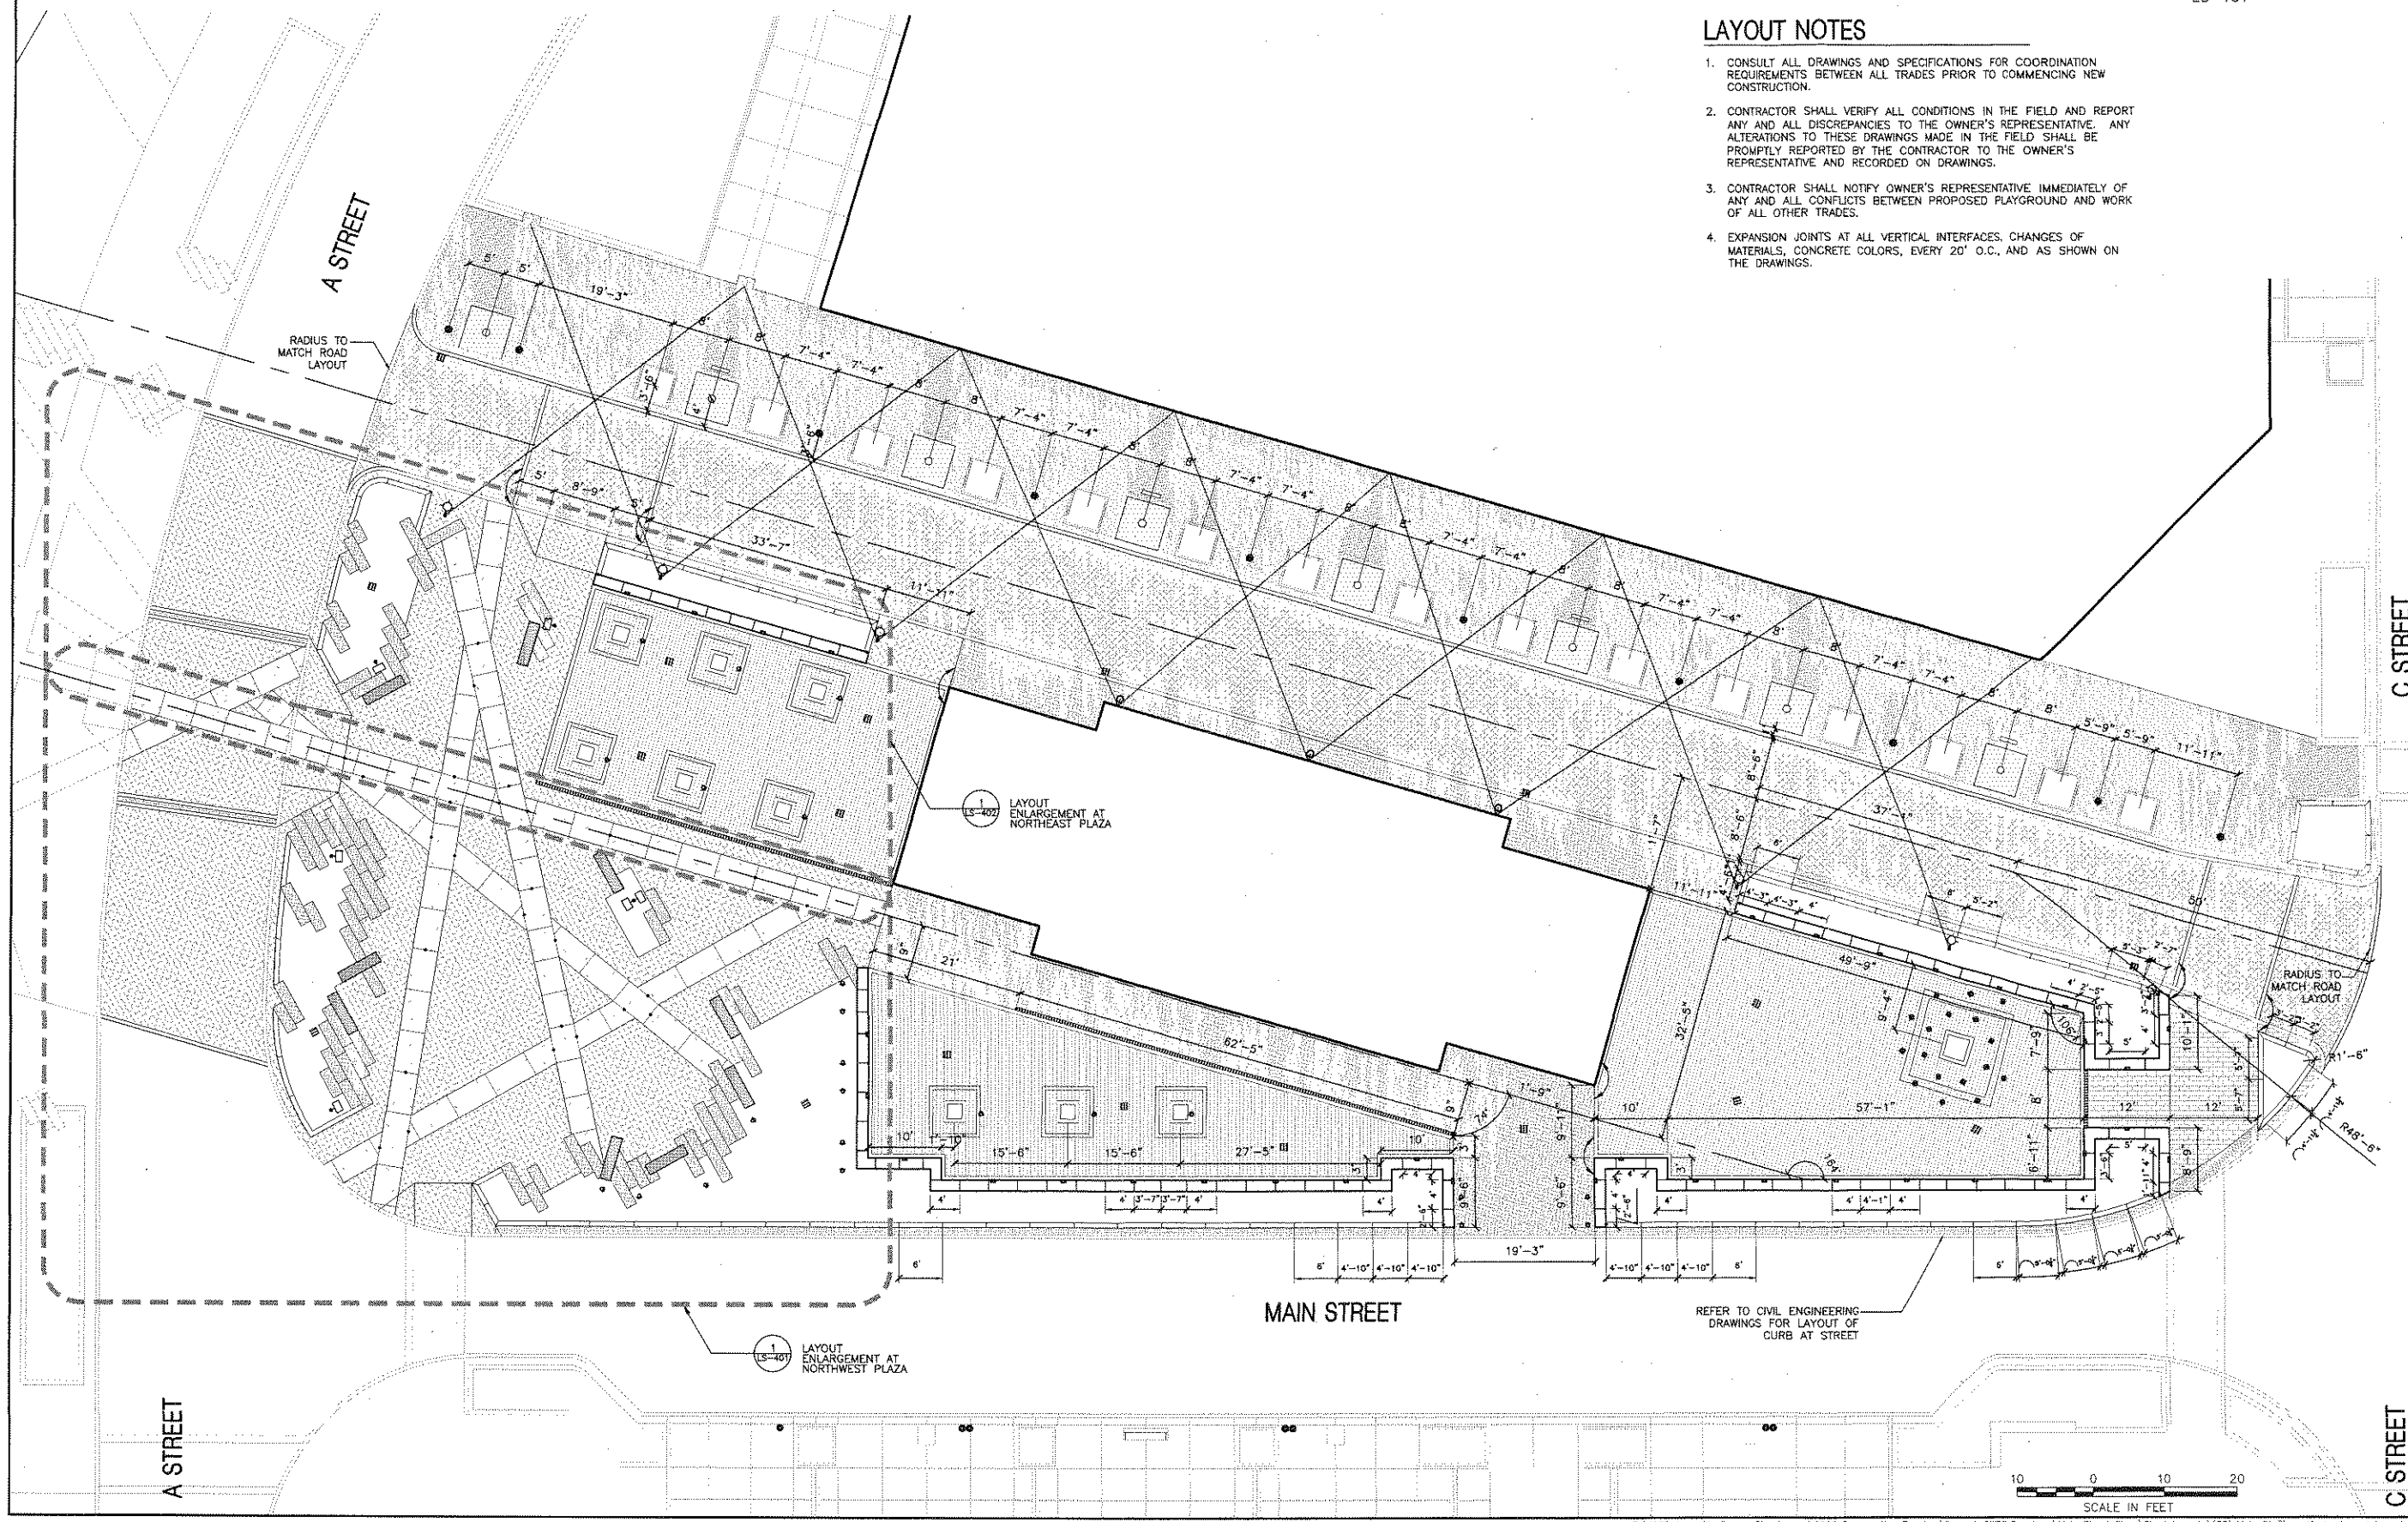


Save Date: May 09, 2012 11:08:50 AM
 User: BOLLNER
 Project: Assembly Row, May 09, 2012 11:08:50 AM
 Plot: BOLLNER

SOMERVILLE
ASSEMBLY ROW - MAIN STREET PLAZA
LAYOUT ENLARGEMENT PLAN
LS-401

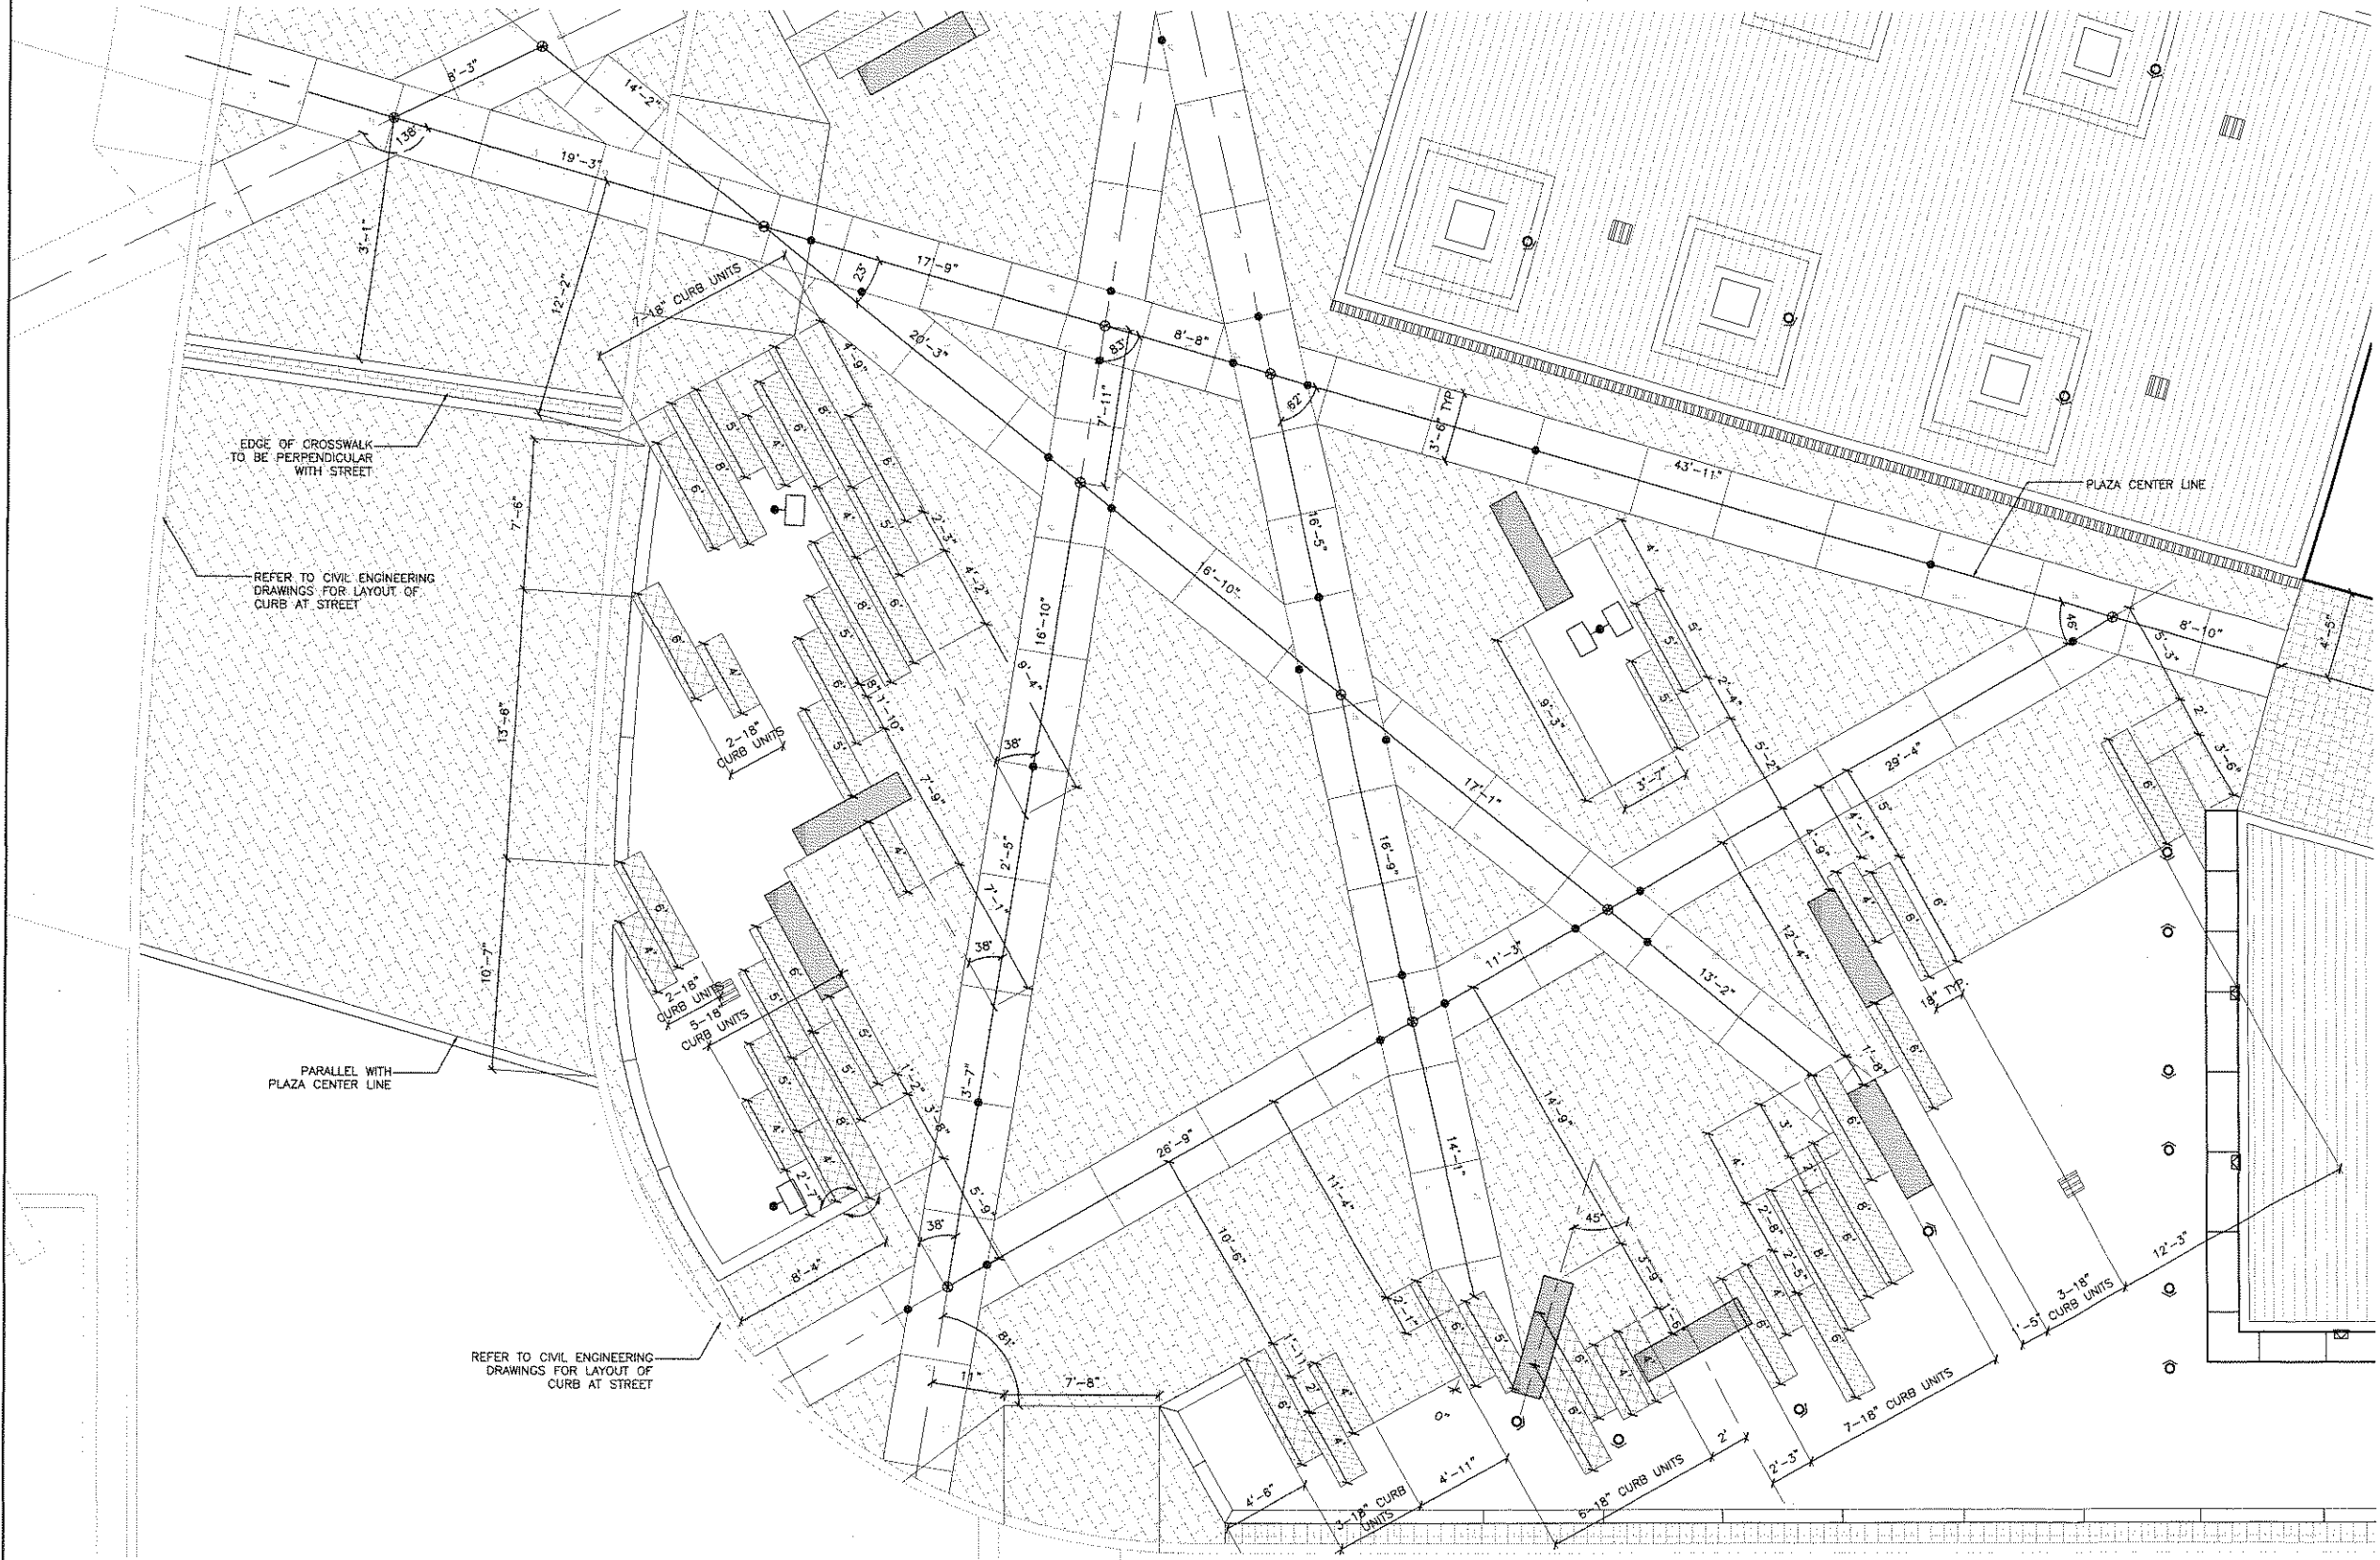

1 LAYOUT ENLARGEMENT AT NORTHWEST PLAZA
SCALE: 1/4" = 1'-0"

SOMERVILLE
ASSEMBLY ROW - MAIN STREET PLAZA
LAYOUT ENLARGMENT PLAN
LS-402

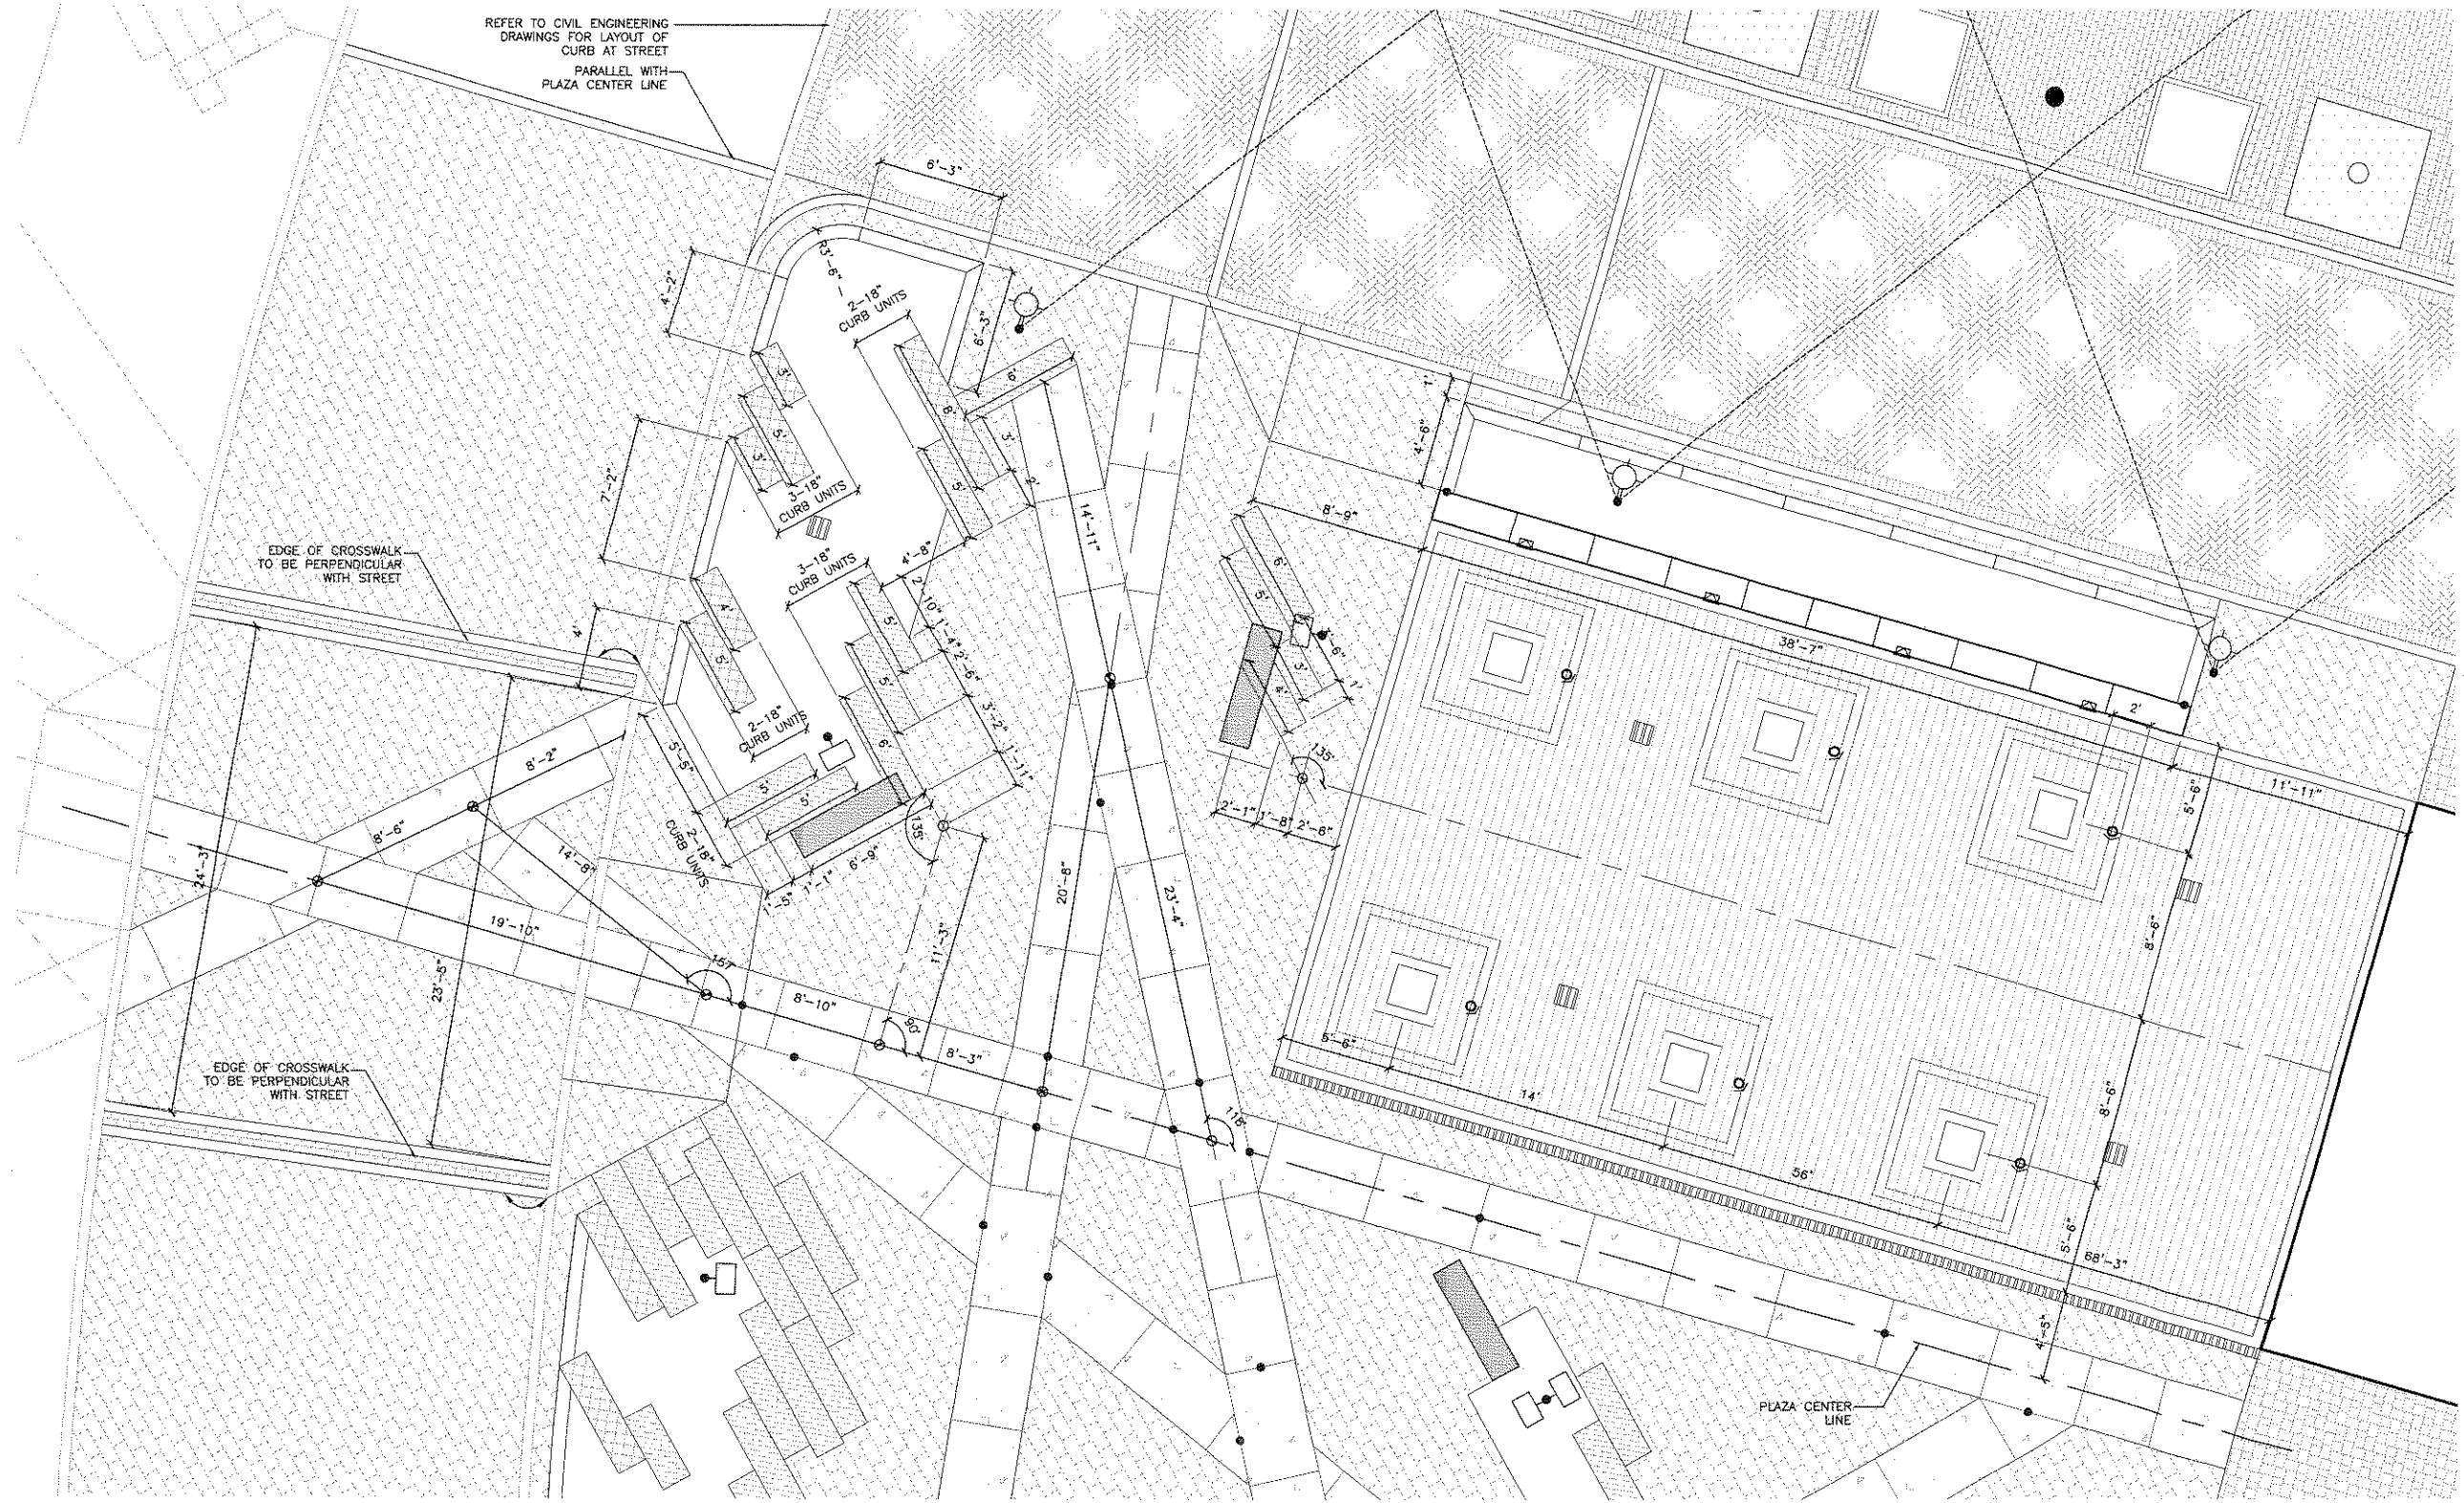

1 LAOUT ENLARGEMENT AT NORTHWEST PLAZA
SCALE: 1/4" = 1'-0"

Save as DWT: May 09, 2012 11:08:50 AM E:\DWG\08 Project\Assembly Row\LS-402.dwg

SOMERVILLE
ASSEMBLY ROW - MAIN STREET PLAZA
PLANTING PLAN
LP-101


PLANTING LEGEND

PROPOSED TREE

PROPOSED SHRUB

PROPOSED GROUND COVER/VINE/
PERENNIAL PLANTING

REFER TO SHEET LP-501 FOR PLANT
SCHEDULE AND NOTES

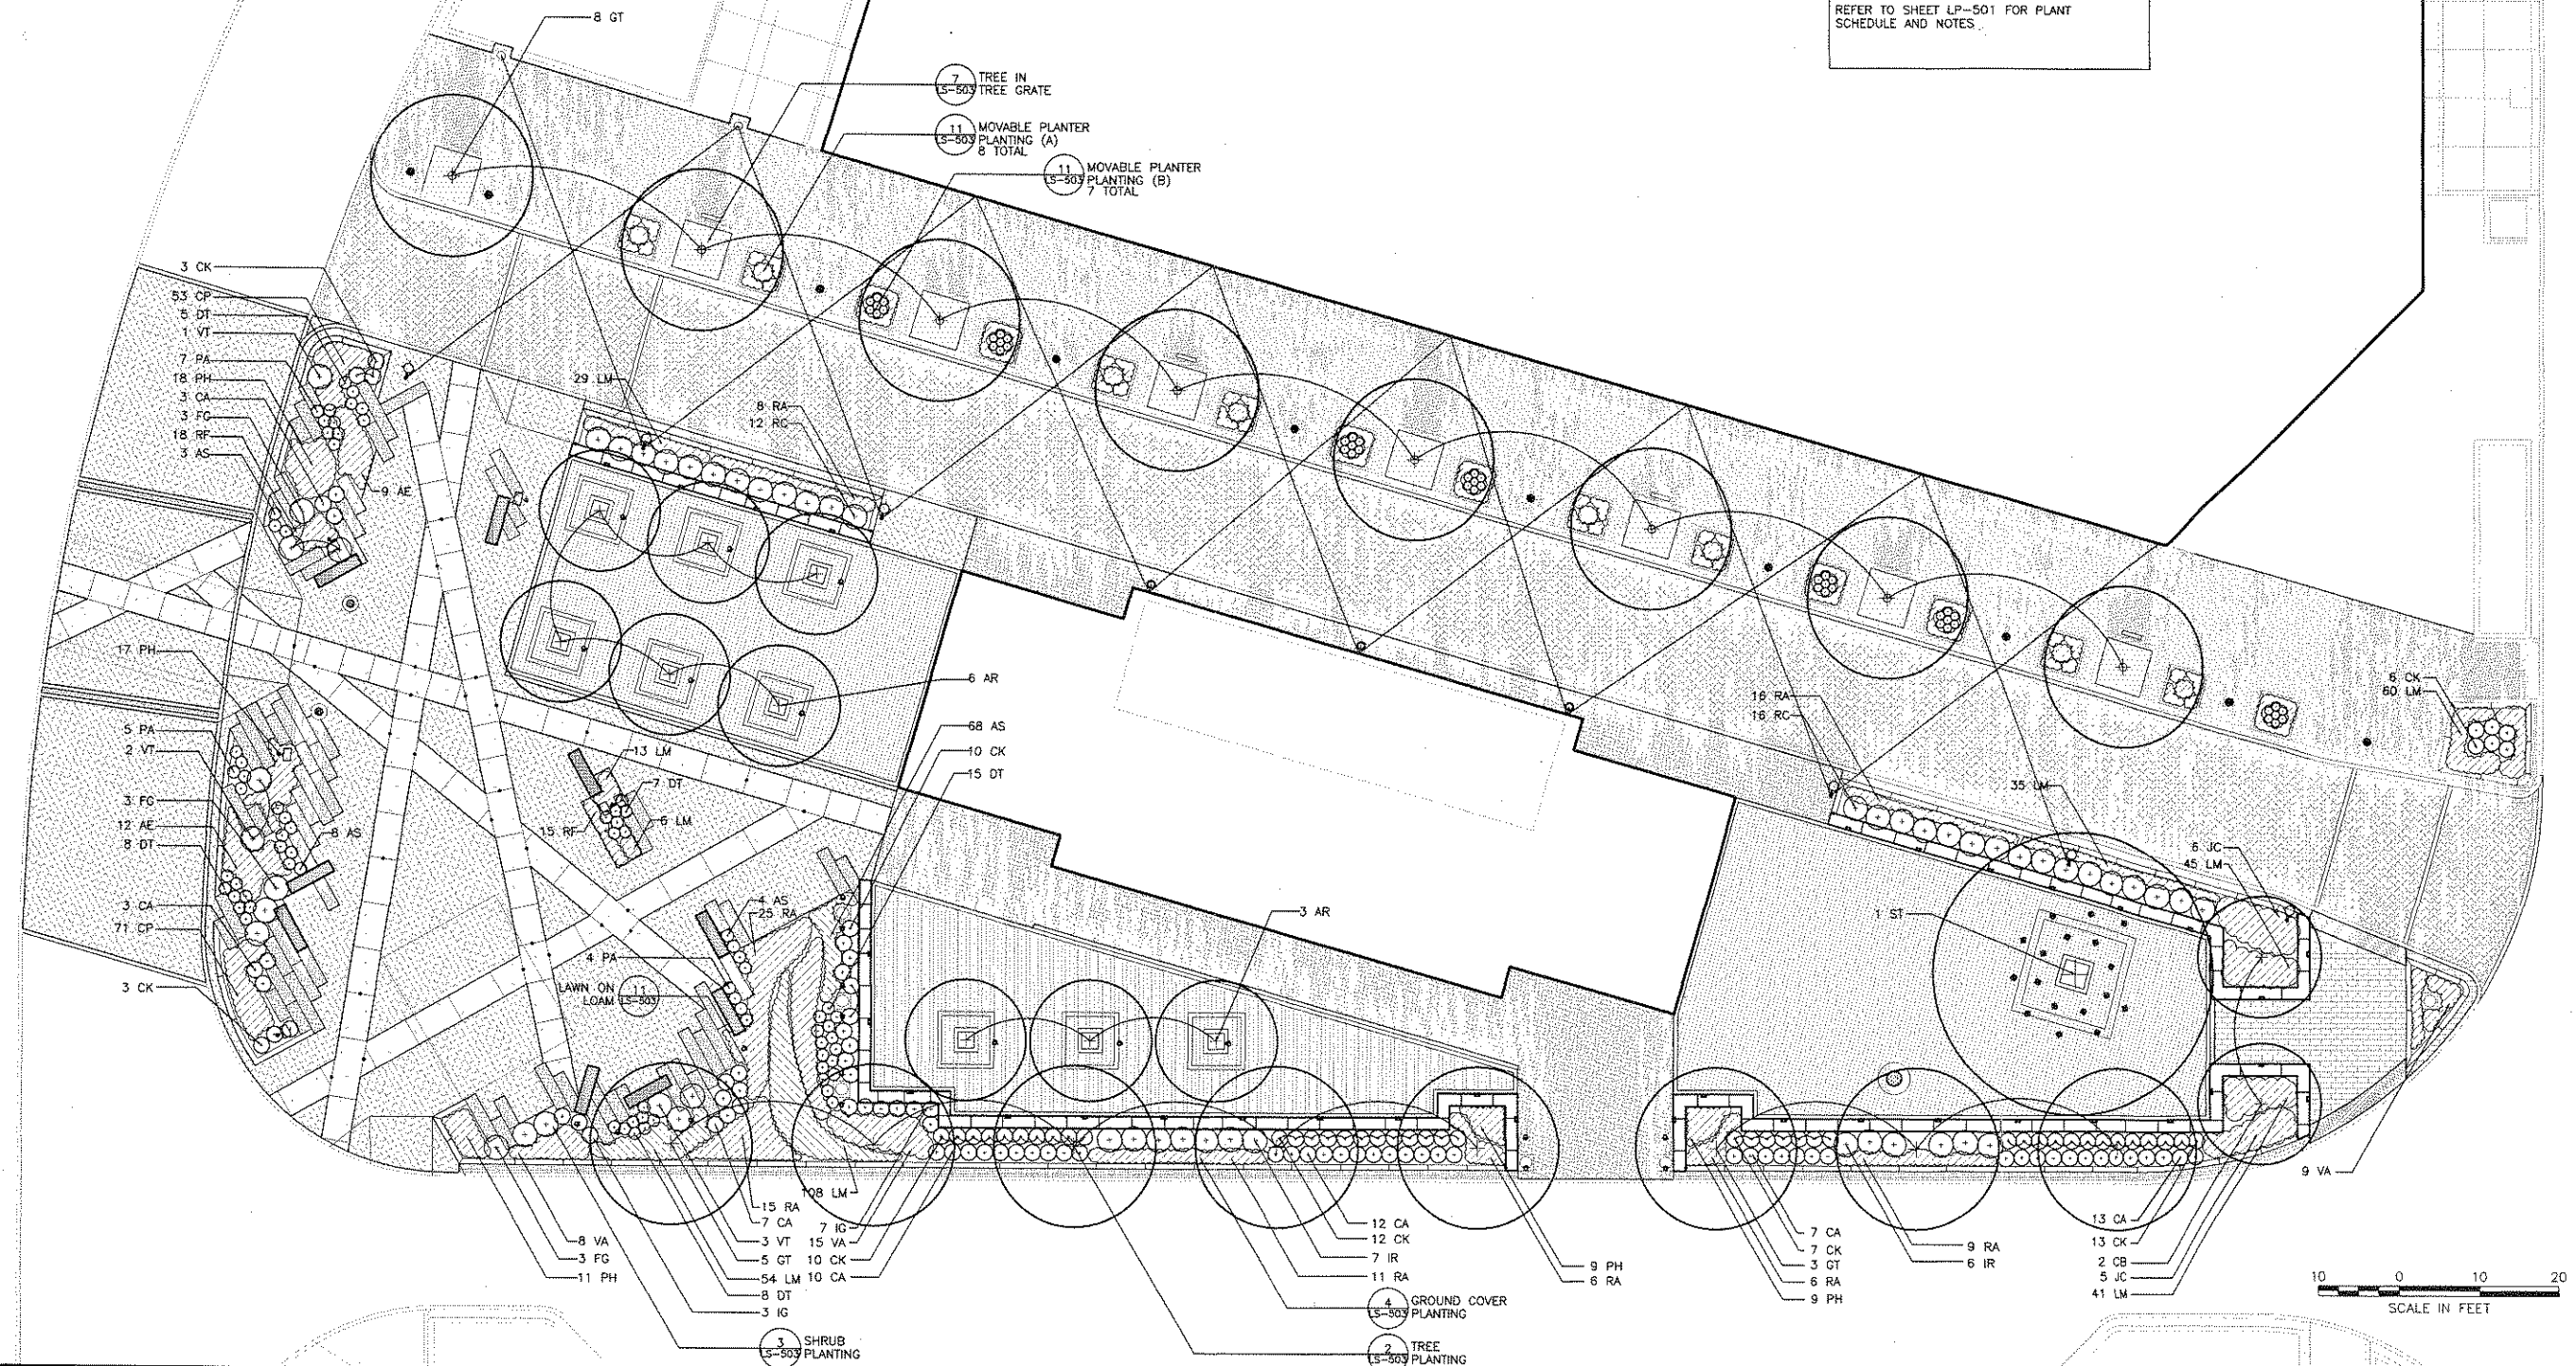

Saved Wednesday, May 09, 2012 12:56:55 PM BY:KAR Picked Wednesday, May 09, 2012 3:56:38 PM Bert Oliver

SOMERVILLE
ASSEMBLY ROW – MAIN STREET PLAZA
PLANTING NOTES AND SCHEDULE
LP-501

PLANTING NOTES

1. The Contractor shall supply all plant material in quantities sufficient to complete the planting shown on drawings.
2. All plant material shall conform to the guidelines established by "The American Standard for Nursery Stock", published by the American Association of Nurserymen.
3. All plants to be tagged at an approved nursery by the Landscape Architect prior to delivery to the site.
4. Stake location of all proposed plant material for the approval of the Landscape Architect prior to the beginning of planting.
5. All trees and shrubs shall bear the same relationship to grade as to the original grade before digging.
6. The Contractor must be extremely cautious while planting in order to avoid damaging existing or proposed utilities. The Contractor shall be responsible for any such damage to utilities.
7. All plant beds for massed shrubs or groundcover planting shall receive a continuous overall application of bark mulch as specified.
8. All disturbed areas to receive loam (8" minimum depth) and seed unless otherwise indicated.
9. All new plant beds and seeded grass are to receive a minimum depth of loam.
10. Install erosion control matting on all slopes greater than 3:1.
11. Plan symbols and areas supercede schedule when discrepancies in quantity occur.

POTS AND SEASONAL ROTATIONS


1. 40 pots to be supplied by Owner. Final locations to be determined by the Owner, pots to be placed by the Contractor.
2. See plant schedule for seasonal rotations to be provided by the Contractor for ALL pots on site. Contractor to provide 4 seasonal rotations per the schedule for 1 full year from the acceptance period.

PLANT LIST


SYM.	QTY.	BOTANICAL NAME	COMMON NAME	COMMENTS	NOTES
TREES					
AR	9	ACER RUBRUM 'RED SUNSET'	RED SUNSET MAPLE	5.5"-6" CAL B&B., SPECIMEN, MATCHED	ALL TREES to match in overall appearance, have a straight trunk, and strong central leader(s). Trees should have a full crown and be well rooted.
CB	2	CARPINUS BETULUS 'FRANZ FONTAINE'	FRANZ FONTAINE EUROPEAN HORNBEEAM	5.5"-6" CAL B&B., SPECIMEN, MATCHED	
GT	16	GLEDITSIA TRIACANTHOS V. INERMIS 'SHADEMASTER'	SHADEMASTER HONEY LOCUST	5.5"-6" CAL B&B., SPECIMEN, MATCHED	
1 ST	SPECIMEN TREE, ALTERNATES BASE ON AVAILABILITY				ALL CONTAINER PLANTS to have a full dense mass and be well rooted.
		QUERCUS COCCINEA	SCARLET OAK	10"-12" CAL B&B., SPECIMEN, SPECIMEN	
		QUERCUS RUBRA	RED OAK	10"-12" CAL B&B., SPECIMEN, SPECIMEN	
		ULMUS AMERICANA 'PRINCETON'	PRINCETON ELM	10"-12" CAL B&B., SPECIMEN, SPECIMEN	All species substitutions must be approved by Landscape Architect
SHRUBS					
CA	55	COMPTONIA PEREGRINA	SWEETFERN	#2 GC 24" O.C.	Provide 1,000 C.F. of structural soil per tree. OR as details and plans notes. Whichever is greater.
CK	64	CORNUS SERICEA 'KELSEY'	RED TWIG DOGWOOD	#5 GC 30" O.C.	
FG	9	FOTHERGILLA GARDENII	DWARF FOTHERGILLA	#5 GC 36" O.C.	
IG	10	ILEX GLABRA 'SHAMROCK'	INKBERRY	#3 GC 24" O.C.	
IR	13	ILEX VERTICILLATA 'RED SPRITE'	RED SPRITE WINTERBERRY	#5 GC 36" O.C.	
JC	11	JUNIPER CHINENSIS 'SEAGREEN'	CHINESE JUNIPER	#1 GC, 36" O.C.	
RA	96	RHUS AROMATICA 'GRO-LOW'	GRO-LOW FRAGRANT SUMAC	#2 GC 24" O.C.	
RC	28	RHODODENDRON 'CHIONOIDES'	CHIONOIDES RHODODENDRON	#5 GC 36" O.C.	
VA	32	VACCINIUM ANGUSTIFOLIUM	LOWBUSH BLUEBERRY	#1 GC 24" O.C.	
VT	6	VIBURNUM TRILOBUM 'COMPACTUM'	DWARF CRANBERRYBUSH VIBURNUM	#5 GC 36" O.C.	
PERENNIALS/GROUNDCOVER					
AC	230	ASCLEPIAS TUBEROSA	BUTTERFLY MILKWEED	4" CONT. 12" O.C.	
AE	21	ASTER NOVAE-ANGLIAE	NEW ENGLAND ASTER	#1 GC, 24" O.C.	
AS	64	ASTILBE CHINENSIS 'VISIONS PURPLE'	PURPLE ASTILBE	#1 GC, 12" O.C.	
CP	124	CAREX PENNSYLVANICA	PENNSYLVANIA SEDGE	#1 GC, 10" O.C.	
DT	43	DESCHAMPSIA CESPITOSA	TUFTED HAIR GRASS	#1 GC, 24" O.C.	
LM	391	LIRIOPE MUSCARI 'BIG BLUE'	BIG BLUE LIRIOPE	#1 GC, 12" O.C.	
LC	40	LOBELLIA CARDINALIS	CARDINAL FLOWER	#1 GC, 12" O.C.	
PA	16	PEROVSKIA ATRIPLICIFOLIA 'LITTLE SPIRE'	RUSSIAN SAGE	#2 GC, 18" O.C.	
PH	64	PENNISETUM ALOPECUROIDES 'HAMELN'	DWARF FOUNTAIN GRASS	#2 GC, 18" O.C.	
RF	113	RUDBECKIA FULGIDA VAR. SULLIVANTII 'GOLDSTURM'	BLACK-EYED SUSAN	#1 GC, 12" O.C.	

SEASONAL ROTATIONS


SYM	QTY.	BOTANICAL NAME	COMMON NAME	COMMENTS	
SEASONAL PLANTING – SPRING ROTATION APRIL 1ST THROUGH MAY 15TH					
	125 SF	DAFFODILUS – YELLOW AND WHITE, 50%; TULIPS – WHITE EMPEROR, 50% PANSYS – 50% 'CLEAR SKY PURPLE' AND 50% 'INSPIRE WHITE'		6" O.C.	
SEASONAL PLANTING – SUMMER ROTATION MAY 15TH THROUGH SEPTEMBER 1ST (OWNER TO SELECT COLOR); ALTERNATE COLOR BY PLANTER; 2 FLOWERING ANNUALS, 1 VINE, 1 GRASS					
	125 SF	PETUNIA – 1 COLOR CALIBRACHOA – 1 COLOR	IPOMOEA BATATAS VINCA MINOR	PENNISETUM S.'RED RIDING HOOD' PENNISETUM P.'VERTIGO'	6" O.C.
SEASONAL PLANTING – FALL ROTATION SEPTEMBER 1ST THROUGH DECEMBER 1ST (OWNER TO SELECT COLOR)					
	125 SF	CHRYSANTHEMUM – TWO COLORS, ALTERNATE COLOR BY PLANTER			1 GAL POT 15" O.C.
SEASONAL PLANTING – WINTER ROTATION DECEMBER 1ST THROUGH APRIL 1ST (OWNER TO APPROVE FINAL DISPLAY; PROVIDE SAMPLE)					
	125 SF	25% RED TWIG DOGWOOD BRANCHES, 25% WHITE BIRCH BRANCHES, 25% EVERGREEN MATERIAL, 25% HOLLY BRANCHES WITH BERRIES			FILL POTS; SUBMIT MOCKUP FOR APPROVAL

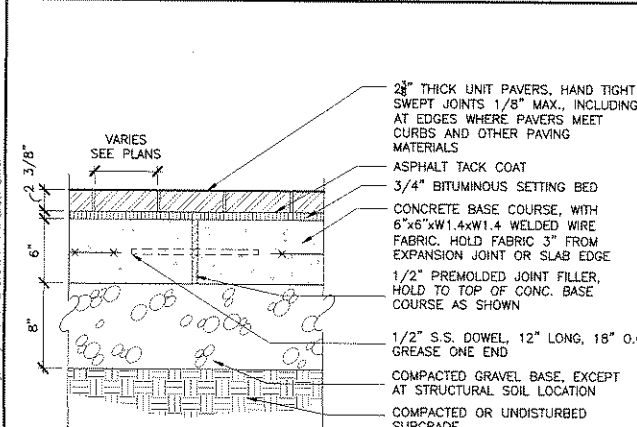


1 UNIT PAVERS (PEDESTRIAN)
SCALE: 1-1/2"=1'-0"

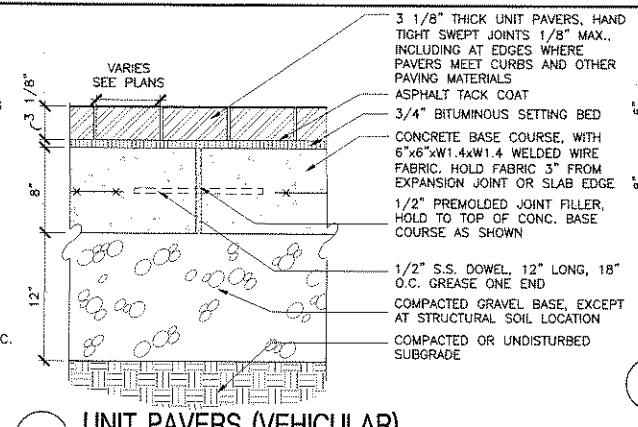


2 UNIT PAVERS (VEHICULAR)
SCALE: 1-1/2"=1'-0"

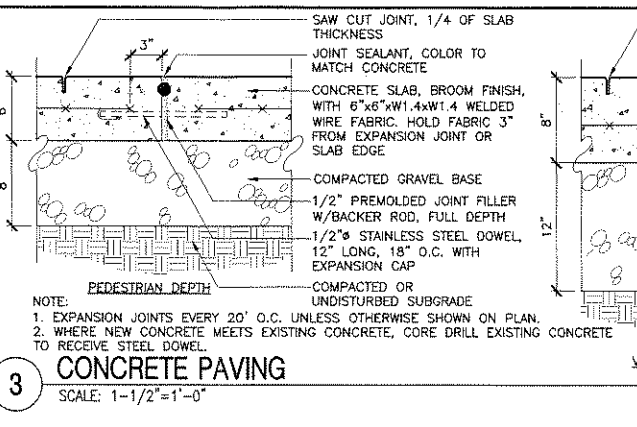


3 CONCRETE PAVING
SCALE: 1-1/2"=1'-0"

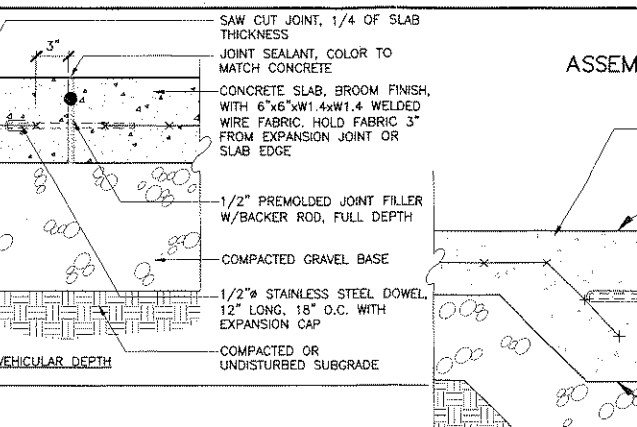


4 CONCRETE PAVING AT UNIT PAVERS
SCALE: 1-1/2"=1'-0"

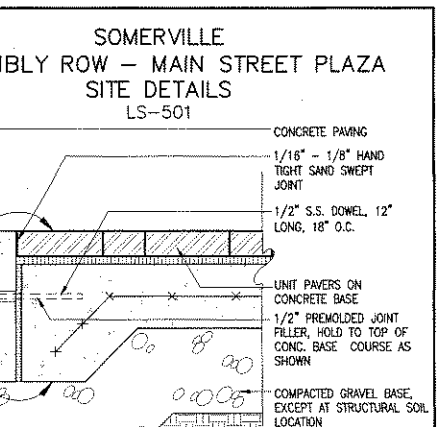


5 RAISED GRANITE PLANTER CURB-4
SCALE: 1-1/2"=1'-0"

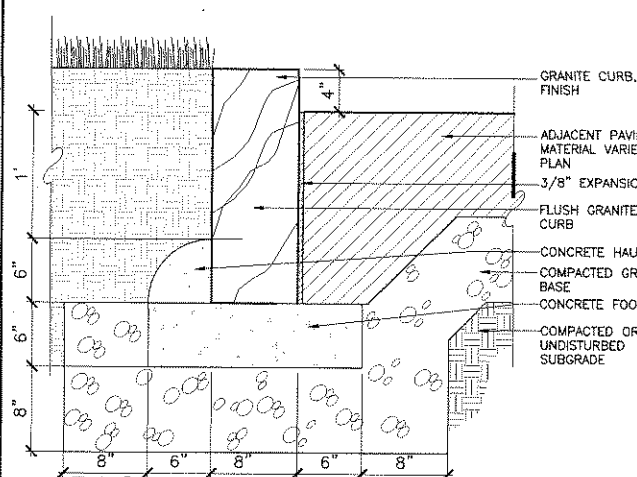


6 SALVAGED GRANITE CURB PAVING
SCALE: 1-1/2"=1'-0"

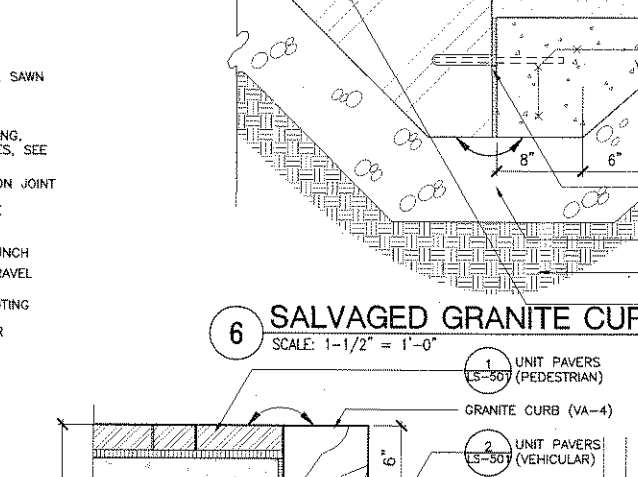


7 SALVAGED GRANITE CURB PAVING, RAISED AT ADJACENT PLANTER CURB
SCALE: 1-1/2"=1'-0"

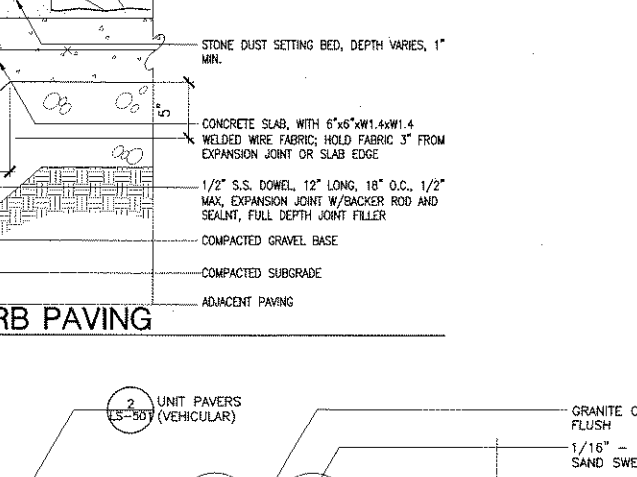


8 GRANITE CURB AT STREET, RAISED AND FLUSH CONDITION
SCALE: 1-1/2"=1'-0"

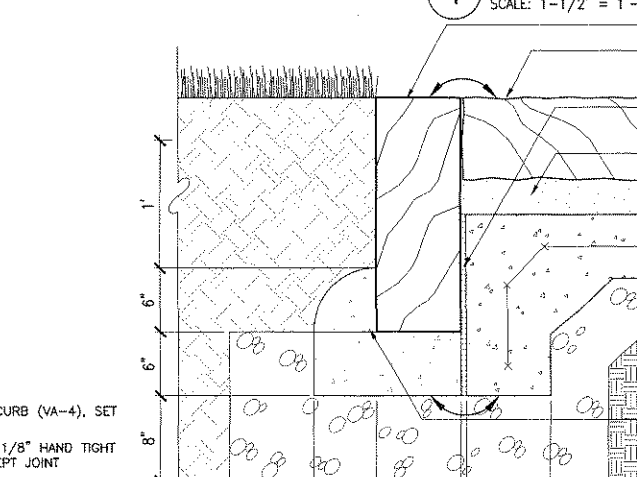


9 STONE VENEER SEATWALL
SCALE: 1"=1'-0"

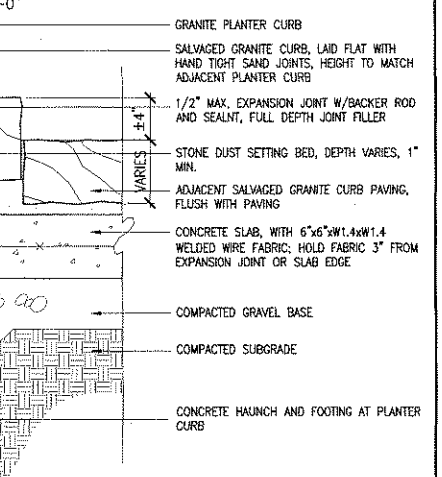


10 RAISED GRANITE SEATING PLINTH
SCALE: 1"=1'-0"

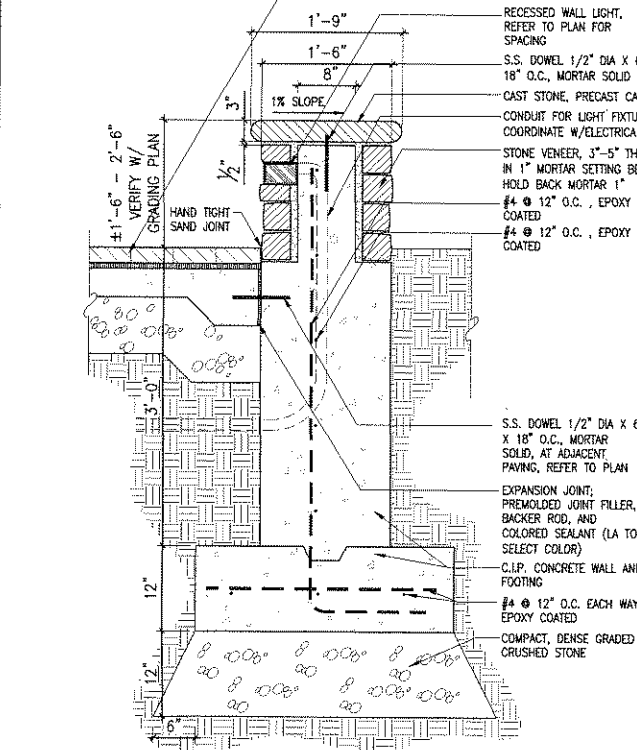


11 ACCESSIBLE CURB RAMP
SCALE: 1/2"=1'-0"

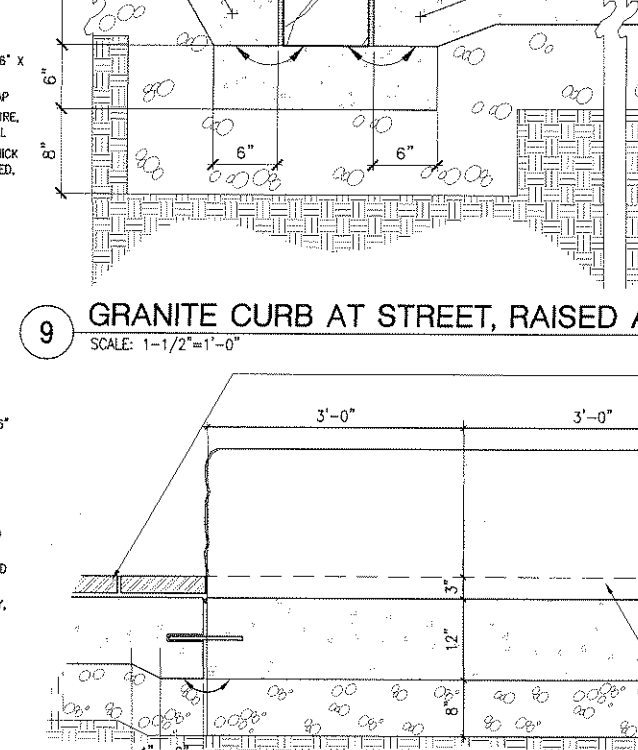


12 GRANITE PLANTER CURB
SCALE: 1-1/2"=1'-0"

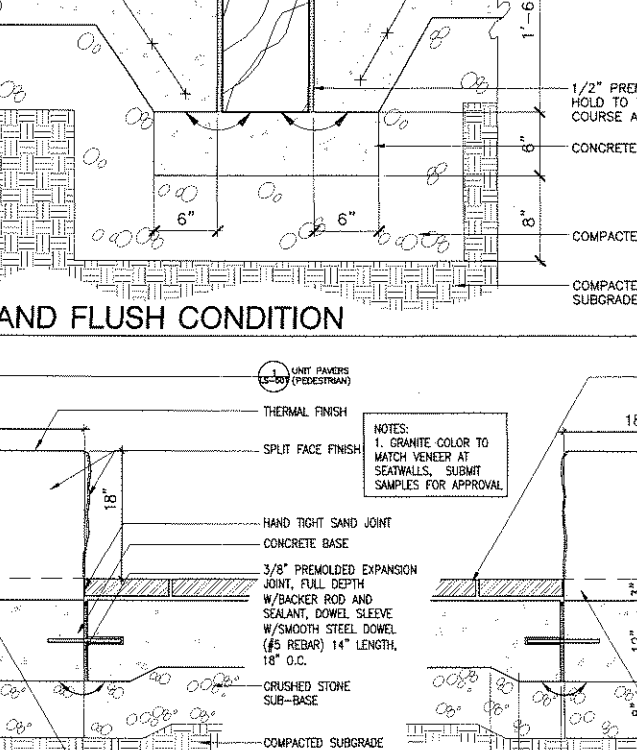

13 GRANITE CURB AT STREET, RAISED AND FLUSH CONDITION
SCALE: 1-1/2"=1'-0"

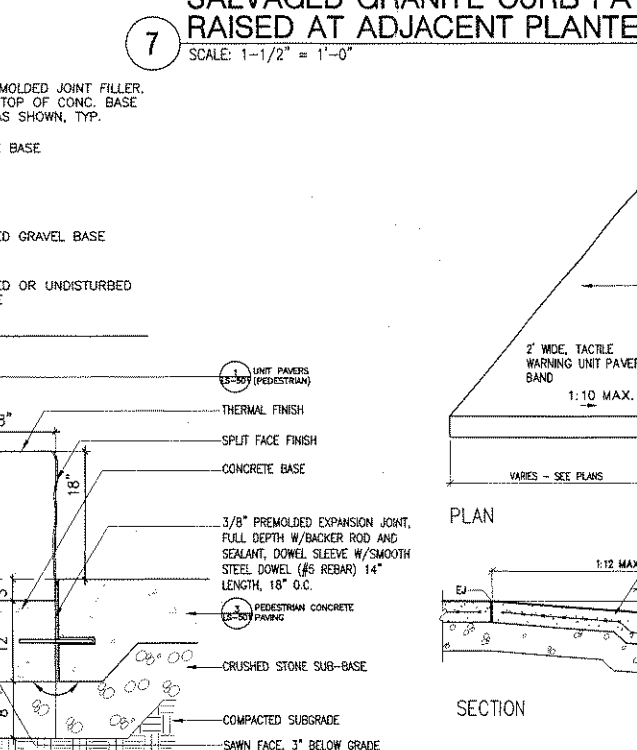


14 GRANITE CURB AT STREET, RAISED AND FLUSH CONDITION
SCALE: 1-1/2"=1'-0"

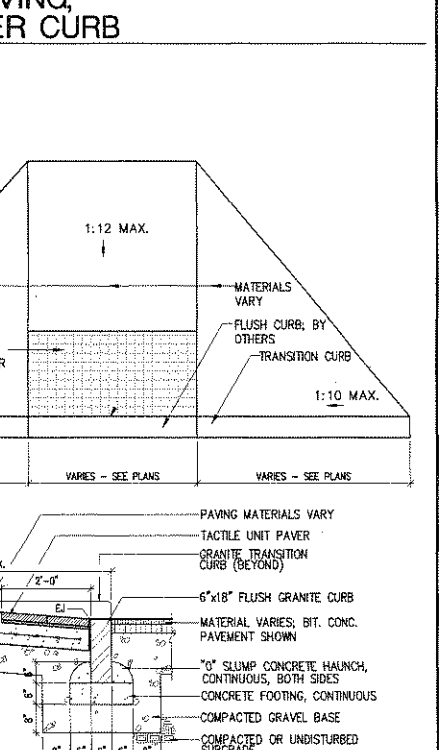



15 GRANITE CURB AT STREET, RAISED AND FLUSH CONDITION
SCALE: 1-1/2"=1'-0"

Save: Wednesday, May 09, 2012 3:04:19 PM BUIKER, David W. Project: Somerset, May 09, 2012 3:14:57 PM Brett, Oliver



SOMERVILLE
ASSEMBLY ROW - MAIN STREET PLAZA
SITE DETAILS
LS-502

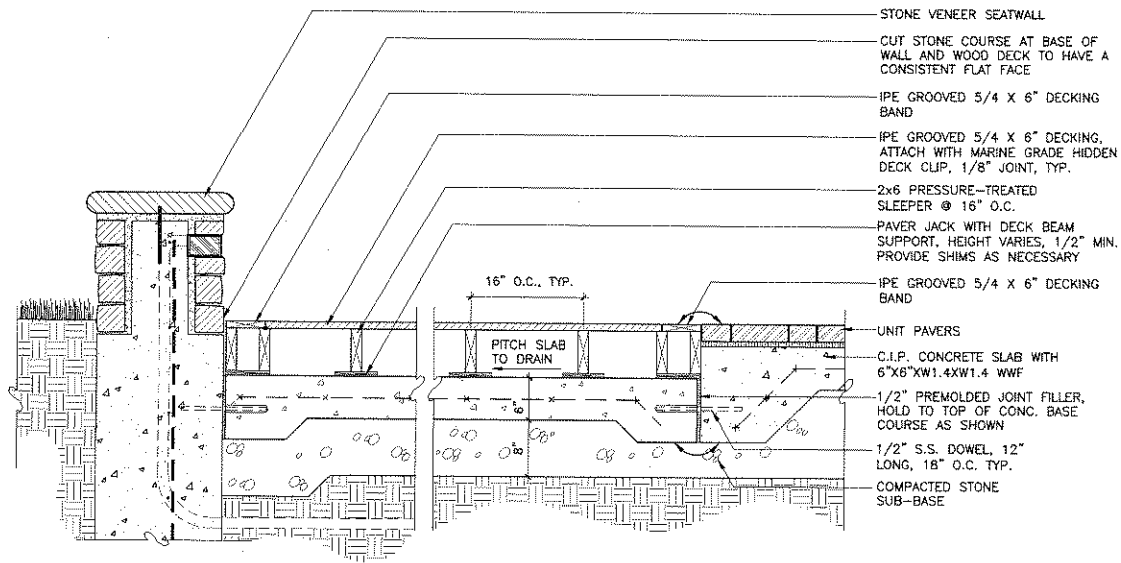


1 WOOD DECK
SCALE: 1"=1'-0"

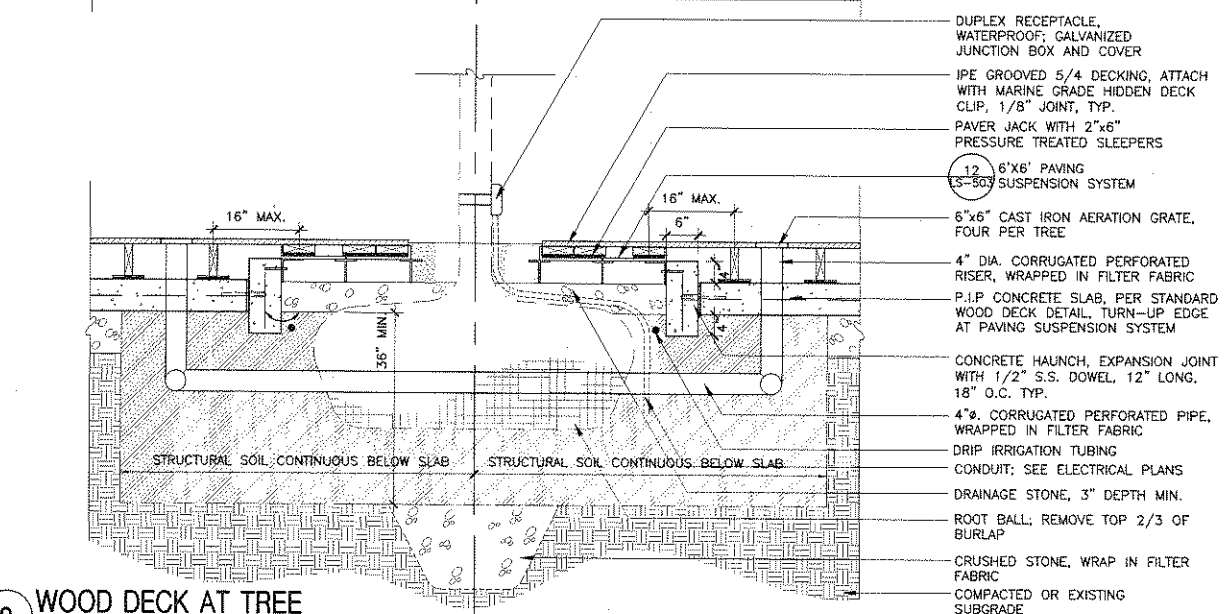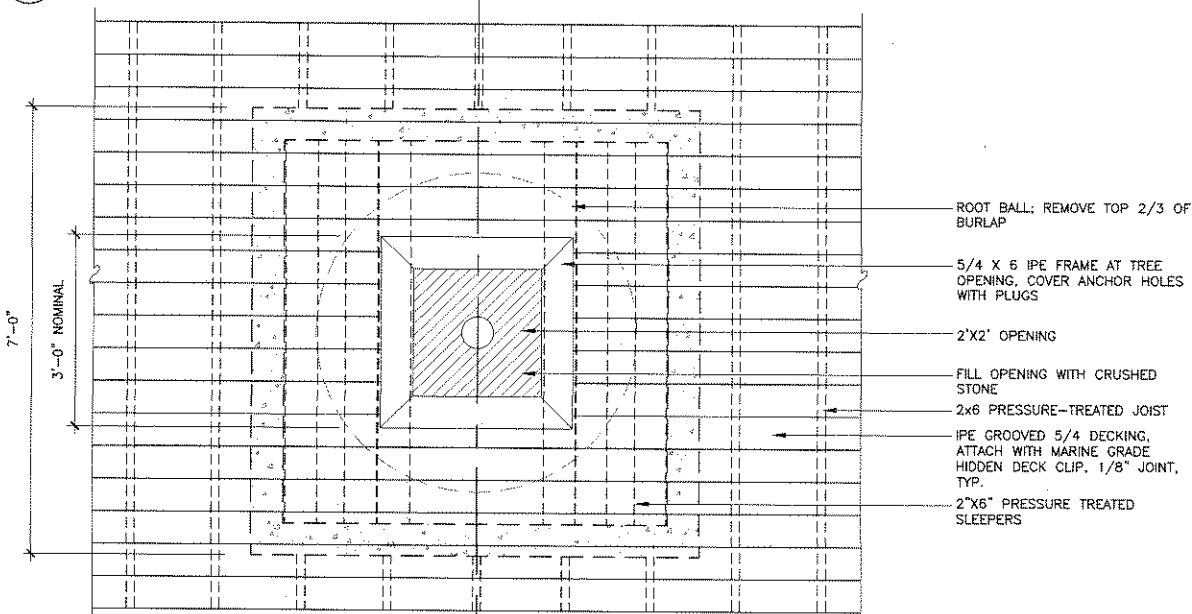

2 WOOD DECK AT TREE
SCALE: 3/4"=1'-0"

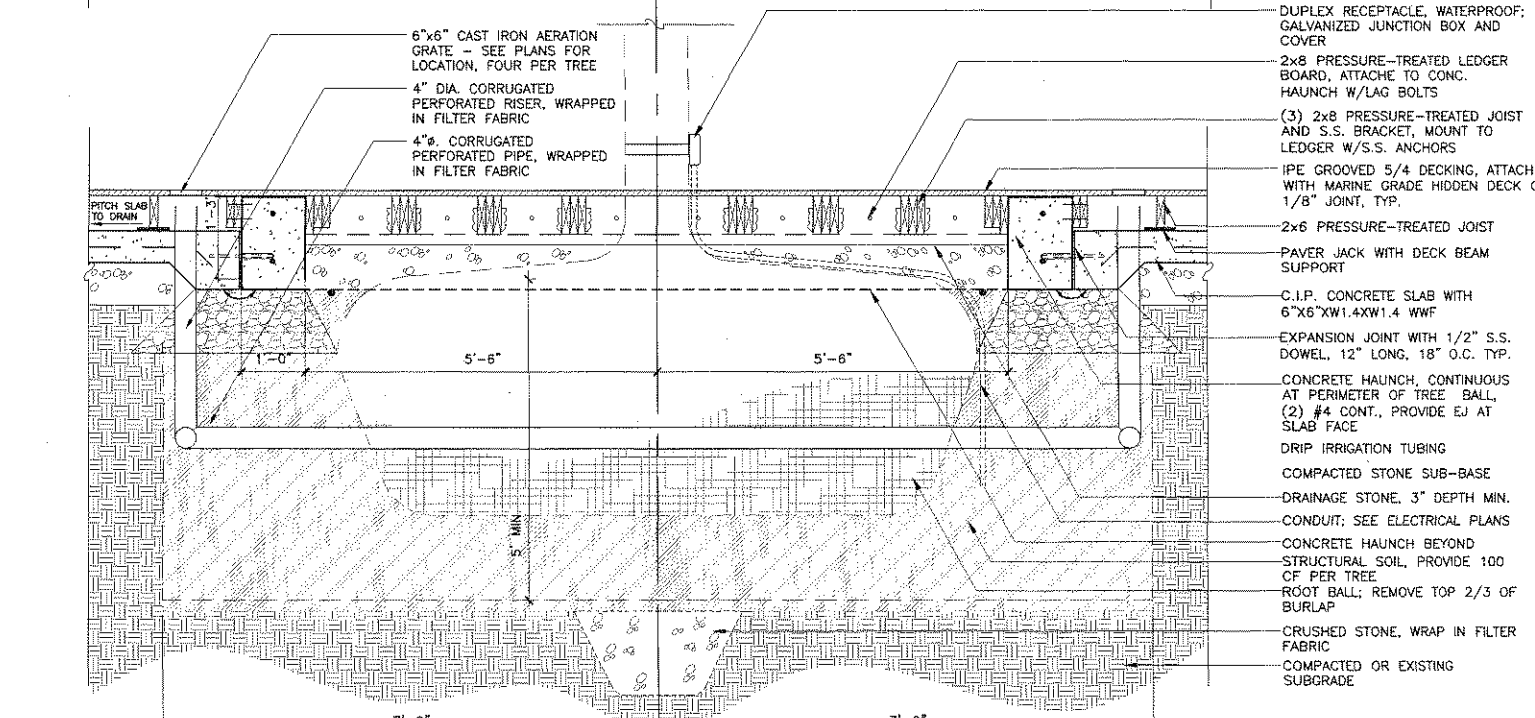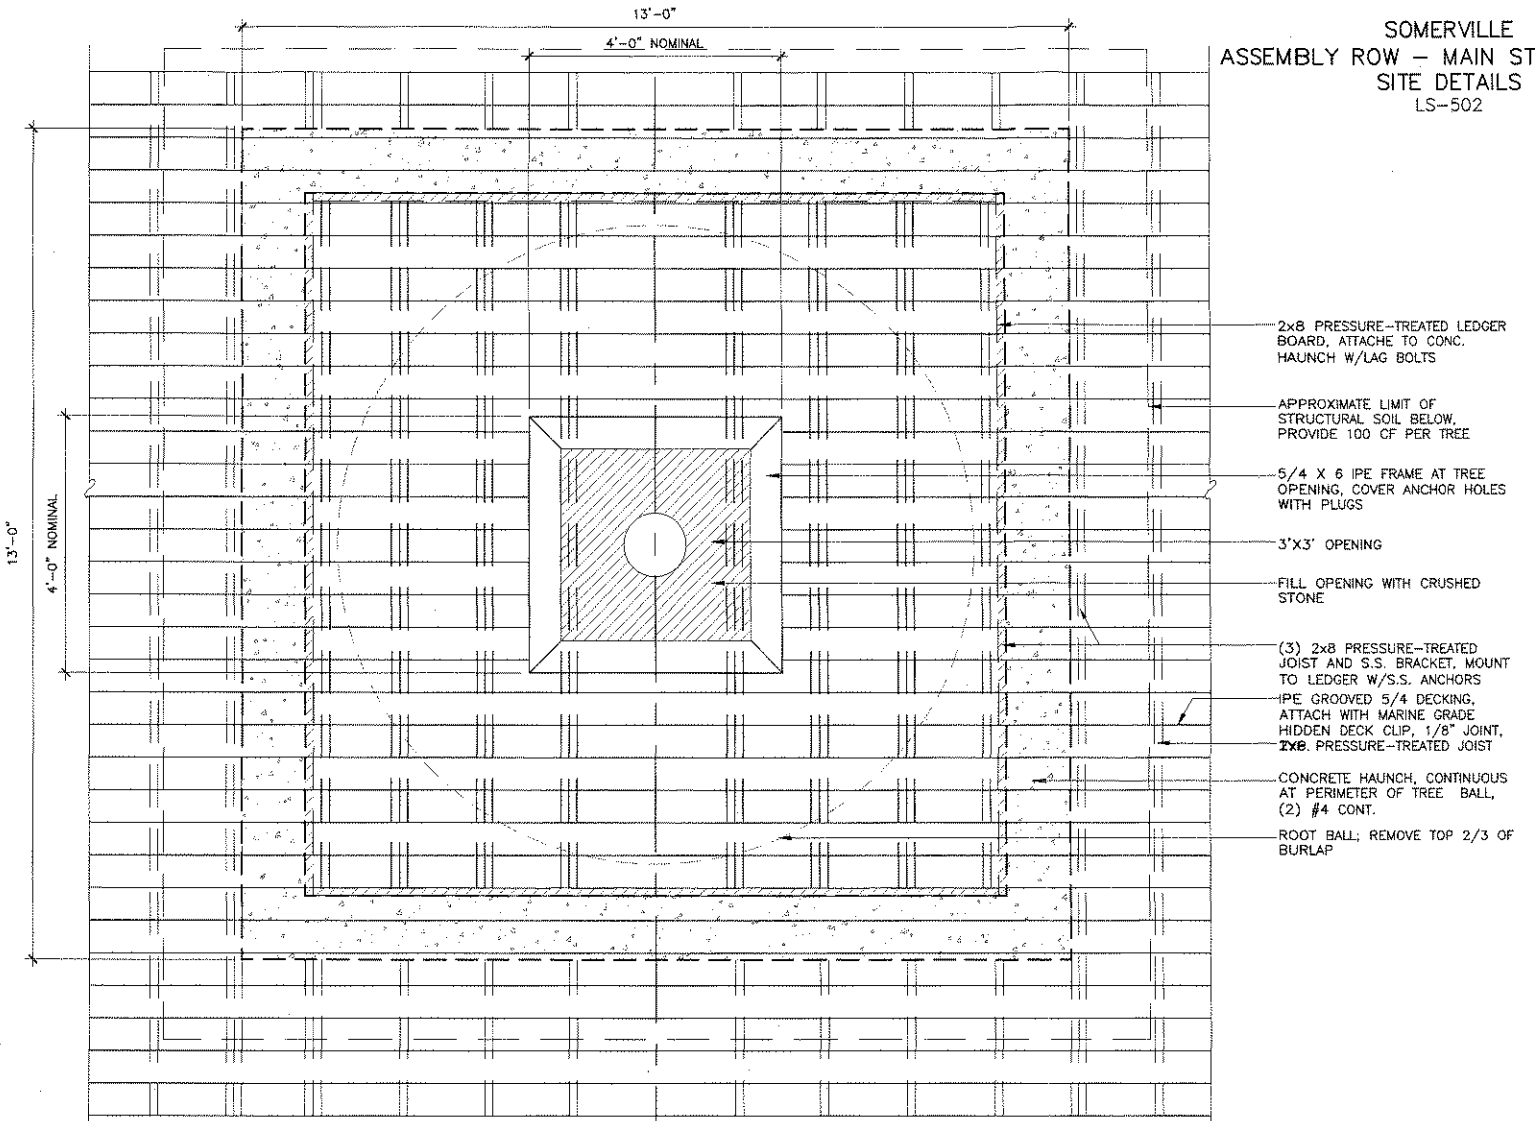


3 WOOD DECK AT SPECIMEN TREE
SCALE: 3/4"=1'-0"

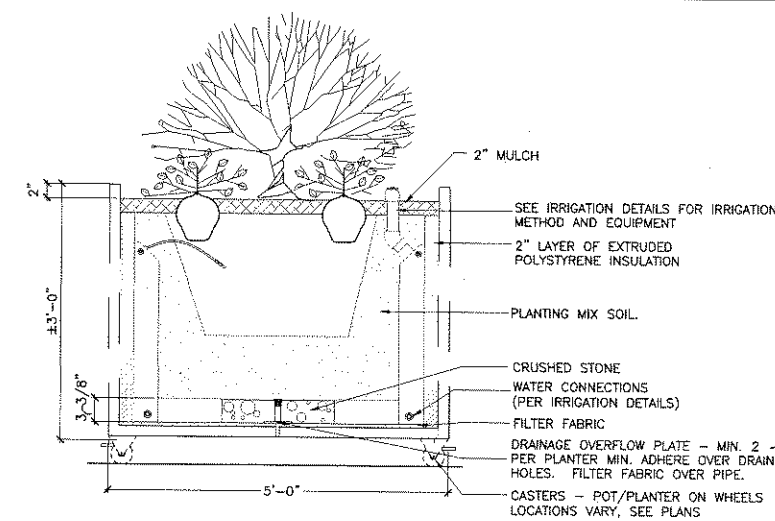


SECTION

1 POTS/PLANTER - TYPICAL INTERIOR PLANTING


SCALE: 1"=1'-0"

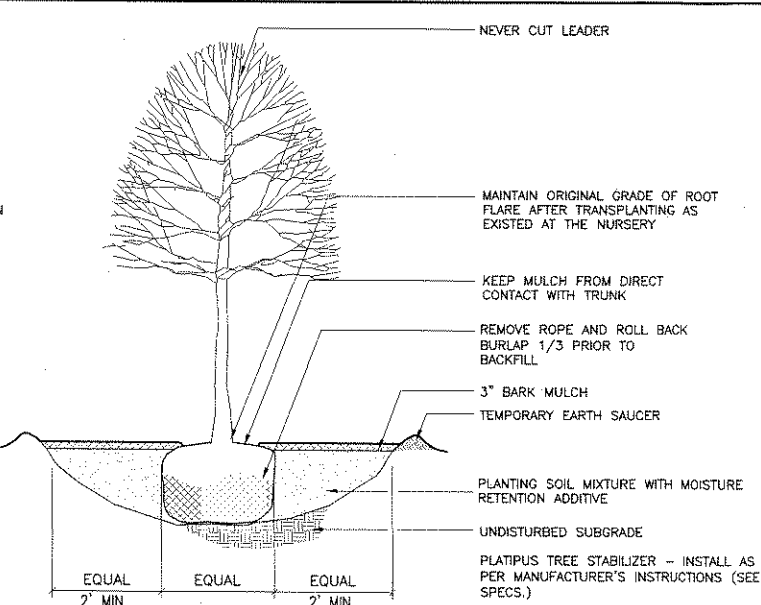


2 DECIDUOUS TREE PLANTING

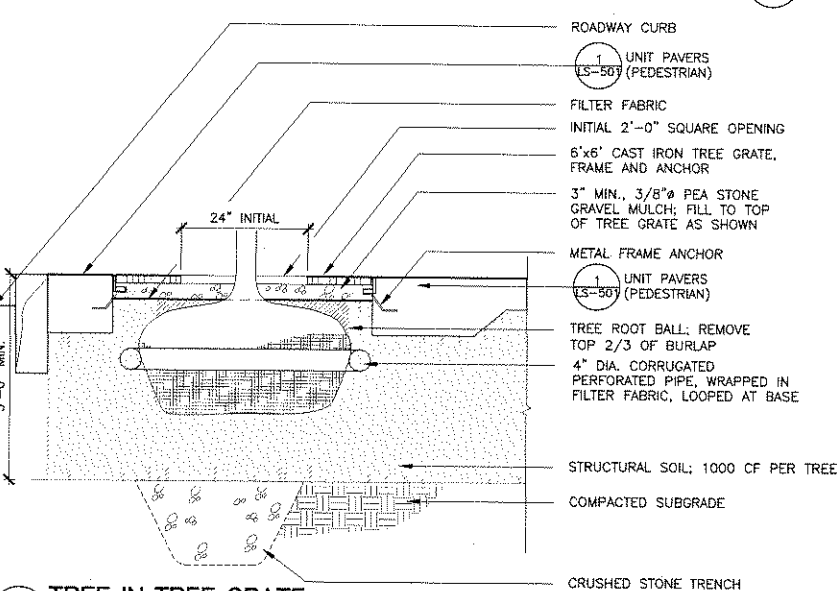


7 TREE IN TREE GRATE
SCALE: $\frac{3}{4}" = 1'-0"$

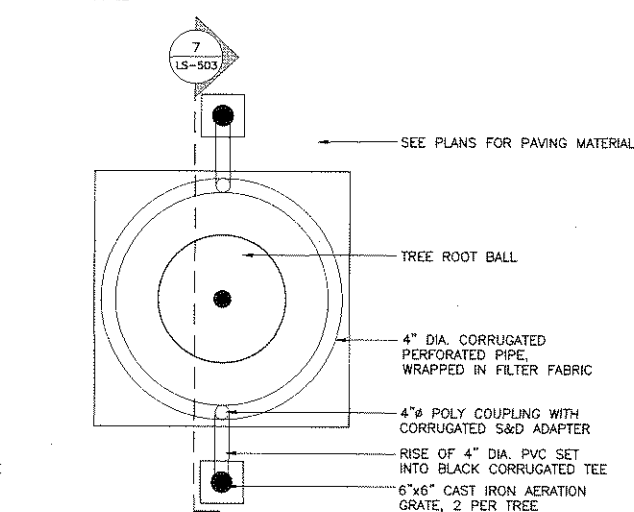


8 TREE AERATION (DIAGRAM PLAN)
SCALE: 1/2" = 1'-0"

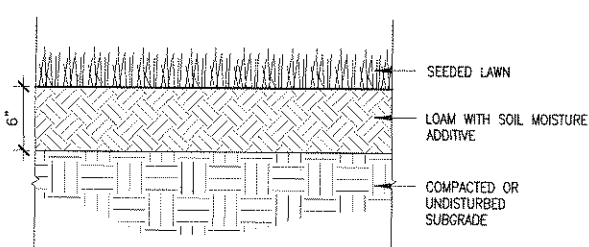


11 **LAWN ON LOAM**
SCALE: $1\text{--}1/2'' = 1'\text{--}0''$

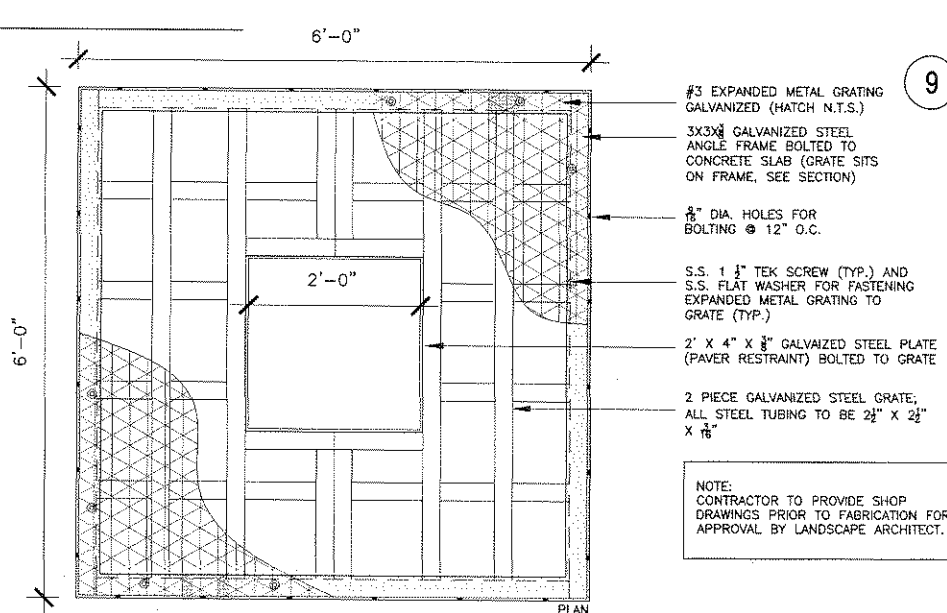


12 **6X6 PAVING SUSPENSION SYSTEM**
SCALE: 1" = 1'-0"

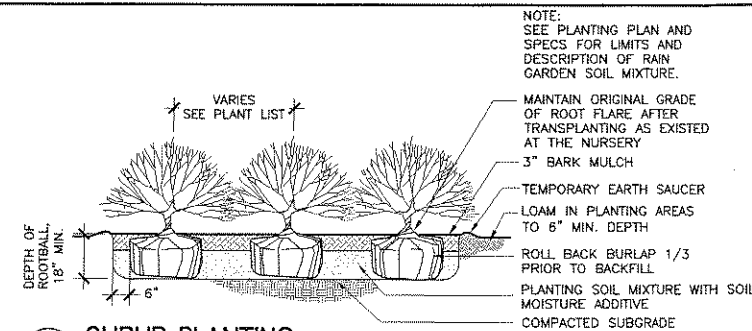


3 SHRUB PLANTING
SCALE: NOT TO SCALE

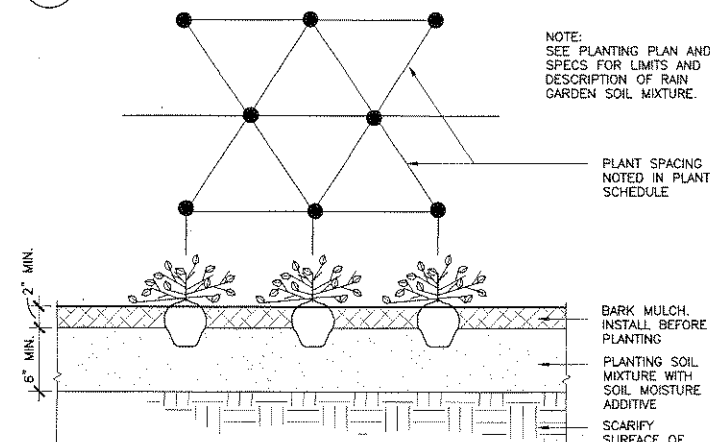


4 GROUND COVER/VINE PLANTING
NOT TO SCALE

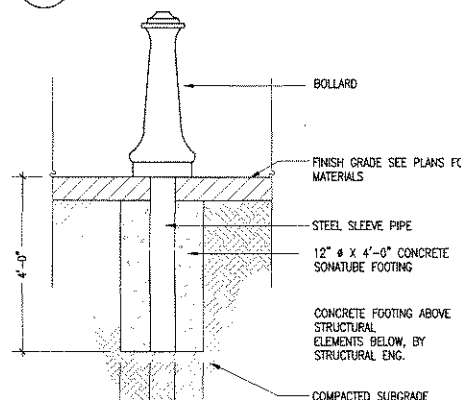


9 BOLLARD MOUNTING
SCALE: 1"=1'-0"

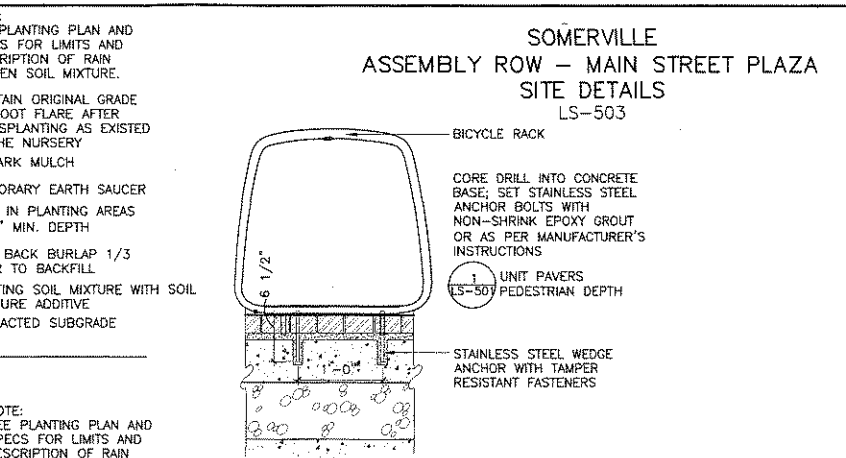

5 BICYCLE RACK MOUNTING
SCALE: 1" = 1'-0"

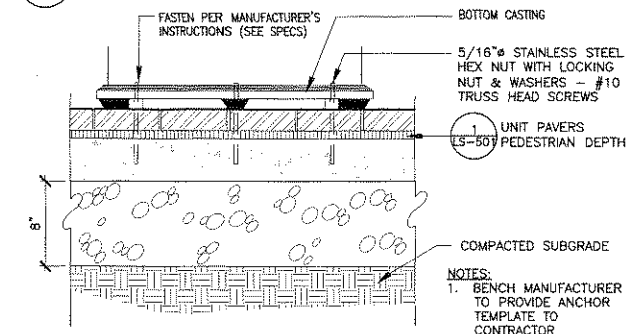


6 LITTER RECEPTACLE MOUNTING

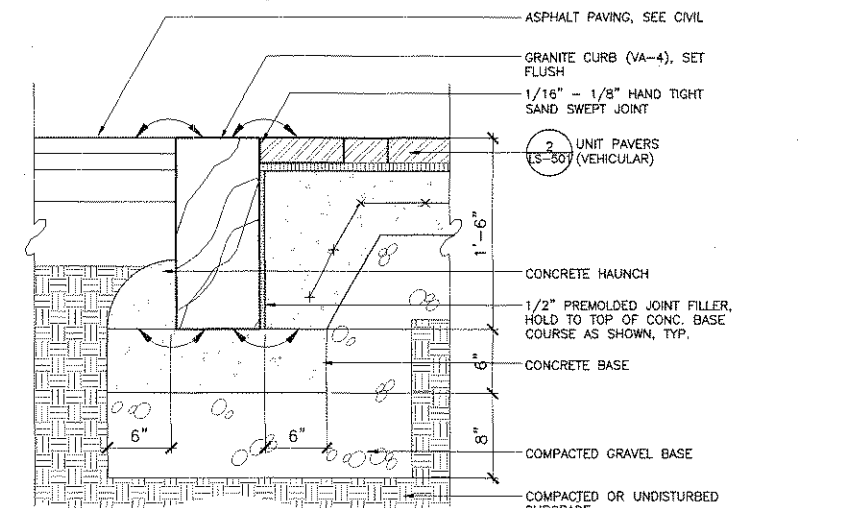


10 FLUSH GRANITE CURB AT PAVERS AND ASPHALT
SCALE: 1-1/2"=1'-0"

SOMERVILLE
ASSEMBLY ROW – MAIN STREET PLAZA
SITE DETAILS
LS-504

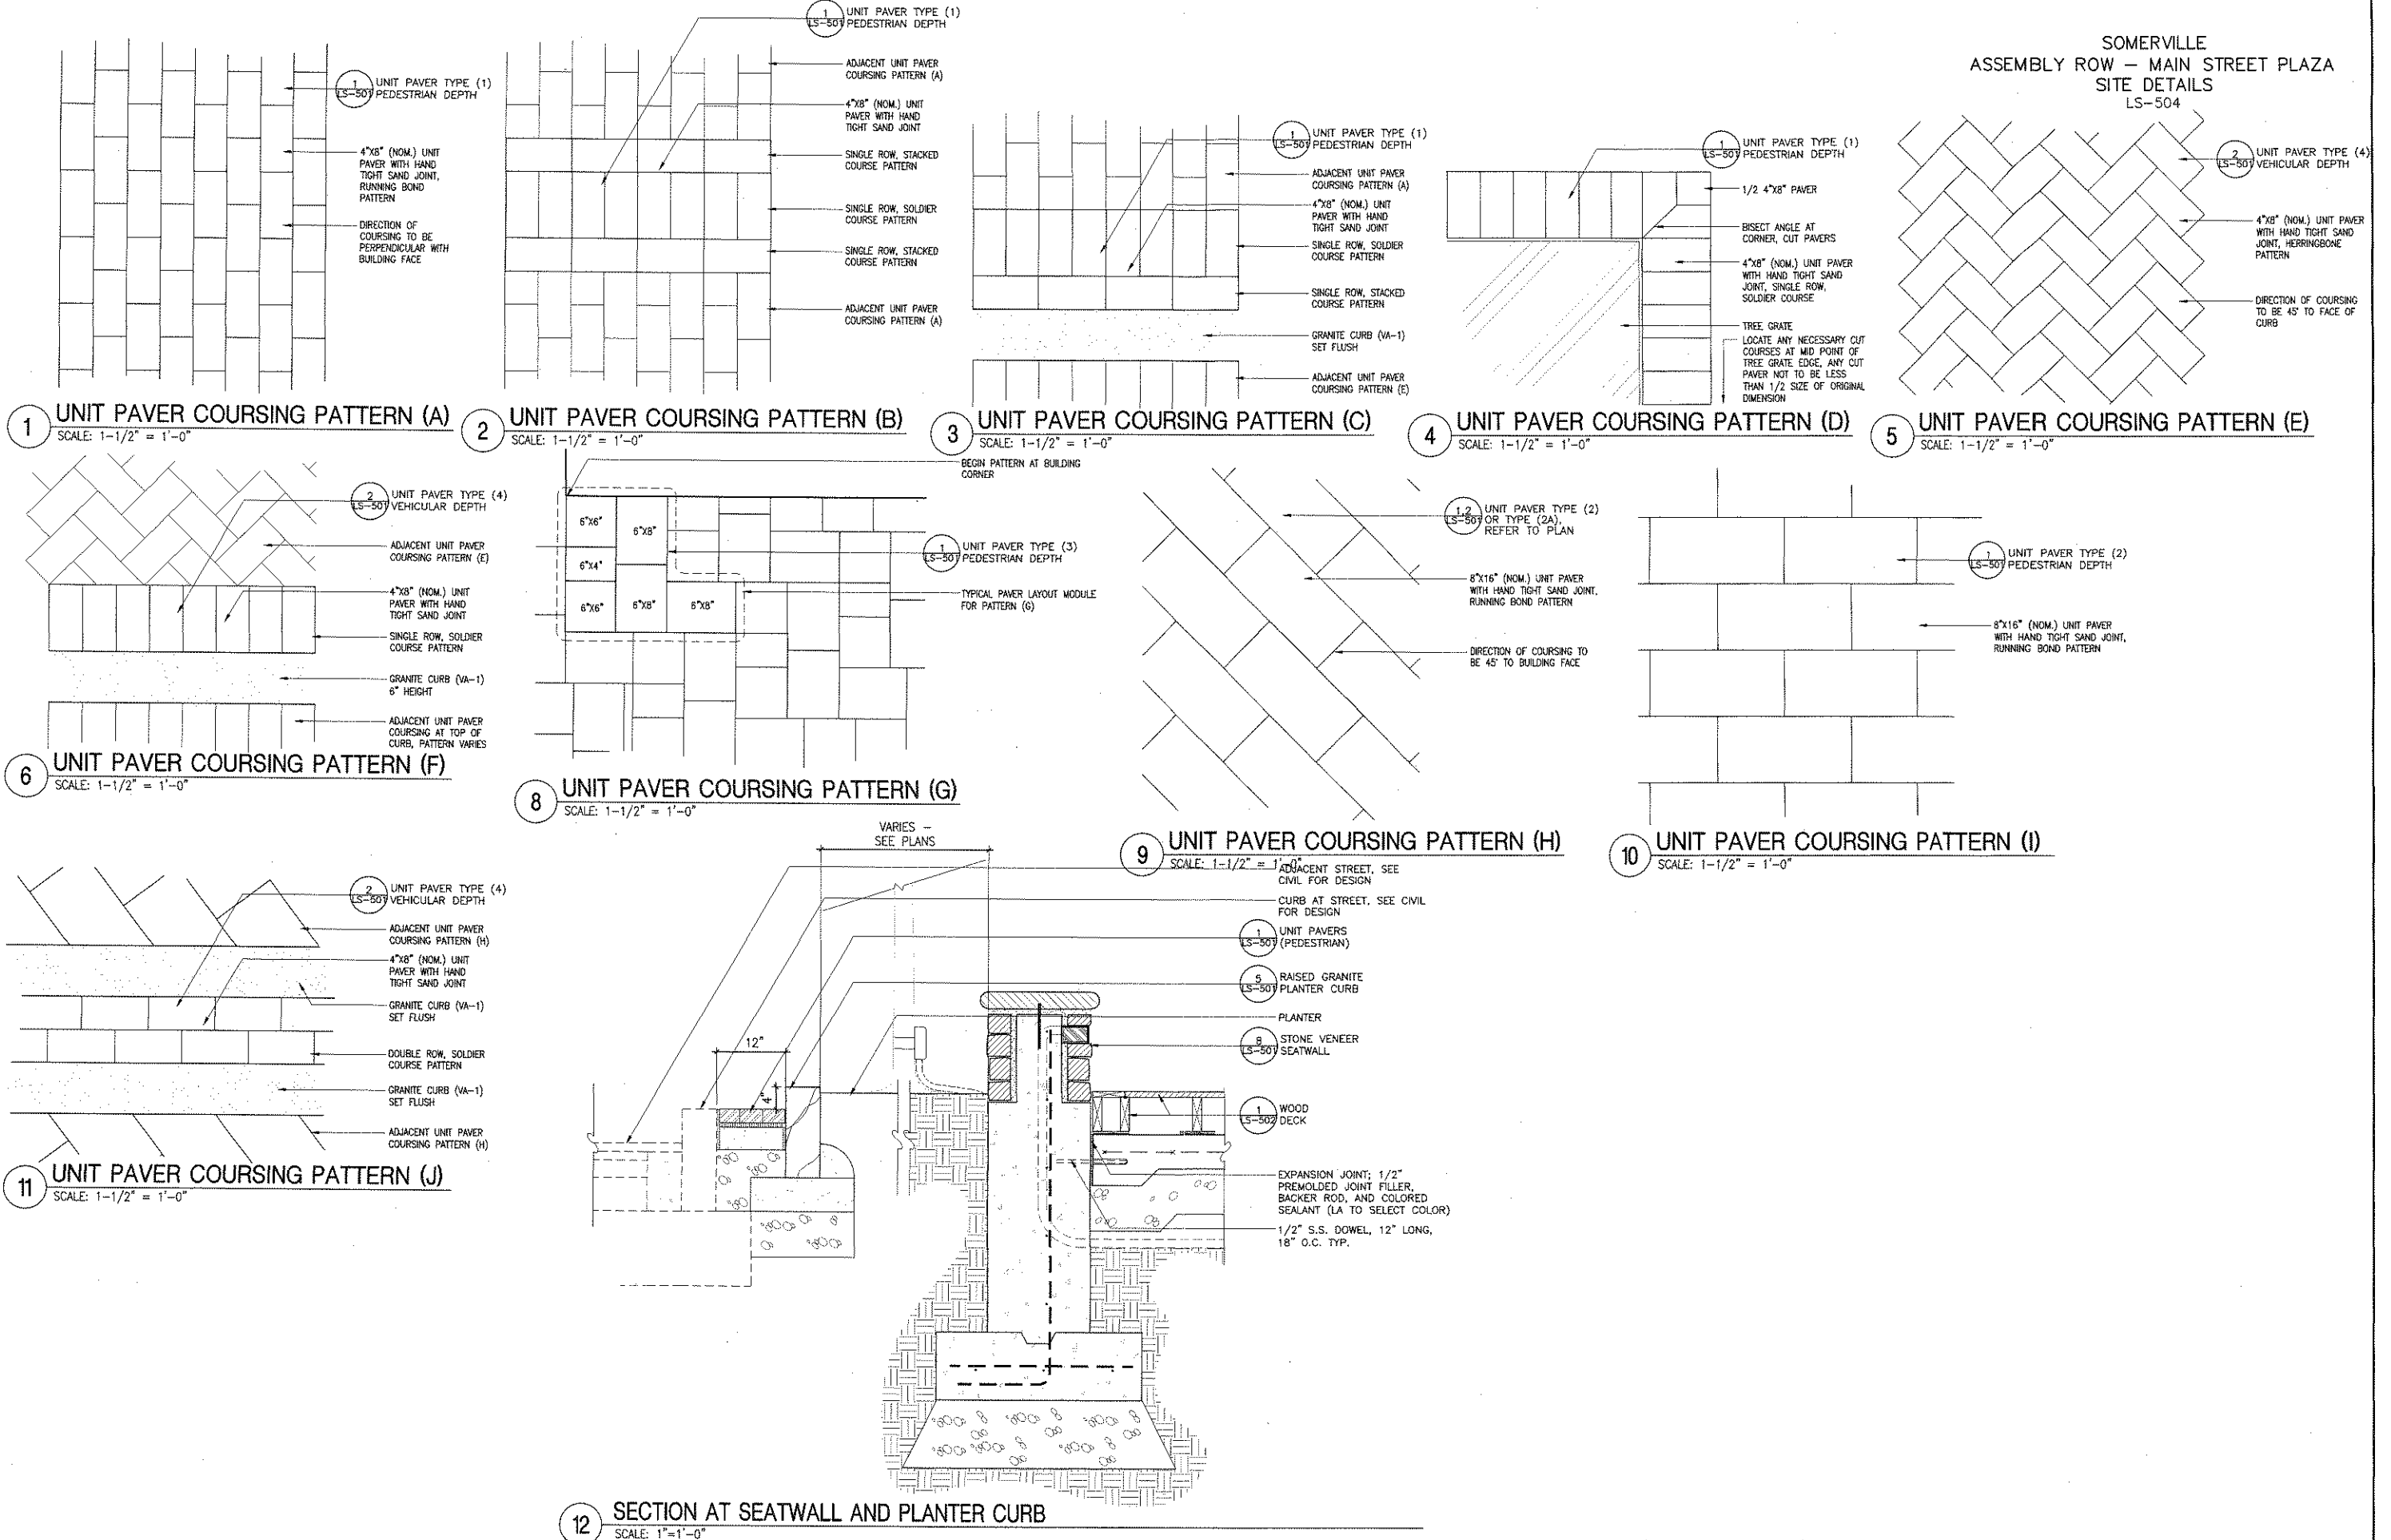

SOMERVILLE
 ASSEMBLY ROW — MAIN STREET PLAZA
 IRRIGATION PLAN
 IR-93


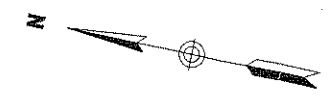


Indicates Valve Box Location (1 in planter and 1 in pavers for each pot). Valve Box to be Cast Iron, traffic grade type box mounted flush with paving in manner approved by Landscape Architect. Refer to Details below for more specifics on locations. Note that symbol is shown graphically for readability purposes. Actual location on paving/below planter to be pinpoint at site.



Main Street Plaza Irrigation Water Meter (3/4") and Backflow Prevention (1-1/2"); Irrigation Installation Contractor shall coordinate exact location of meter at site with Civil Plans. Block 5 Irrigation System requires 12 GPM @ 65 PSI at point of connection. Irrigation Installation Contractor shall verify system requirements at site before starting installation.

Irrigation Controller to be located inside of building. Coordinate exact location of controller with Owner's Representative (should be shown on MEP Plans). Installation contractor will install Controller and pull control/common wires from controller into landscape utilizing pullstring provided in conduit (installed by MEP Contractor).

2" Sch 40 Electrical Conduit installed with Sweep Elbows and (2) pullstrings by MEP Contractor. Exact routing of conduit to be specified on MEP Plans.

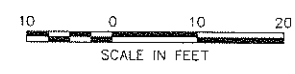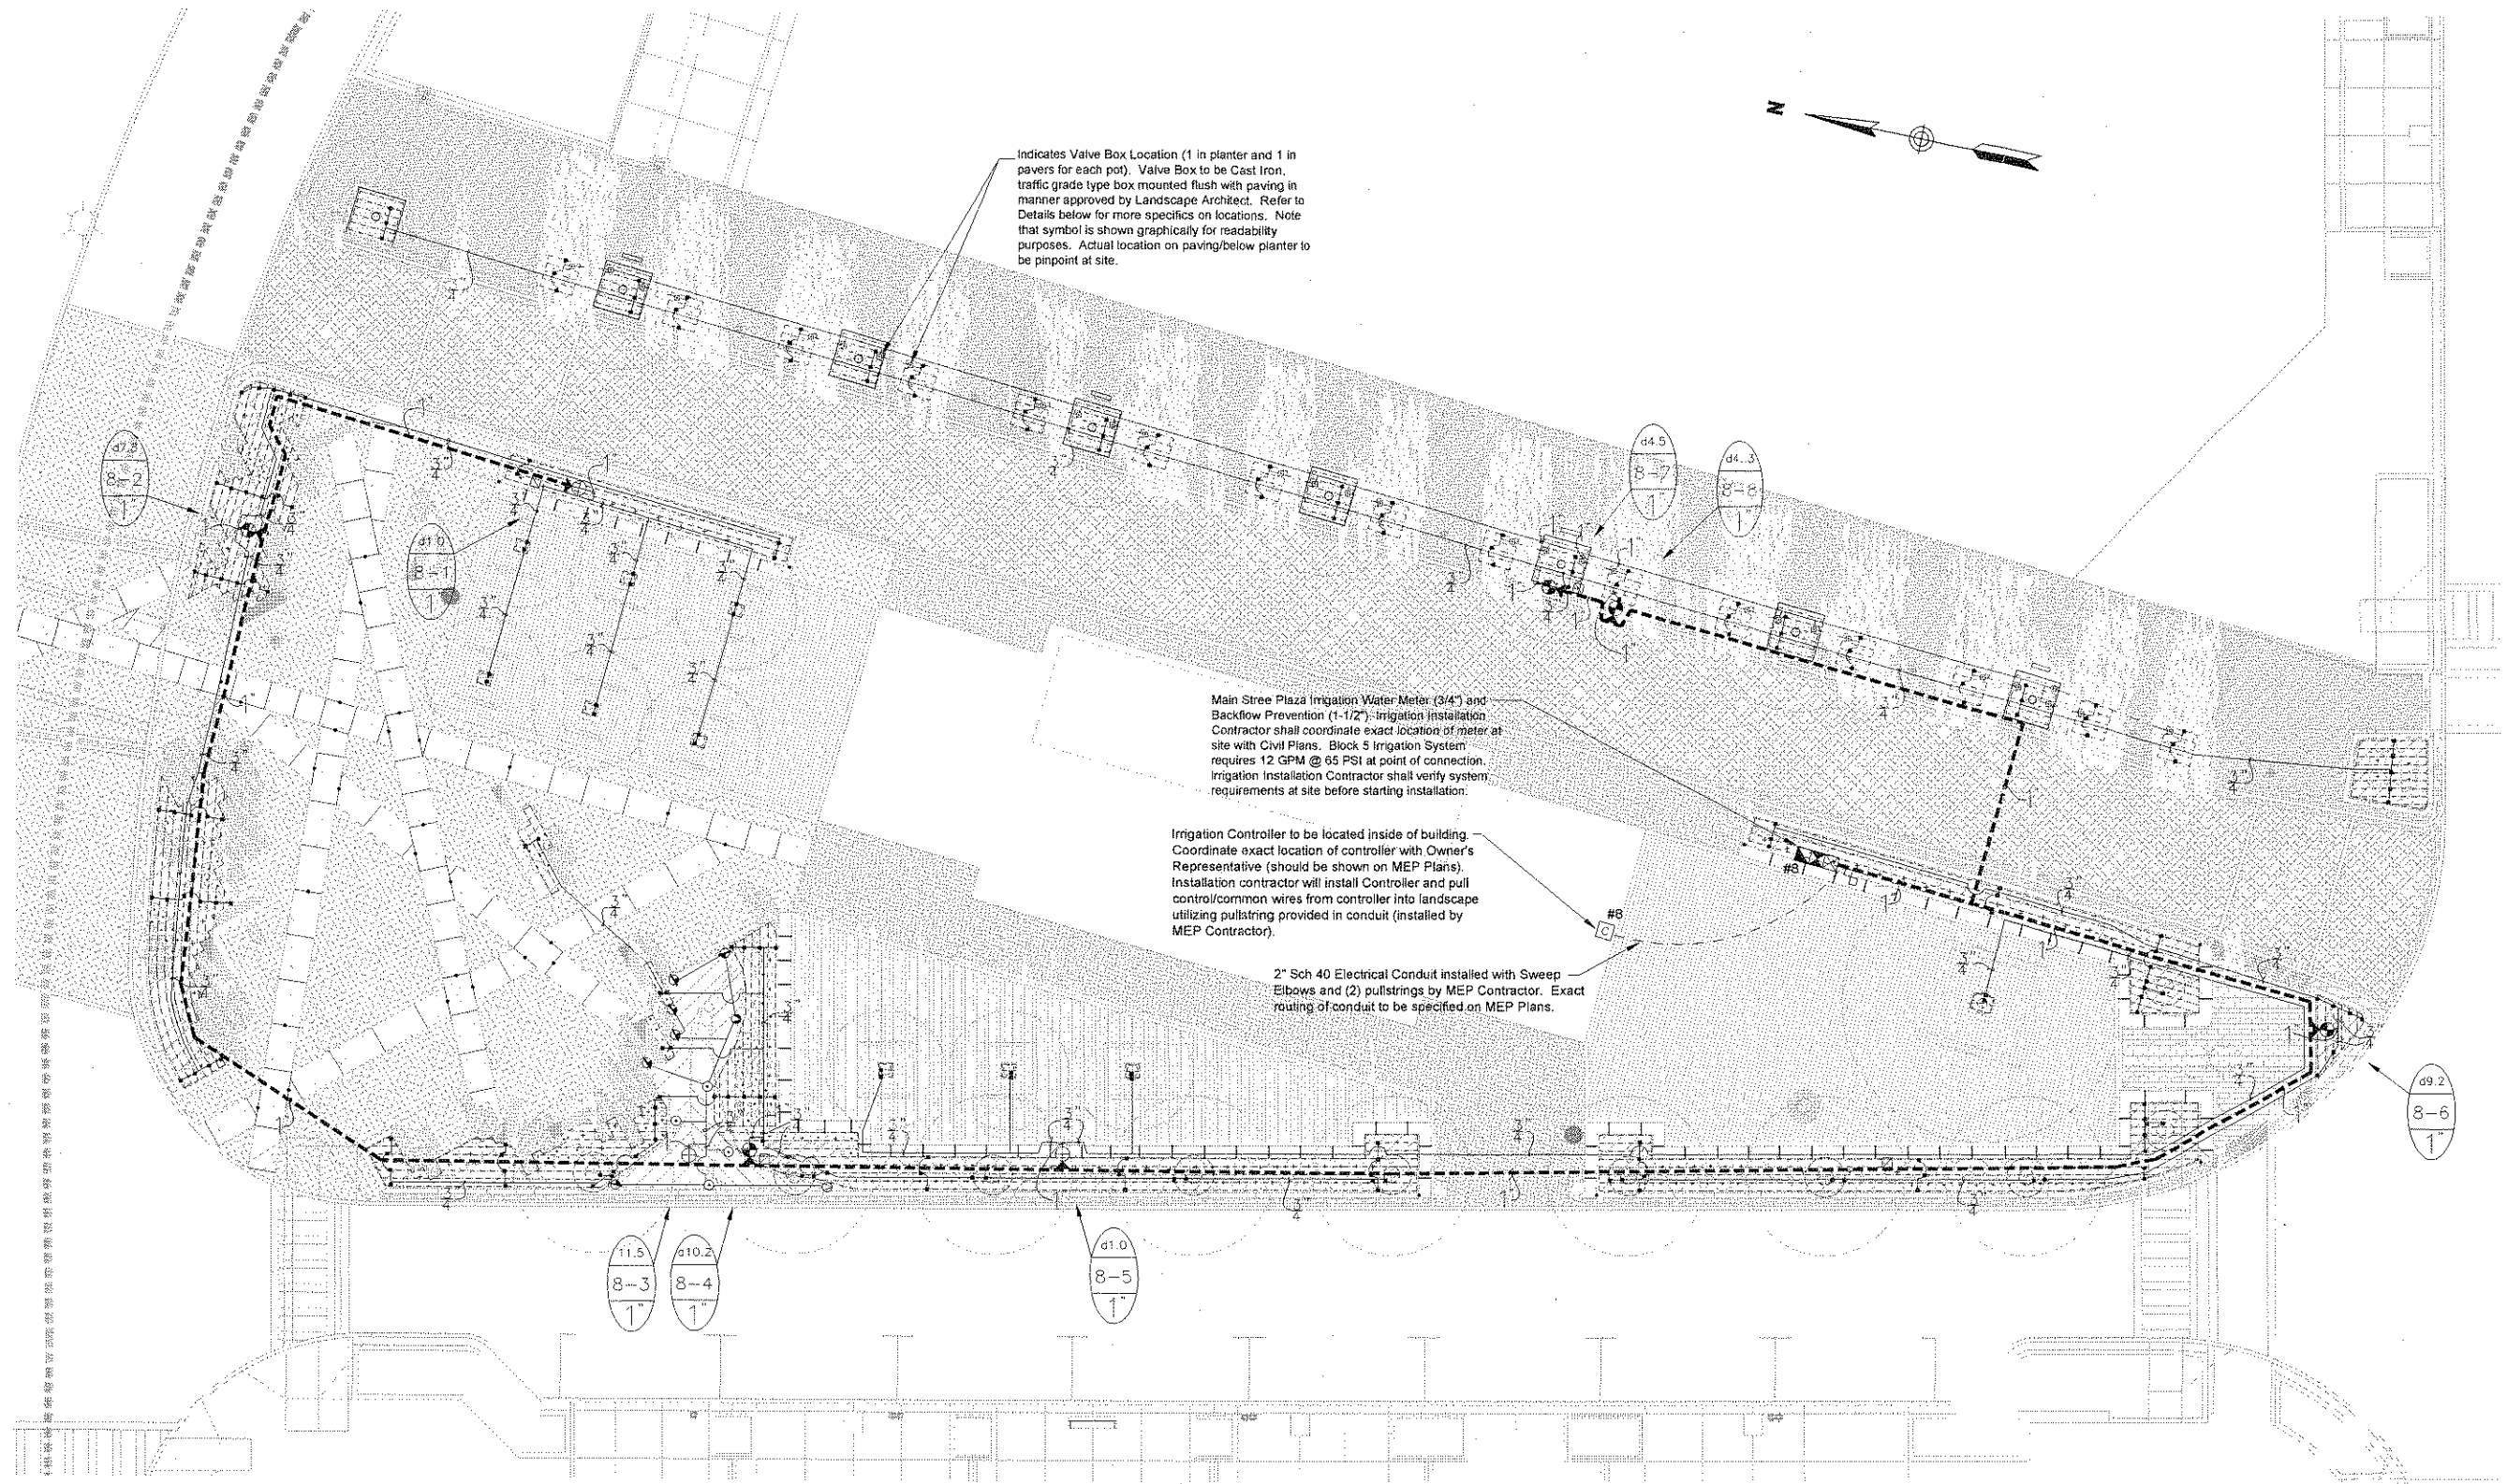



SOMERVILLE
ASSEMBLY ROW — MAIN STREET PLAZA
IRRIGATION SLEEVING PLAN
IR-94

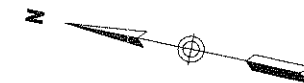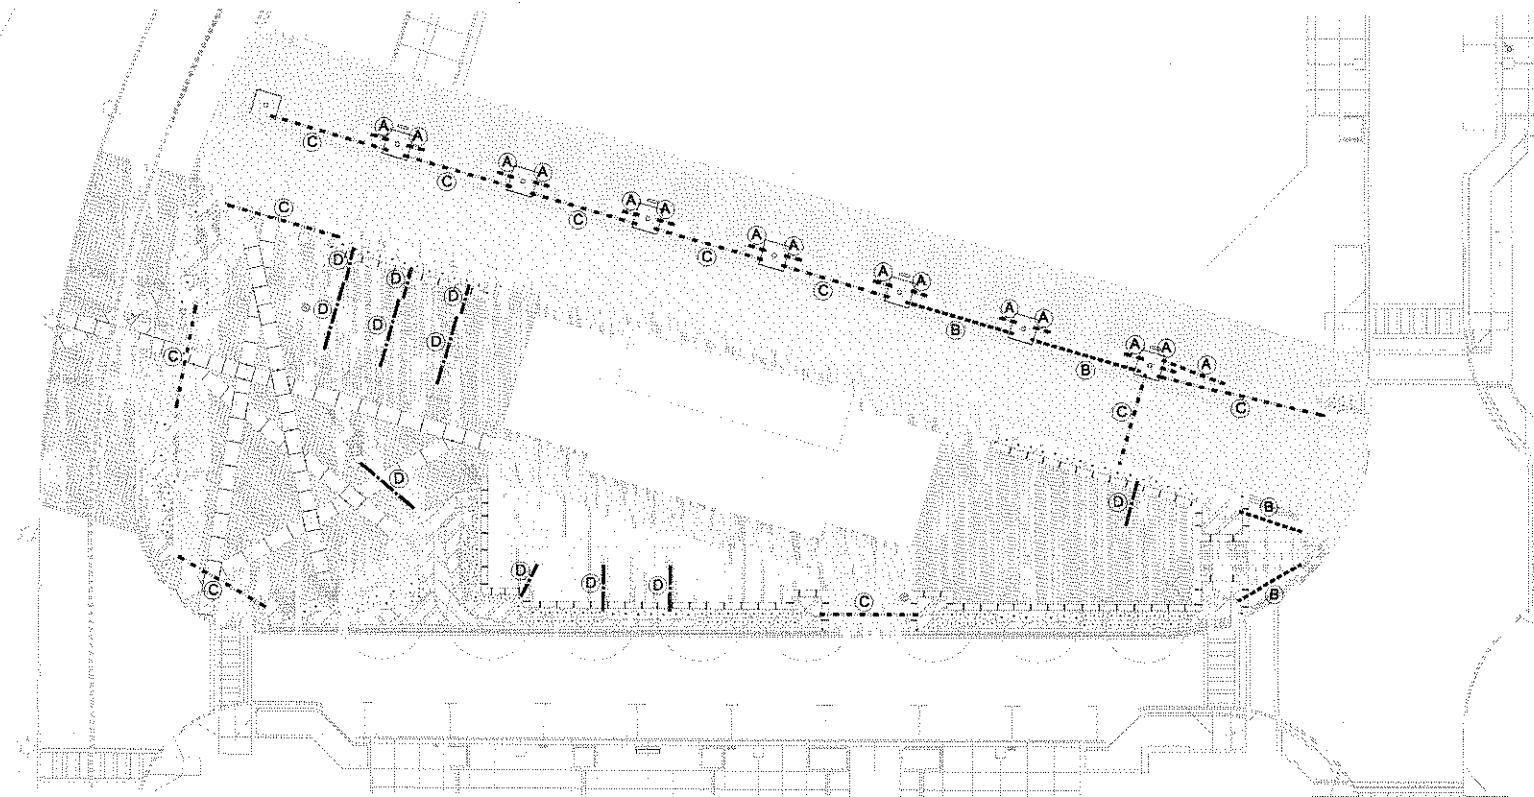

SLEEVING LEGEND

- (A) POT IRRIGATION SLEEVE
- (B) 6" CLASS 200 PVC IRRIGATION SLEEVE
- (C) 4" CLASS 200 PVC IRRIGATION SLEEVE
- (D) 3" CLASS 200 PVC IRRIGATION SLEEVE

NOTE: INSTALLER OF SLEEVES SHALL BE RESPONSIBLE TO LOCATE SLEEVES IF NOT PROPERLY INSTALLED.

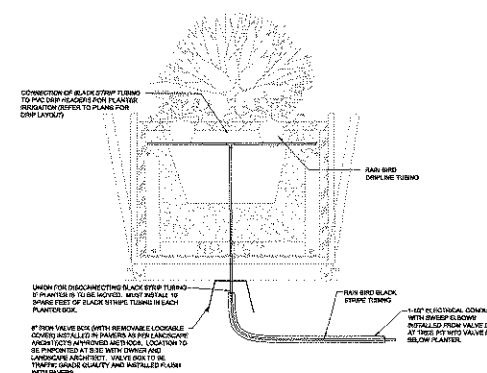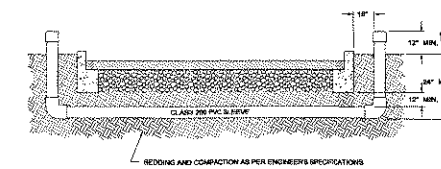


20 0 20 40
SCALE IN FEET

SOMERVILLE
ASSEMBLY ROW - MAIN STREET PLAZA
IRRIGATION DETAILS (1 OF 2)
IR-95


IRRIGATION LEGEND

- 3/4" WATER METER, SYSTEM REQUIRES 12 GPM @ 65 PSI. IRRIGATION CONTRACTOR SHALL BE RESPONSIBLE TO VERIFY THE SYSTEM REQUIREMENTS AT SITE BEFORE STARTING CONSTRUCTION. REFER TO CIVIL PLANS FOR EXACT LOCATION OF IRRIGATION WATER METER.
- #8 [Symbol] WATTS #007-M1-QT-11/2" 1-1/2" DOUBLE CHECK ASSEMBLY BACKFLOW PREVENTER. DETAIL-F.
- #8 [Symbol] MANUAL DRAIN VALVE SCH 80 PVC BALL VALVE. DETAIL-E.
- #8 [Symbol] WINTERIZATION ASSEMBLY. DETAIL-D.
- #8 [Symbol] RAIN BIRD ESP-12-LXME CONTROLLER: 12 STATION, MODULAR CONTROLLER, FOUR PROGRAMS, WALL MOUNTED. DETAIL-J. IRRIGATION CONTRACTOR SHALL ALSO INSTALL A WIRELESS MINI-CLK II RAIN SENSOR AND A FREEZE-CLK DEVICE FOR EACH CONTROLLER.
- NOTES:
1. IRRIGATION INSTALLATION CONTRACTOR MUST COORDINATE EXACT LOCATION OF CONTROLLERS AT SITE WITH OWNER'S REPRESENTATIVE.
2. IF WIRELESS SIGNAL CANNOT REACH CONTROLLERS, WIRED RAIN/FREEZE SENSOR MUST BE UTILIZED.
- [Symbol] RAIN BIRD 150-PEB OR 200-PEB PLASTIC ELECTRIC REMOTE CONTROL VALVE, 1 1/2" OR 2" SIZE, MOUNTED WITH SCH 80 PVC BALL VALVE. DETAIL-A.
- [Symbol] RAIN BIRD 100-PEB PLASTIC ELECTRIC REMOTE CONTROL VALVE, 1" SIZE, MOUNTED WITH SCH 80 PVC BALL VALVE. DETAIL-A.
- [Symbol] RAIN BIRD 1806-SAM, 6" POP-UP LAWN SPRAY SPRINKLER, 12" RADIUS, FULL-2.0 GPM, HALF-1.0 GPM, QUARTER-0.5 GPM, 30 PSI. DETAIL-C.
- [Symbol] RAIN BIRD 1806-SAM, 6" POP-UP LAWN SPRAY SPRINKLER, 15" RADIUS, FULL-4.0 GPM, HALF-2.0 GPM, QUARTER-1.0 GPM, 30 PSI. DETAIL-C.
- [Symbol] RAIN BIRD 1806-SAM, 6" LAWN POP-UP SIDE STRIP SPRAY SPRINKLER, 9' X 18' RADIUS, 1.5 GPM, 30 PSI. DETAIL-C.
- [Symbol] RAIN BIRD 1806-SAM, 6" LAWN SIDE STRIP SPRAY SPRINKLER, 4' X 30' RADIUS, 1.5 GPM, 30 PSI. DETAIL-C.
- [Symbol] RAIN BIRD 1806-SAM, 6" LAWN END STRIP SPRAY SPRINKLER, 4' X 15' RADIUS, 1.0 GPM, 30 PSI. DETAIL-C.
- [Symbol] RAIN BIRD 1806-SAM WITH 1404 BUBBLER NOZZLE AND PA-80 ADAPTER 6" POP-UP TREE BUBBLER, 1.0 GPM. DETAIL-C.
- [Symbol] HUNTER INDUSTRIES MP ROTATOR SERIES 3000, MOUNTED ON RAIN BIRD 1806-SAM SPRINKLER IN LAWN, 30' RADIUS, FULL-4.0 GPM, HALF-2.0 GPM, QUARTER-1.0 GPM, 40 PSI, DETAIL-C.
- [Symbol] HUNTER INDUSTRIES MP ROTATOR SERIES 2000, MOUNTED ON RAIN BIRD 1806-SAM SPRINKLER IN LAWN, 20' RADIUS, FULL-2.0 GPM, HALF-1.0 GPM, QUARTER-0.5 GPM, 40 PSI, DETAIL-C.
- [Symbol] RAIN BIRD #5 QUICK COUPLING VALVE 1" SIZE. CONTRACTOR TO SUPPLY TWO QCV KEYS AND MATCHING HOSE SWIVELS. DETAIL-B.
- [Symbol] SCH 80 PVC BALL VALVE, SIZED SAME AS MAINLINE, MOUNTED IN CARSON VALVE BOX. DETAIL-G.
- [Symbol] RAIN BIRD DRIP ZONE ASSEMBLY KIT, MODEL #XCZ-100-PRB-COM OR XCZ-150-PRB-COM. 1" OR 1-1/2" SIZE, SIZE NOTED ON PLANS. DETAIL-L.
- [Symbol] RAIN BIRD DRIP ZONE ASSEMBLY KIT, MODEL #XCZ-LF-100-PRF LOW FLOW (0-3 GPM) VALVE. 1" SIZE. DETAIL-L.
- [Symbol] POINT OF CONNECTION - DRIP LINE TUBING TO PVC PIPE, DETAIL-M,N.
- [Symbol] IRRIGATION CONNECTION POINT/VALVE BOX FROM PVC PIPE TO FLEXIBLE PIPE/TUBING. REFER TO NOTES/DETAILS ON PLANS.
- [Symbol] DRIP TUBING: RAIN BIRD XFS DRIPLINE DRIP TUBING, .6 GPH, 12" CENTERS, STAKED EVERY TURN OR EVERY 4', INSTALL RAIN BIRD AIR RELIEF VALVE KIT IN 6" CIRCULAR VALVE BOX AT HIGH POINT OF ZONE. DETAIL-M,N,P,Q,R.
- [Symbol] TREE DRIP TUBING: RAIN BIRD XFS DRIPLINE DRIP TUBING, .6 GPH, 12" CENTERS, STAKED EVERY TURN OR EVERY 4', INSTALL RAIN BIRD AIR RELIEF VALVE KIT IN 6" CIRCULAR VALVE BOX AT HIGH POINT OF ZONE. DETAIL-M,N,P,Q,R.
- [Symbol] MAINLINE PIPE: 1" SIZE IF NOT NOTED. CLASS 200 PVC.
- [Symbol] IRRIGATION SLEEVE: CLASS 200 PVC, REFER TO SLEEVING PLANS. DETAIL-H.
- [Symbol] LATERAL LINE PIPE: CLASS 200 PVC, SIZE NOTED.
- [Symbol] 2" ELECTRICAL CONDUIT SLEEVE.

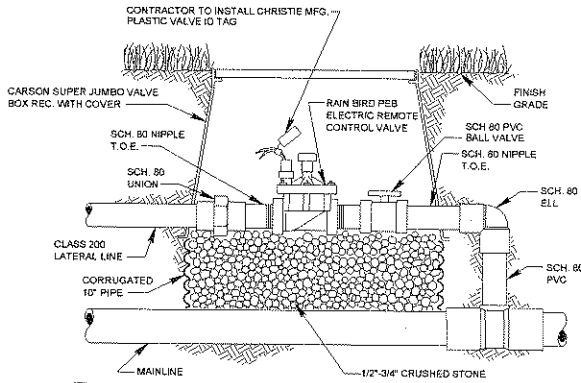


A CONTROL VALVE

NTS

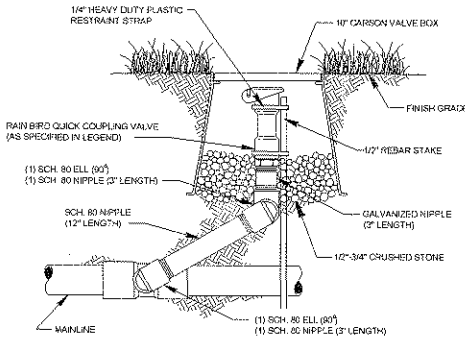


B QUICK COUPLING VALVE

NTS

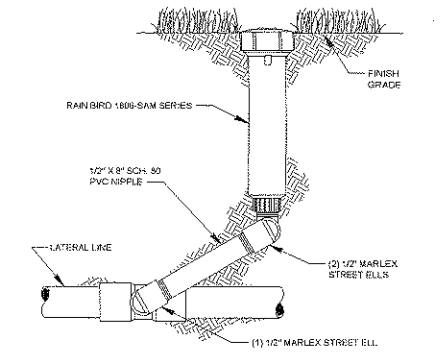

C LAWN SPRAY

NTS

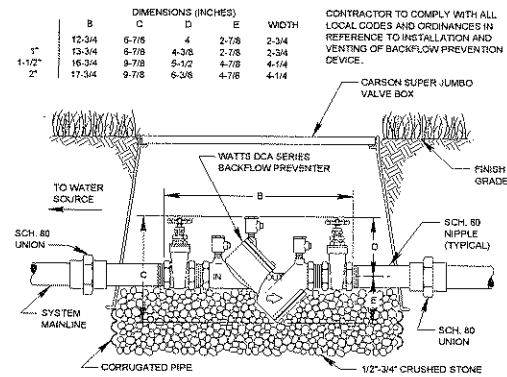

F BACKFLOW PREVENTER

NTS

* IRRIGATION CONTRACTOR SHALL SUBMIT BACKFLOW DETAIL TO LOCAL AUTHORITIES FOR APPROVAL BEFORE STARTING CONSTRUCTION.


GENERAL NOTES

- ALL MAINLINES TO HAVE A MINIMUM OF 18" OF COVER. (CLASS 200 PVC PIPE).
- ALL LATERAL AND SUB-MAIN PIPE TO HAVE A MINIMUM OF 12" OF COVER. (CLASS 200 PVC PIPE).
- NO ROCKS, BOULDER, OR OTHER EXTRANEIOUS MATERIALS TO BE USED IN BACKFILLING OF TRENCH.
- ALL PIPE TO BE INSTALLED AS PER MANUFACTURERS' SPECIFICATIONS.
- ALL THREADED JOINTS TO BE COATED WITH TEFLON TAPE OR LIQUID TEFLON.
- ALL LINES TO BE THOROUGHLY FLUSHED BEFORE INSTALLATION OF SPRINKLER HEADS.
- SPRINKLER AND RELATED EQUIPMENT TO BE INSTALLED AS PER DETAILS.
- ALL ELECTRICAL JOINTS TO BE MADE USING WATERPROOF CONNECTIONS AS SHOWN ON DETAILS.
- ALL EQUIPMENT NOT SPECIFIED IN THE LEGEND SHALL BE DETERMINED AND FURNISHED BY THE CONTRACTOR.
- NO ELECTRICAL CONNECTIONS SHALL BE MADE IN THE FIELD EXCEPT AT A VALVE CONTROL BOX OR ANOTHER VALVE BOX SPECIFICALLY FOR CONNECTIONS.
- ANY DISCREPANCY BETWEEN THIS SHEET AND OTHERS IN THIS SET MUST BE REFERRED TO THE IRRIGATION CONSULTANT BY THE CONTRACTOR FOR CLARIFICATION BEFORE PRECEEDING WITH THE WORK.
- ALL 24 VOLT WIRE SHALL BE #12 UFUL FOR COMMON WIRE, AND #14 UFUL FOR CONTROL WIRES. DIRECT BURIAL, SOLID COPPER.
- CONTRACTOR TO BE RESPONSIBLE FOR PROPER COVERAGE OF AREAS TO BE WATERED, I.E. ADJUST HEADS WITH INSUFFICIENT COVERAGE DUE TO BLOCKAGE BY EXISTING OR PROPOSED SITE FEATURES.
- CONTRACTOR TO REFER TO LANDSCAPE PLAN TO KEEP SPRINKLER EQUIPMENT AND ACCESSORY MATERIAL FROM INTERFERING WITH PROPER PLANTING, I.E. VERIFY ROOT BALL SIZE FOR PLANTING.
- CONTRACTOR SHALL PROVIDE EXPANSION COILS AT EACH WIRE CONNECTION IN VALVE BOX (WRAP AROUND 3/4" PIPE 12 TIMES).
- CONTRACTOR TO UTILIZE APPROPRIATE AUTOMATIC DRAIN DEVICE WHERE LOW HEAD DRAINAGE MAY OCCUR.
- ALL SPRINKLERS TO BE MOUNTED ON SWING JOINTS - REFER TO DETAILS.
- CONTRACTOR SHALL UTILIZE VALVE I.D. TAGS ON ALL REMOTE CONTROL VALVES.
- 24 VOLT WIRE SHALL BE COLOR CODED: COMMON-WHITE, CONTROL-RED.
- CONTRACTOR SHALL INSTALL MANUFACTURERS' RECOMMENDED GROUNDING EQUIPMENT FOR POWER SUPPLY AND VALVE OUTPUT WITH (2) 5/8" COPPER CLAD GROUND RODS.
- CONTRACTOR SHALL INSTALL MANUFACTURERS' RECOMMENDATION ON FAULT GROUND AND LIGHTNING PROTECTION.
- ALL MATERIAL TO BE SUPPLIED BY CONTRACTOR TO OWNER.
 - TWO WRENCHES FOR DISASSEMBLING AND ADJUSTING EACH TYPE OF SPRINKLER HEADS AND VALVE SUPPLIED.
 - TWO KEYS FOR EACH OF THE AUTOMATIC CONTROLLERS.
 - TWO QUICK COUPLER KEYS WITH MATCHING HOSE SWIVELS.
- SYSTEM IS DIAGRAMMATIC TO IMPROVE CLARITY. ALL MAINLINE PIPING, ELECTRIC VALVES AND WIRING ARE TO BE INSTALLED IN LANDSCAPE AREAS AND WITHIN PROPERTY BOUNDARIES. CONTRACTOR SHALL REFERENCE THE LANDSCAPE PLAN PRIOR TO THE INSTALLATION OF PIPING TO AVOID CONTACT WITH PLANT MATERIALS EXISTING OR NEW.
- CONTRACTOR TO ADD EXTENSION RISER TO POP-UP HEADS WHEN NEEDED FOR PROPER COVERAGE.
- CONTRACTOR SHALL INSTALL SPRINKLER EQUIPMENT 12" FROM FOUNDATIONS. ALSO INSTALL SPRINKLERS 4" FROM CURB OR WALKS.
- PRIOR TO BID IRRIGATION CONTRACTOR SHALL VERIFY RIGHT-OF-WAY AND BACKFLOW REQUIREMENTS. NO LATER THAN FIVE DAYS BEFORE BID SUBMITTALS CONTRACTOR SHALL NOTIFY CONSULTANT OF ANY CHANGES FROM PLANS AND SPECIFICATIONS.
- IRRIGATION CONTRACTOR SHALL PROVIDE THE OWNER AND LANDSCAPE ARCHITECT WITH A REPRODUCIBLE CROSS MEASURED AS-BUILT DRAWING OF THE INSTALLED IRRIGATION SYSTEM IN AUTOCAD 2004 FORMAT BEFORE FINAL ACCEPTANCE.
- A 1-YEAR WARRANTY PERIOD SHALL BE PROVIDED FOR SYSTEM AFTER SUBSTANTIAL COMPLETION IS ACCEPTED. START UP AND ADJUSTING OF SYSTEM IN SPRING TIME SHALL BE INCLUDED IN WARRANTY.
- PRIOR TO BID, CONTRACTOR SHALL VERIFY THAT ALL MATERIALS, INSTALLATION PARAMETERS AND OPERATIONS CONFORM TO ALL APPLICABLE CODES AND ORDINANCES. NO LATER THAN FIVE DAYS BEFORE BID SUBMITTALS CONTRACTOR SHALL NOTIFY IRRIGATION CONSULTANT/DESIGNER OF ANY CHANGES REQUIRED DUE TO CURRENT CODE OR ORDINANCE DISCREPANCIES. IF CONTRACTOR DOES NOT COMPLY TO THIS NOTIFICATION, THE CONTRACTOR SHALL BE RESPONSIBLE FOR ALL NECESSARY INSTALLATION CHANGE AND REDESIGN COSTS FOR NON-COMPLIANCE.

NOTES:

- ALL SPRINKLERS WILL BE MOUNTED ON (3) MARLEX STREET ELLS WITH A SCHED. 80 NIPPLE SIZE OF SPRINKLER INLET.
- CONTRACTOR TO UTILIZE A AUTOMATIC DRAIN CHECK VALVE DEVICE WHERE LOW HEAD DRAINAGE MAY OCCUR.
- ALL WIRE WILL BE COLOR CODED DIRECT BURIAL UL/UF WIRE: COMMON (WHITE) #12-1, CONTROL (RED) #14-1.
- ALL PIPING AND WIRING UNDER HARDTOPS WILL BE IN CLASS 200 PVC PIPE SLEEVE.

TYPICAL VALVE INDICATOR

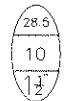




- GALLONS PER MIN.
- STATION NUMBER
- VALVE SIZE


NOTE:

1. ALL WIRING TO BE INSTALLED AS PER LOCAL CODE.
2. SEE CONTROLLER MANUAL FOR MOUNTING INSTRUCTIONS.
3. INSTALL ALL MANUFACTURER'S RECOMMENDED LIGHTNING PROTECTION AND GROUND ROD GRID.

Diagram labels and components:

 - RAIN BIRD CONTROLLER
- 6" CHANNEL ELECTRICAL CONNECTION BOX WITH TERMINAL BLOCK TO INTERFACE FIELD WIRING AND CONTROLLER LIGHTNING PROTECTION
- WALL
- CONDUIT
- CONTROL WIRES
- COMMON WIRE
- 120 VOLT POWER AND GROUND WIRES
- FLOOR
- UL DIRECT BURIAL WIRES (TO REMOTE FIELD CONTROL VALVES)
- FLASH ORAGE
- 6"

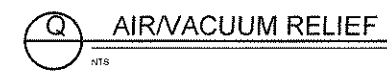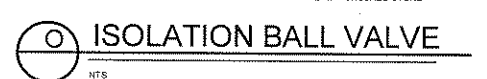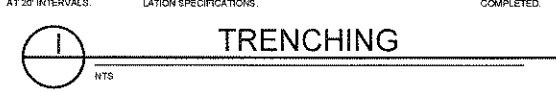



101 Walnut Street, P.O. Box 9151
Watertown, Massachusetts 02471-9151
617 924 1770 • FAX 617 924 2286

 DRAIN MANHOLE
 CATCH BASIN
 SEWER MANHOLE
 ELECTRIC MANHOLE
 TELEPHONE MANHOLE
 MANHOLE
 WATER GATE
 FIRE HYDRANT
 GAS GATE
 STREET SIGN
 LIGHT POLE
 UTILITY POLE
 GUY POLE
 GUY WIRE
 MONITORING WELL
 FLOOD LIGHT
 WELL
 CNO COULD NOT OPEN
 NEW NO PIPES VISIBLE.

TOP ——— EDGE OF PAVEMENT
 EC - - - - - CONCRETE CURB
 VSC ——— v ——— VERTICAL GRANITE CURB
 GSE ——— g ——— SLOPED GRANITE CURB
 R ——— r ——— BITUMINOUS BERM
 GR ——— g r ——— BITUMINOUS CURB
 CLF ——— o ——— GUARD RAIL
 DL ——— x ——— CHAIN LINK FENCE
 SWL ——— s ——— DRAINAGE LINE
 OW ——— o ——— SEWER LINE
 OW ——— o ——— OVERHEAD WIRE
 E ——— e ——— UNDERGROUND ELECTRIC
 T ——— t ——— TELEPHONE LINE
 G ——— g ——— GAS LINE
 W ——— w ——— WATER LINE
 TW ——— t w ——— STONE WALL
 T3 ——— t 3 ——— TREE LINE
 100BZ ——— 100BZ ——— 100-FT BUFFER ZONE
 100R ——— 100R ——— 100-FT RIVER FRONT AREA
 200RA ——— 200RA ——— 200-FT RIVER FRONT AREA
 200T ——— 200T ——— LIMIT MEAN ANNUAL HIGH WATER
 500T ——— 500T ——— LIMIT OF BANK
 500B ——— 500B ——— VEGETATED WETLAND BOUNDARY

Assembly Row
Assembly Square
PUD
Somerville, Massachusetts

Drawing Title
Drain Asbuilt

Sv-2

Sheet of
2 13

Project Number
11763.00

\\MAWALD\vd\11763.00\cad\sr\planset\11763.00~ASSEMBLY.dwg



1. THE PROPERTY LINES SHOWN ON THIS PLAN ARE BASED UPON AN ACTUAL FIELD SURVEY CONDUCTED BY VANASSE HANGEN BRUSTLIN, INC. IN MARCH 2008 AND FROM DEEDS AND PLANS OF RECORD.
2. THE EXISTING CONDITIONS OF WATER, SEWER DRAIN, TELEPHONE AND ELECTRIC DUCT BANKS SHOWN ON THIS PLAN ARE BASED UPON AN ACTUAL ON-THE-GROUND INSTRUMENT SURVEY PERFORMED BY VANASSE HANGEN BRUSTLIN, INC. IN SEPTEMBER THRU DECEMBER OF 2011.
3. THE LOCATIONS OF THE UNDERGROUND UTILITIES SHOWN ON THIS PLAN ARE BASED ON FIELD OBSERVATIONS OF EXPOSED ANGLE POINTS AND PARTIAL INSTALLMENTS DURING CONSTRUCTION. VHB DID NOT OBSERVE ALL LOCATIONS OF UNDERGROUND LINES OR LINES OF SIGHT DURING INSTALLMENT.
4. HORIZONTAL DATUM IS BASED ON MASS GRID SYSTEM, NAD 1983. ELEVATIONS SHOWN ON THIS PLAN REFER TO NAVD OF 1988.



Vanasse Hangen Brustlin, Inc.

Transportation
Land Development
Environmental Services

101 Walnut Street, P.O. Box 9151
Watertown, Massachusetts 02471-9151
617 924 1770 • FAX 617 924 2286

Legend

- ① DRAIN MANHOLE
- ② CATCH BASIN
- ③ SEWER MANHOLE
- ④ ELECTRIC MANHOLE
- ⑤ TELEPHONE MANHOLE
- ⑥ MANHOLE
- ⑦ HAND HOLE
- ⑧ WATER GATE
- ⑨ FIRE HYDRANT
- ⑩ GAS GATE
- ⑪ STREET SIGN
- ⑫ LIGHT POLE
- ⑬ UTILITY POLE
- ⑭ GUY WIRE
- ⑮ GUY WIRE
- ⑯ MONITORING WELL
- ⑰ FLOOD LIGHT
- ⑱ WELL
- ⑲ ONO COULD NOT OPEN
- ⑳ NPV NO PIPES VISIBLE

F.F.E.=45.27 FINISHED FLOOR ELEVATION

- EDGE OF PAVEMENT
- CONCRETE CURB
- VERTICAL GRANITE CURB
- SLOPED GRANITE EDGE
- BITUMINOUS CURB
- GUARD RAIL
- CHAIN LINK FENCE
- DRAINAGE LINE
- SEWER LINE
- OVERHEAD WIRE
- UNDERGROUND ELECTRIC
- TELEPHONE LINE
- GAS LINE
- WATER LINE
- STONE WALL
- TREE LINE
- 100' BUFFER ZONE
- 100' BUFFER FRONT AREA
- 200' BUFFER FRONT AREA
- LIMIT MEAN ANNUAL HIGH WATER
- LIMIT OF BANK
- VEGETATED WETLAND BOUNDARY

No.	Revision	Date	Appr.

Assembly Row
Assembly Square
PUD
Somerville, Massachusetts


Utility As-Built

Drain Asbuilt

Drawing Number
Sv-3
Sheet 3 of 13
Project Number
11763.00

General Notes

1. THE PROPERTY LINES SHOWN ON THIS PLAN ARE BASED UPON AN ACTUAL FIELD SURVEY CONDUCTED BY VANASSE HANGEN BRUSTLIN, INC. IN MARCH 2008 AND FROM DEEDS AND PLANS OF RECORD.
2. THE EXISTING CONDITIONS OF WATER, SEWER, DRAIN, TELEPHONE AND ELECTRIC DUCT BANKS SHOWN ON THIS PLAN ARE BASED UPON AN ACTUAL ON-THE-GROUND INSTRUMENT SURVEY PERFORMED BY VANASSE HANGEN BRUSTLIN, INC. IN SEPTEMBER THRU DECEMBER OF 2011.
3. THE LOCATIONS OF THE UNDERGROUND UTILITIES SHOWN ON THIS PLAN ARE BASED ON FIELD OBSERVATIONS OF EXPOSED ANGLE POINTS AND PARTIAL INSTALLMENTS DURING CONSTRUCTION. VHB DID NOT OBSERVE ALL LOCATIONS OF UNDERGROUND LINES OR LINES OF SIGHT DURING INSTALLMENT.
4. HORIZONTAL DATUM IS BASED ON MASS. GRID SYSTEM, NAD 1983. ELEVATIONS SHOWN ON THIS PLAN REFER TO NAVD OF 1988.

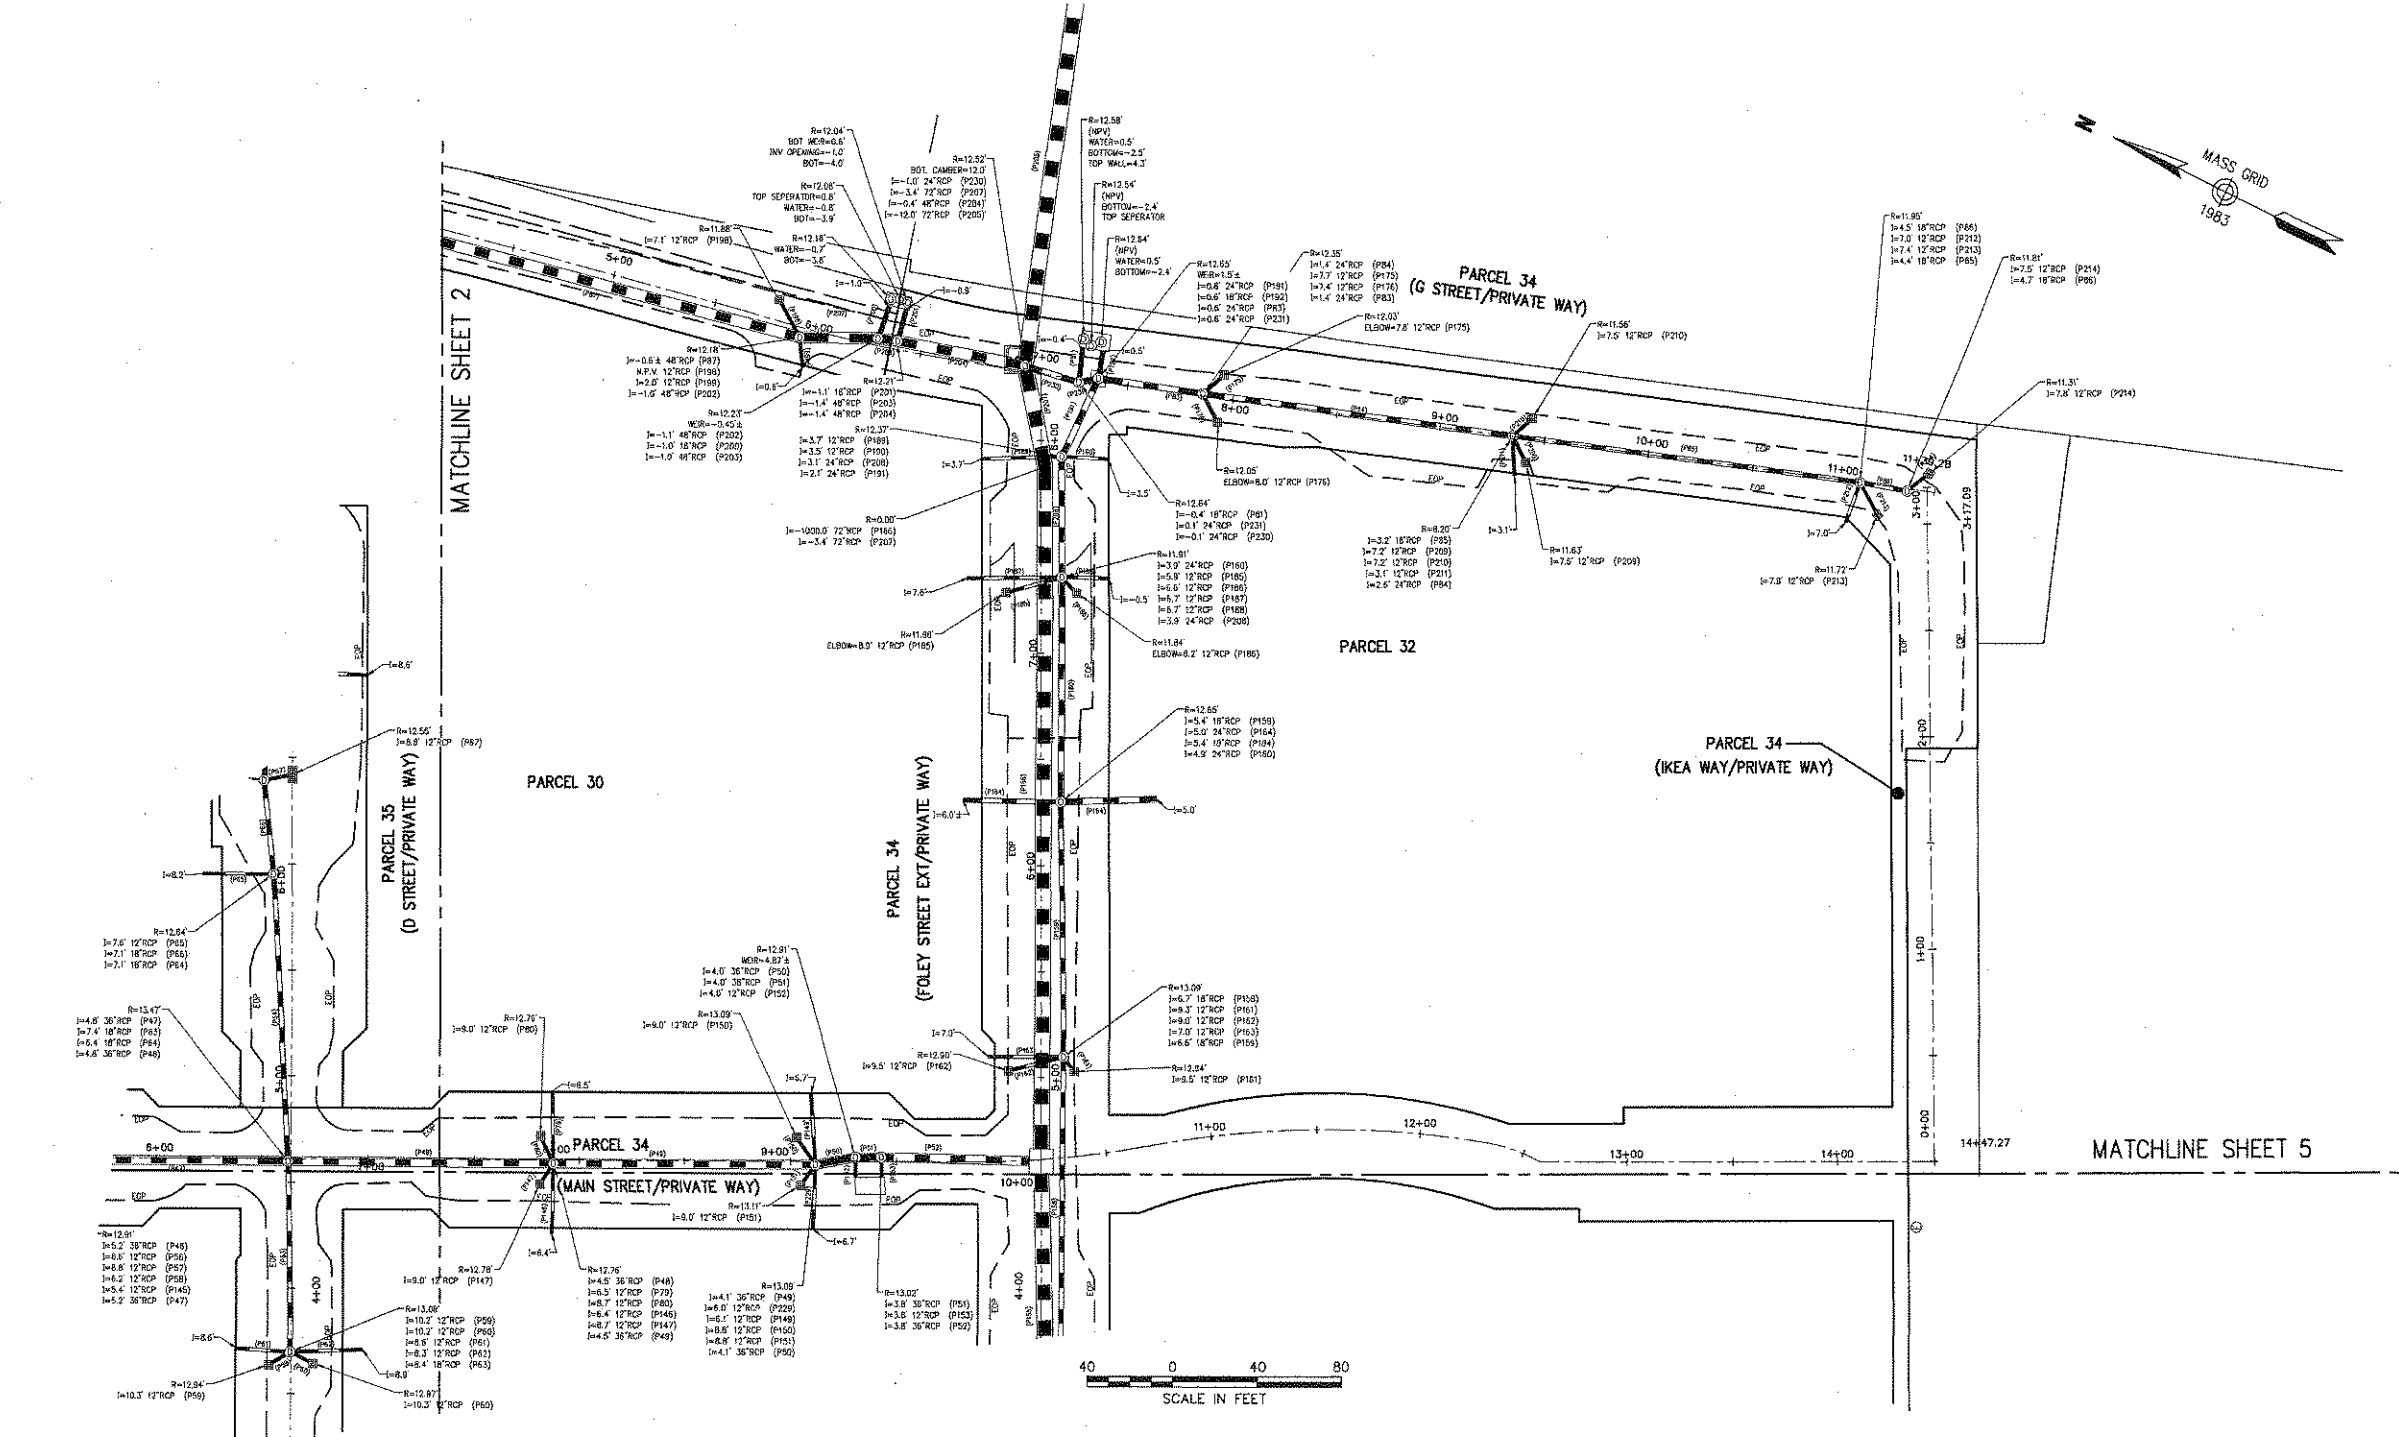



Transportation
Land Development
Environmental Services

101 Walnut Street, P.O. Box 9151
Watertown, Massachusetts 02471-9151
617 924 1770 • FAX 617 924 2286

Legend

- ① DRAIN MANHOLE
- ② CATCH BASIN
- ③ SEWER MANHOLE
- ④ ELECTRIC MANHOLE
- ⑤ TELEPHONE MANHOLE
- ⑥ MANHOLE
- HH □ HAND HOLE
- ⊗ WATER GATE
- ⊗ FIRE HYDRANT
- GAS GATE
- STREET SIGN
- ☆ LIGHT POLE
- UTILITY POLE
- GUY POLE
- GUY WIRE
- HW ● MONITORING WELL
- ▶ FLOOD LIGHT
- ⊗ WELL
- CNO COULD NOT OPEN
- NPV NO PIPES VISIBLE

4 F.F.E. = 45.27' FINISHED FLOOR ELEVATION

- | | |
|--|--|
| | EDGE OF PAVEMENT |
| | CONCRETE CURB |
| | VERTICAL GRANITE CURB |
| | SLOPED GRANITE EDGE |
| | BITUMINOUS BERM |
| | BITUMINOUS CURB |
| | GUARD RAIL |
| | CHAIN LINK FENCE |
| | DRAINAGE LINE |
| | SEWER LINE |
| | OVERHEAD WIRE |
| | UNDERGROUND ELECTRIC |
| | TELEPHONE LINE |
| | GAS LINE |
| | WATER LINE |
| | STONE WALL |
| | TREE LINE |
| | 100-FT BUFFER ZONE |
| | 100-FT RIVER FRONT AREA |
| | 200-FT RIVER FRONT AREA |
| | LIMIT MEAN ANNUAL HIGH WATER |
| | LIMIT OF FLOOD V egetated Wetland Boundary |

No.	Revision	Date	App.
Designed by	Drawn by	Checked by	
CAD checked by	Approved by		
Scale 1"=40'	Date	March 9, 2012	

Assembly Row
Assembly Square
PUD
Somerville, Massachusetts

Utility As-Built

Drawing Title
Drain Asbuilt

Drawing Slobber

Sv-4

Sheet of
4 13

Project Number
11263.00

\\MAWALD\id\11763.00\cgc\sr\elense\11763.00-ASBUILT.d

General Notes

1. THE PROPERTY LINES SHOWN ON THIS PLAN ARE BASED UPON AN ACTUAL FIELD SURVEY CONDUCTED BY VANASSE HANGEN BRUSTLIN, INC. IN MARCH 2008 AND FROM DEEDS AND PLANS OF RECORD.
2. THE EXISTING CONDITIONS OF WATER, SEWER DRAIN, TELEPHONE AND ELECTRIC DUCT BANKS SHOWN ON THIS PLAN ARE BASED UPON AN ACTUAL ON-THE-GROUND INSTRUMENT SURVEY PERFORMED BY VANASSE HANGEN BRUSTLIN, INC. IN SEPTEMBER THRU DECEMBER OF 2011.
3. THE LOCATIONS OF THE UNDERGROUND UTILITIES SHOWN ON THIS PLAN ARE BASED ON FIELD OBSERVATIONS OF EXPOSED ANGLE POINTS AND PARTIAL INSTALLMENTS DURING CONSTRUCTION. VHB DID NOT OBSERVE ALL LOCATIONS OF UNDERGROUND LINES OR LINES OF SIGHT DURING INSTALLMENT.
4. HORIZONTAL DATUM IS BASED ON NAD 83 GRID SYSTEM, NAD 1983. ELEVATIONS SHOWN ON THIS PLAN REFER TO MEAN OF 1988.

Legend

- ② DRAIN MANHOLE
- CATCH BASIN
- ⑤ SEWER MANHOLE
- ④ ELECTRIC MANHOLE
- ① TELEPHONE MANHOLE
- MANHOLE
- PHH □ HAND HOLE
- ⊗ WATER GATE
- ⊗ FIRE HYDRANT
- GAS GATE
- STREET SIGN
- ☆ LIGHT POLE
- UTILITY POLE
- GUY POLE
- () GUY WIRE
- ⊗ MONITORING WELL
- ▶ FLOOD LIGHT
- ⊗ WELL
- CNO COULD NOT OPEN
- NPV NO PIPES VISIBLE

F.F.E.=45.27' FINISHED FLOOR ELEVATION

- | | |
|---------------------------|---------------------------|
| EDGE OF PAVEMENT | EDGE OF PAVEMENT |
| CONCRETE CURB | CONCRETE CURB |
| VERTICAL GRANITE CURB | VERTICAL GRANITE CURB |
| SLOPED GRANITE EDGE | SLOPED GRANITE EDGE |
| BITUMINOUS BERM | BITUMINOUS BERM |
| BITUMINOUS CURB | BITUMINOUS CURB |
| GUARD RAIL | GUARD RAIL |
| CHAIN LINK FENCE | CHAIN LINK FENCE |
| DRAINAGE LINE | DRAINAGE LINE |
| SEWER LINE | SEWER LINE |
| OVERHEAD WIRE | OVERHEAD WIRE |
| UNDERGROUND ELECTRIC | UNDERGROUND ELECTRIC |
| TELEPHONE LINE | TELEPHONE LINE |
| GAS LINE | GAS LINE |
| WATER LINE | WATER LINE |
| STONE WALL | STONE WALL |
| TREE LINE | TREE LINE |
| 100'-FT BUFFER ZONE | 100'-FT BUFFER ZONE |
| 100'-FT RIVER FRONT AREA | 100'-FT RIVER FRONT AREA |
| 200'-FT RIVER FRONT AREA | 200'-FT RIVER FRONT AREA |
| UNIT OF ANNUAL HIGH WATER | UNIT OF ANNUAL HIGH WATER |
| UNIT OF BANK | UNIT OF BANK |
| VEGETATED WETLAND WINDY | VEGETATED WETLAND WINDY |

No.	Revision	Date	Appvd.
Designed by	Drawn by	Checked by	
CAO checked by	Approved by		
Scale 1"=40'	Date March 9, 2012		

Assembly Row
Assembly Square
PUD

Somerville, Massachusetts

Utility As-Built

Drawing Title

Sewer Asbuilt


Drinking Water

Sv-6

Sheet of
6 13

Project Number
11763.00

\\MAWALD\16\11763.00\cod\sr\planset\11763.00-ASBuli.1.dwg

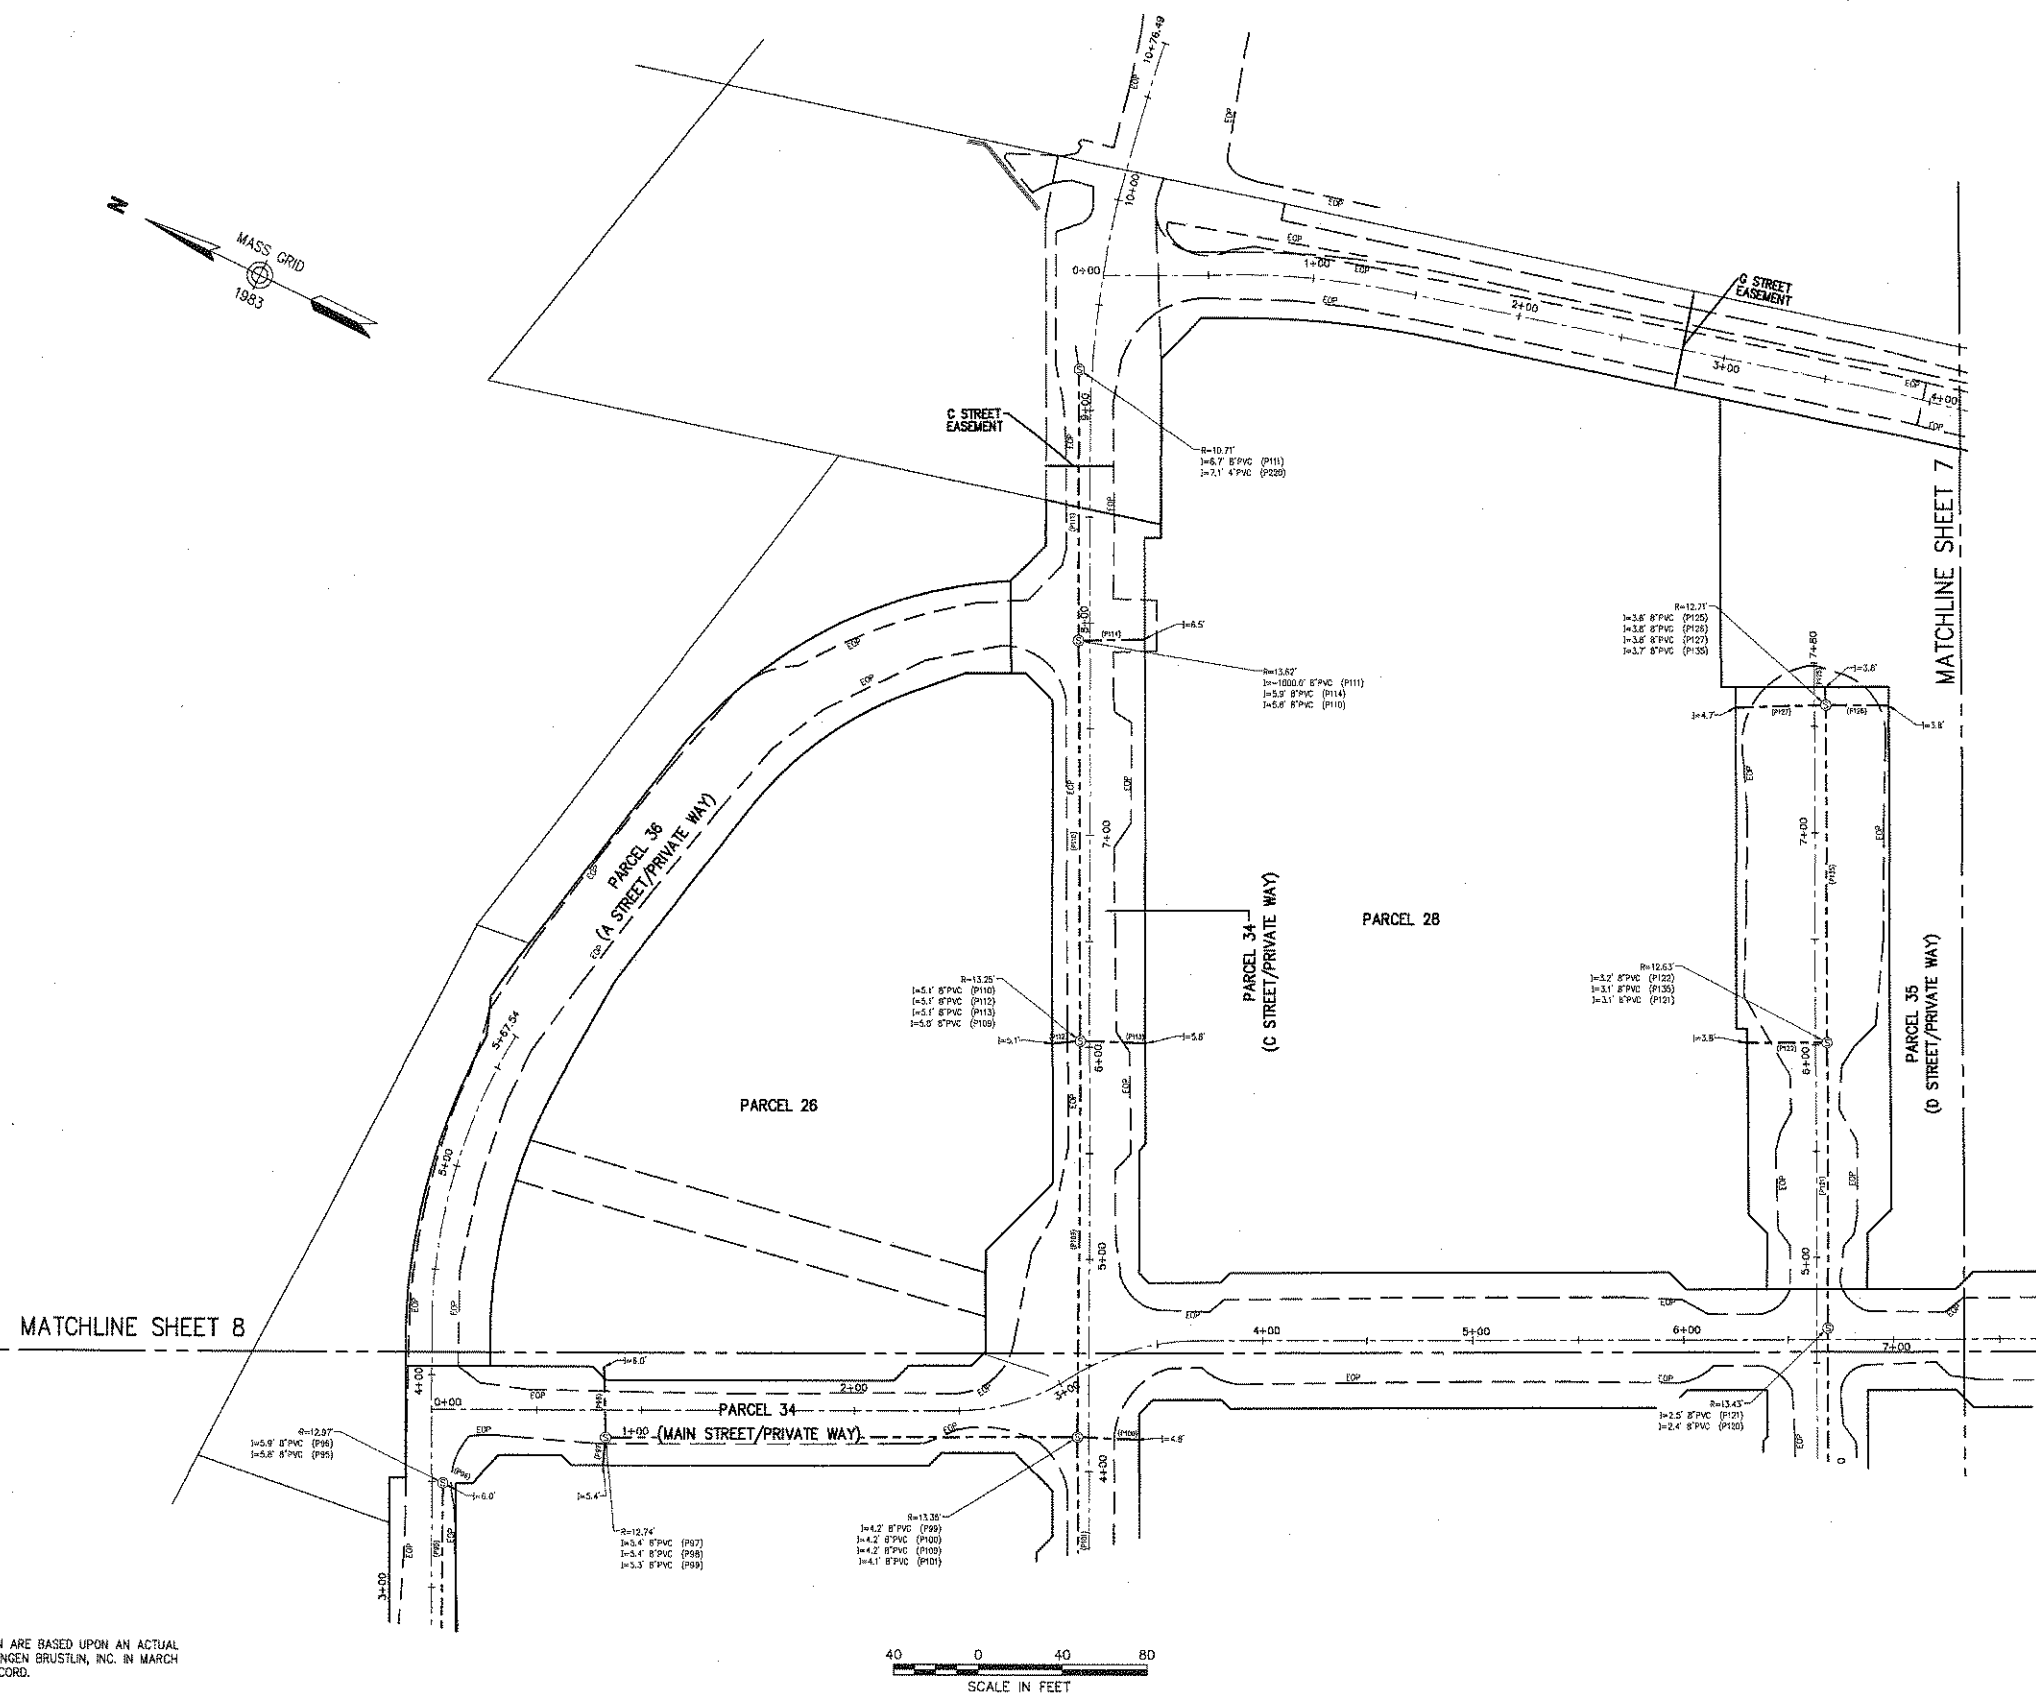


General Notes

1. THE PROPERTY LINES SHOWN ON THIS PLAN ARE BASED UPON AN ACTUAL FIELD SURVEY CONDUCTED BY VANASSE HANGEN BRUSTLIN, INC. IN MARCH 2008 AND FROM DEEDS AND PLANS OF RECORD.
2. THE EXISTING CONDITIONS OF WATER, SEWER DRAIN, TELEPHONE AND ELECTRIC DUCT BANKS SHOWN ON THIS PLAN ARE BASED UPON AN ACTUAL ON-THE-GROUND INSTRUMENT SURVEY PERFORMED BY VANASSE HANGEN BRUSTLIN, INC. IN SEPTEMBER THRU DECEMBER OF 2011.
3. THE LOCATIONS OF THE UNDERGROUND UTILITIES SHOWN ON THIS PLAN ARE BASED ON FIELD OBSERVATIONS OF EXPOSED ANGLE POINTS AND PARTIAL INSTALLMENTS DURING CONSTRUCTION. VHB DID NOT OBSERVE ALL LOCATIONS OF UNDERGROUND LINES OR LINES OF SIGHT DURING INSTALLMENT.
4. HORIZONTAL DATUM IS BASED ON NAD 83, GRID SYSTEM, NAD 1983. ELEVATIONS SHOWN ON THIS PLAN REFER TO NAVD OF 1988.



Transportation
Land Development
Environmental Services

101 Walnut Street, P.O. Box 9151
Watertown, Massachusetts 02471-9151
617 924 1770 • FAX 617 924 2286

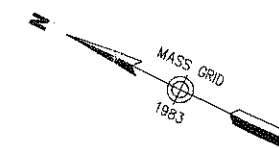

Legend

- (D) DRAIN MANHOLE
 (B) CATCH BASIN
 (S) SEWER MANHOLE
 (E) ELECTRIC MANHOLE
 (T) TELEPHONE MANHOLE
 (M) MANHOLE
 HH ☐ HAND HOLE
 (W) WATER GATE
 (F) FIRE HYDRANT
 (G) GAS GATE
 - STREET SIGN
 ☆ LIGHT POLE
 ☆ UTILITY POLE
 ~ GUY WIRE
 ~ GUY POLE
 (M) MONITORING WELL
 (F) FLOOD LIGHT
 (W) WELL
 CNO COULD NOT OPEN
 NPV NO PIPES VISIBLE

4 F.F.E.=45.27' FINISHED FLOOR ELEVATION

- | | |
|----------|----------------------------|
| EDP | EDGE OF PAVEMENT |
| CURB | CONCRETE CURB |
| VGC | VERTICAL GRANITE CURB |
| SSE | SLOPED GRANITE EDGE |
| SB | BITUMINOUS BERM |
| | BITUMINOUS CURB |
| | GUARD RAIL |
| | CHAIN LINK FENCE |
| | DRAINAGE LINE |
| | SEWER LINE |
| -DW- | OVERHEAD WIRE |
| () | UNDERGROUND ELECTRIC |
| | TELEPHONE LINE |
| G | GAS LINE |
| W | WATER LINE |
| | STONE WALL |
| | TREE LINE |
| 159'37" | 100-FT BUFFER ZONE |
| 100'RA | 100-FT RIVER FRONT AREA |
| 200'RA | 200-FT RIVER FRONT AREA |
| WT | LIMIT MEAN HIGH WATER |
| 16'-100' | LIMIT OF BANK |
| VEG | VEGETATED NEARLY BORDERARY |

No.	Revision	Date	App
Designed by	Drawn by	Checked by	
CAD checked by	Approved by		
Scale 1"=40'	Date	March 9, 2012	

Assembly Row
Assembly Square
PUD

Somerville, Massachusetts

Utility As-Built

Drawing Title

Sewer Asbuilt

General Notes


1. THE PROPERTY LINES SHOWN ON THIS PLAN ARE BASED UPON AN ACTUAL FIELD SURVEY CONDUCTED BY VANASSE HANGEN BRUSTLIN, INC. IN MARCH 2008 AND FROM DEEDS AND PLANS OF RECORD.
2. THE EXISTING CONDITIONS OF WATER, SEWER DRAIN, TELEPHONE AND ELECTRIC DUCT BANKS SHOWN ON THIS PLAN ARE BASED UPON AN ACTUAL ON-THE-GROUND INSTRUMENT SURVEY PERFORMED BY VANASSE HANGEN BRUSTLIN, INC. IN SEPTEMBER THRU DECEMBER OF 2011.
3. THE LOCATIONS OF THE UNDERGROUND UTILITIES SHOWN ON THIS PLAN ARE BASED ON FIELD OBSERVATIONS OF EXPOSED ANGLE POINTS AND PARTIAL INSTALLMENTS DURING CONSTRUCTION. VHB DID NOT OBSERVE ALL LOCATIONS OF UNDERGROUND LINES OR LINES OF SIGHT DURING INSTALLMENT.
4. HORIZONTAL DATUM IS BASED ON NASS. GRID SYSTEM, NAD 1983. ELEVATIONS SHOWN ON THIS PLAN REFER TO MASS. OF 1988.

Journal Number

Sy-

Sheet of
7

Project Number
11763.00

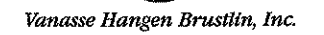

101 Walnut Street, P.O. Box 9151
Watertown, Massachusetts 02471-9151
617 924 1770 • FAX 617 924 2286

- ② DRAIN MANHOLE
- ③ CATCH BASIN
- ④ SEWER MANHOLE
- ⑤ ELECTRIC MANHOLE
- ⑥ TELEPHONE MANHOLE
- ⑦ MANHOLE
- H/H HAND HOLE
- ⑧ WATER GATE
- ⑨ FIRE HYDRANT
- ⑩ GAS GATE
- ⑪ STREET SIGN
- ⑫ LIGHT POLE
- ⑬ UTILITY POLE
- ⑭ GUY POLE
- ⑮ GUY WIRE
- ⑯ MONITORING WELL
- ⑰ FLOOD LIGHT
- ⑱ WELL

CNO COULD NOT OPEN
NPV NO PIPES VISIBLE

EOP	EDGE OF PAVEMENT
CURB	CONCRETE CURB
MSS	VERTICAL GRANITE CURB
SLOPED	SLOPED GRANITE EDGE
BURN	BITUMINOUS BERM
GURB	GRASSY CURB
GUARD	GUARD RAIL
CHAIN LINK FENCE	CHAIN LINK FENCE
DRAINAGE LINE	DRAINAGE LINE
SEWER LINE	SEWER LINE
OVERHEAD WIRE	OVERHEAD WIRE
E	UNDERGROUND ELECTRIC
T	TELEPHONE LINE
G	GAS LINE
W	WATER LINE
STONE WALL	STONE WALL
TREE LINE	TREE LINE
100-FT BUFFER ZONE	100-FT BUFFER ZONE
100-FT RIVER FROM AREA	100-FT RIVER FROM AREA
200-FT RIVER FRONT AREA	200-FT RIVER FRONT AREA
LIMIT WEAN ANIMAL AREA	LIMIT WEAN ANIMAL AREA
LIMIT OF BANK	LIMIT OF BANK
VEGETATED WETLAND BOUNDARY	VEGETATED WETLAND BOUNDARY

No.	Revision	Date	Appvd.
Designed by		Drawn by	Checked by
CAB checked by		Approved by	
Scale 1"=40'		Date March 9, 2012	

TABLE 10


Drawing Title _____

Sv-8

Sheet of
8 13


Project Number
11763.00

\\MAWALD\id\11763.00\cod\sr\plonset\11763.00-ASBUILT.dwg

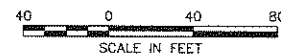

1. THE PROPERTY LINES SHOWN ON THIS PLAN ARE BASED UPON AN ACTUAL FIELD SURVEY CONDUCTED BY VANASSE HANGEN BRUSTLIN, INC. IN MARCH 2008 AND FROM DEEDS AND PLANS OF RECORD.
2. THE EXISTING CONDITIONS OF WATER, SEWER DRAIN, TELEPHONE AND ELECTRIC DUCT BANKS SHOWN ON THIS PLAN ARE BASED UPON AN ACTUAL ON-THE-GROUND INSTRUMENT SURVEY PERFORMED BY VANASSE HANGEN BRUSTLIN, INC. IN SEPTEMBER THRU DECEMBER OF 2011.
3. THE LOCATIONS OF THE UNDERGROUND UTILITIES SHOWN ON THIS PLAN ARE BASED ON FIELD OBSERVATIONS OF EXPOSED ANGLE POINTS AND PARTIAL INSTALLMENTS DURING CONSTRUCTION. VHB DID NOT OBSERVE ALL LOCATIONS OF UNDERGROUND LINES OR LINES OF SIGHT DURING INSTALLMENT.
4. HORIZONTAL DATUM IS BASED ON MASS GRID SYSTEM, NAD 1983. ELEVATIONS SHOWN ON THIS PLAN REFER TO NAVD OF 1988.



 

101 Walnut Street, P.O. Box 9151
Watertown, Massachusetts 02471-9151
617 924 1770 • FAX 617 924 2286




- 1 F.F.E.=45.27' FINISHED FLOOR ELEVATION

- [illegible]

Assembly Row
Assembly Square
PUD
Somerville, Massachusetts

Sewer Asbuilt

1. THE PROPERTY LINES SHOWN ON THIS PLAN ARE BASED UPON AN ACTUAL FIELD SURVEY CONDUCTED BY VANASSE HANGEN BRUSTLIN, INC. IN MARCH 2008 AND FROM DEEDS AND PLANS OF RECORD.
2. THE EXISTING CONDITIONS OF WATER, SEWER DRAIN, TELEPHONE AND ELECTRIC DUCT BANKS SHOWN ON THIS PLAN ARE BASED UPON AN ACTUAL ON-THE-GROUND INSTRUMENT SURVEY PERFORMED BY VANASSE HANGEN BRUSTLIN, INC. IN SEPTEMBER THRU DECEMBER OF 2011.
3. THE LOCATIONS OF THE UNDERGROUND UTILITIES SHOWN ON THIS PLAN ARE BASED ON FIELD OBSERVATIONS OF EXPOSED ANGLE POINTS AND PARTIAL INSTALLMENTS DURING CONSTRUCTION. VHB DID NOT OBSERVE ALL LOCATIONS OF UNDERGROUND LINES OR LINES OF SIGHT DURING INSTALLMENT.
4. HORIZONTAL DATUM IS BASED ON MASS. GRID SYSTEM, NAD 1983. ELEVATIONS SHOWN ON THIS PLAN REFER TO NAVD OF 1988.

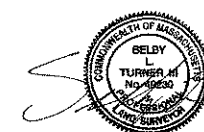Drawing Number
Sv-9

Sheet of
9 13

Project Number
11763.00

\\MAWALD\o\11763.00\cad\sr\planse\11763.00-ASBUK.T.dwg



Vanasse Hangen Brustlin, Inc.

Transportation
Land Development
Environmental Services

101 Walnut Street, P.O. Box 9151
Watertown, Massachusetts 02471-9151
617 924 1770 • FAX 617 924 2286

Legend

- ① DRAIN MANHOLE
- ② CATCH BASIN
- ③ SEWER MANHOLE
- ④ ELECTRIC MANHOLE
- ⑤ TELEPHONE MANHOLE
- ⑥ MANHOLE
- ⑦ HAND HOLE
- ⑧ WATER GATE
- ⑨ FIRE HYDRANT
- ⑩ GAS GATE
- ⑪ STREET SIGN
- ⑫ LIGHT POLE
- ⑬ UTILITY POLE
- ⑭ GUY POLE
- ⑮ GUY WIRE
- ⑯ MONITORING WELL
- ⑰ FLOOD LIGHT
- ⑱ WELL
- ⑲ CNO COULD NOT OPEN
- ⑳ NPV NO PIPES VISIBLE
- ① F.F.E. = 45.27 FINISHED FLOOR ELEVATION
- ① E.P. EDGE OF PAVEMENT
- ② V.C. VERTICAL CURVE
- ③ S.C. SLOPED GRANITE CURB
- ④ B.C. BITUMINOUS CURB
- ⑤ G.R. GUARD RAIL
- ⑥ C.L.F. CHAIN LINK FENCE
- ⑦ D.L. DRAINAGE LINE
- ⑧ S.L. SEWER LINE
- ⑨ O.W. OVERHEAD WIRE
- ⑩ U.E. UNDERGROUND ELECTRIC
- ⑪ G.L. GAS LINE
- ⑫ W.L. WATER LINE
- ⑬ S.W. STONE WALL
- ⑭ T.L. TREE LINE
- ⑮ 100' 100-FT BUFFER ZONE
- ⑯ 100' 100-FT RIVER FRONT AREA
- ⑰ 200' 200-FT RIVER FRONT AREA
- ⑱ L.M.A.H.W. LIMIT MEAN ANNUAL HIGH WATER
- ⑲ L.O.B. LIMIT OF BANK
- ⑳ V.M.B. VEGETATED WETLAND BOUNDARY


No.	Revision	Date	Appr.

Designed by	Drawn by	Checked by
CAD checked by	Approved by	
Scale 1"=40'	Date March 9, 2012	Project Title

Assembly Row
Assembly Square
PUD
Somerville, Massachusetts
Issued for

Utility As-Built
Drawing Title
Utility Asbuilt

Drawing Number
Sv-10
Sheet 10 of 13
Project Number
11763.00

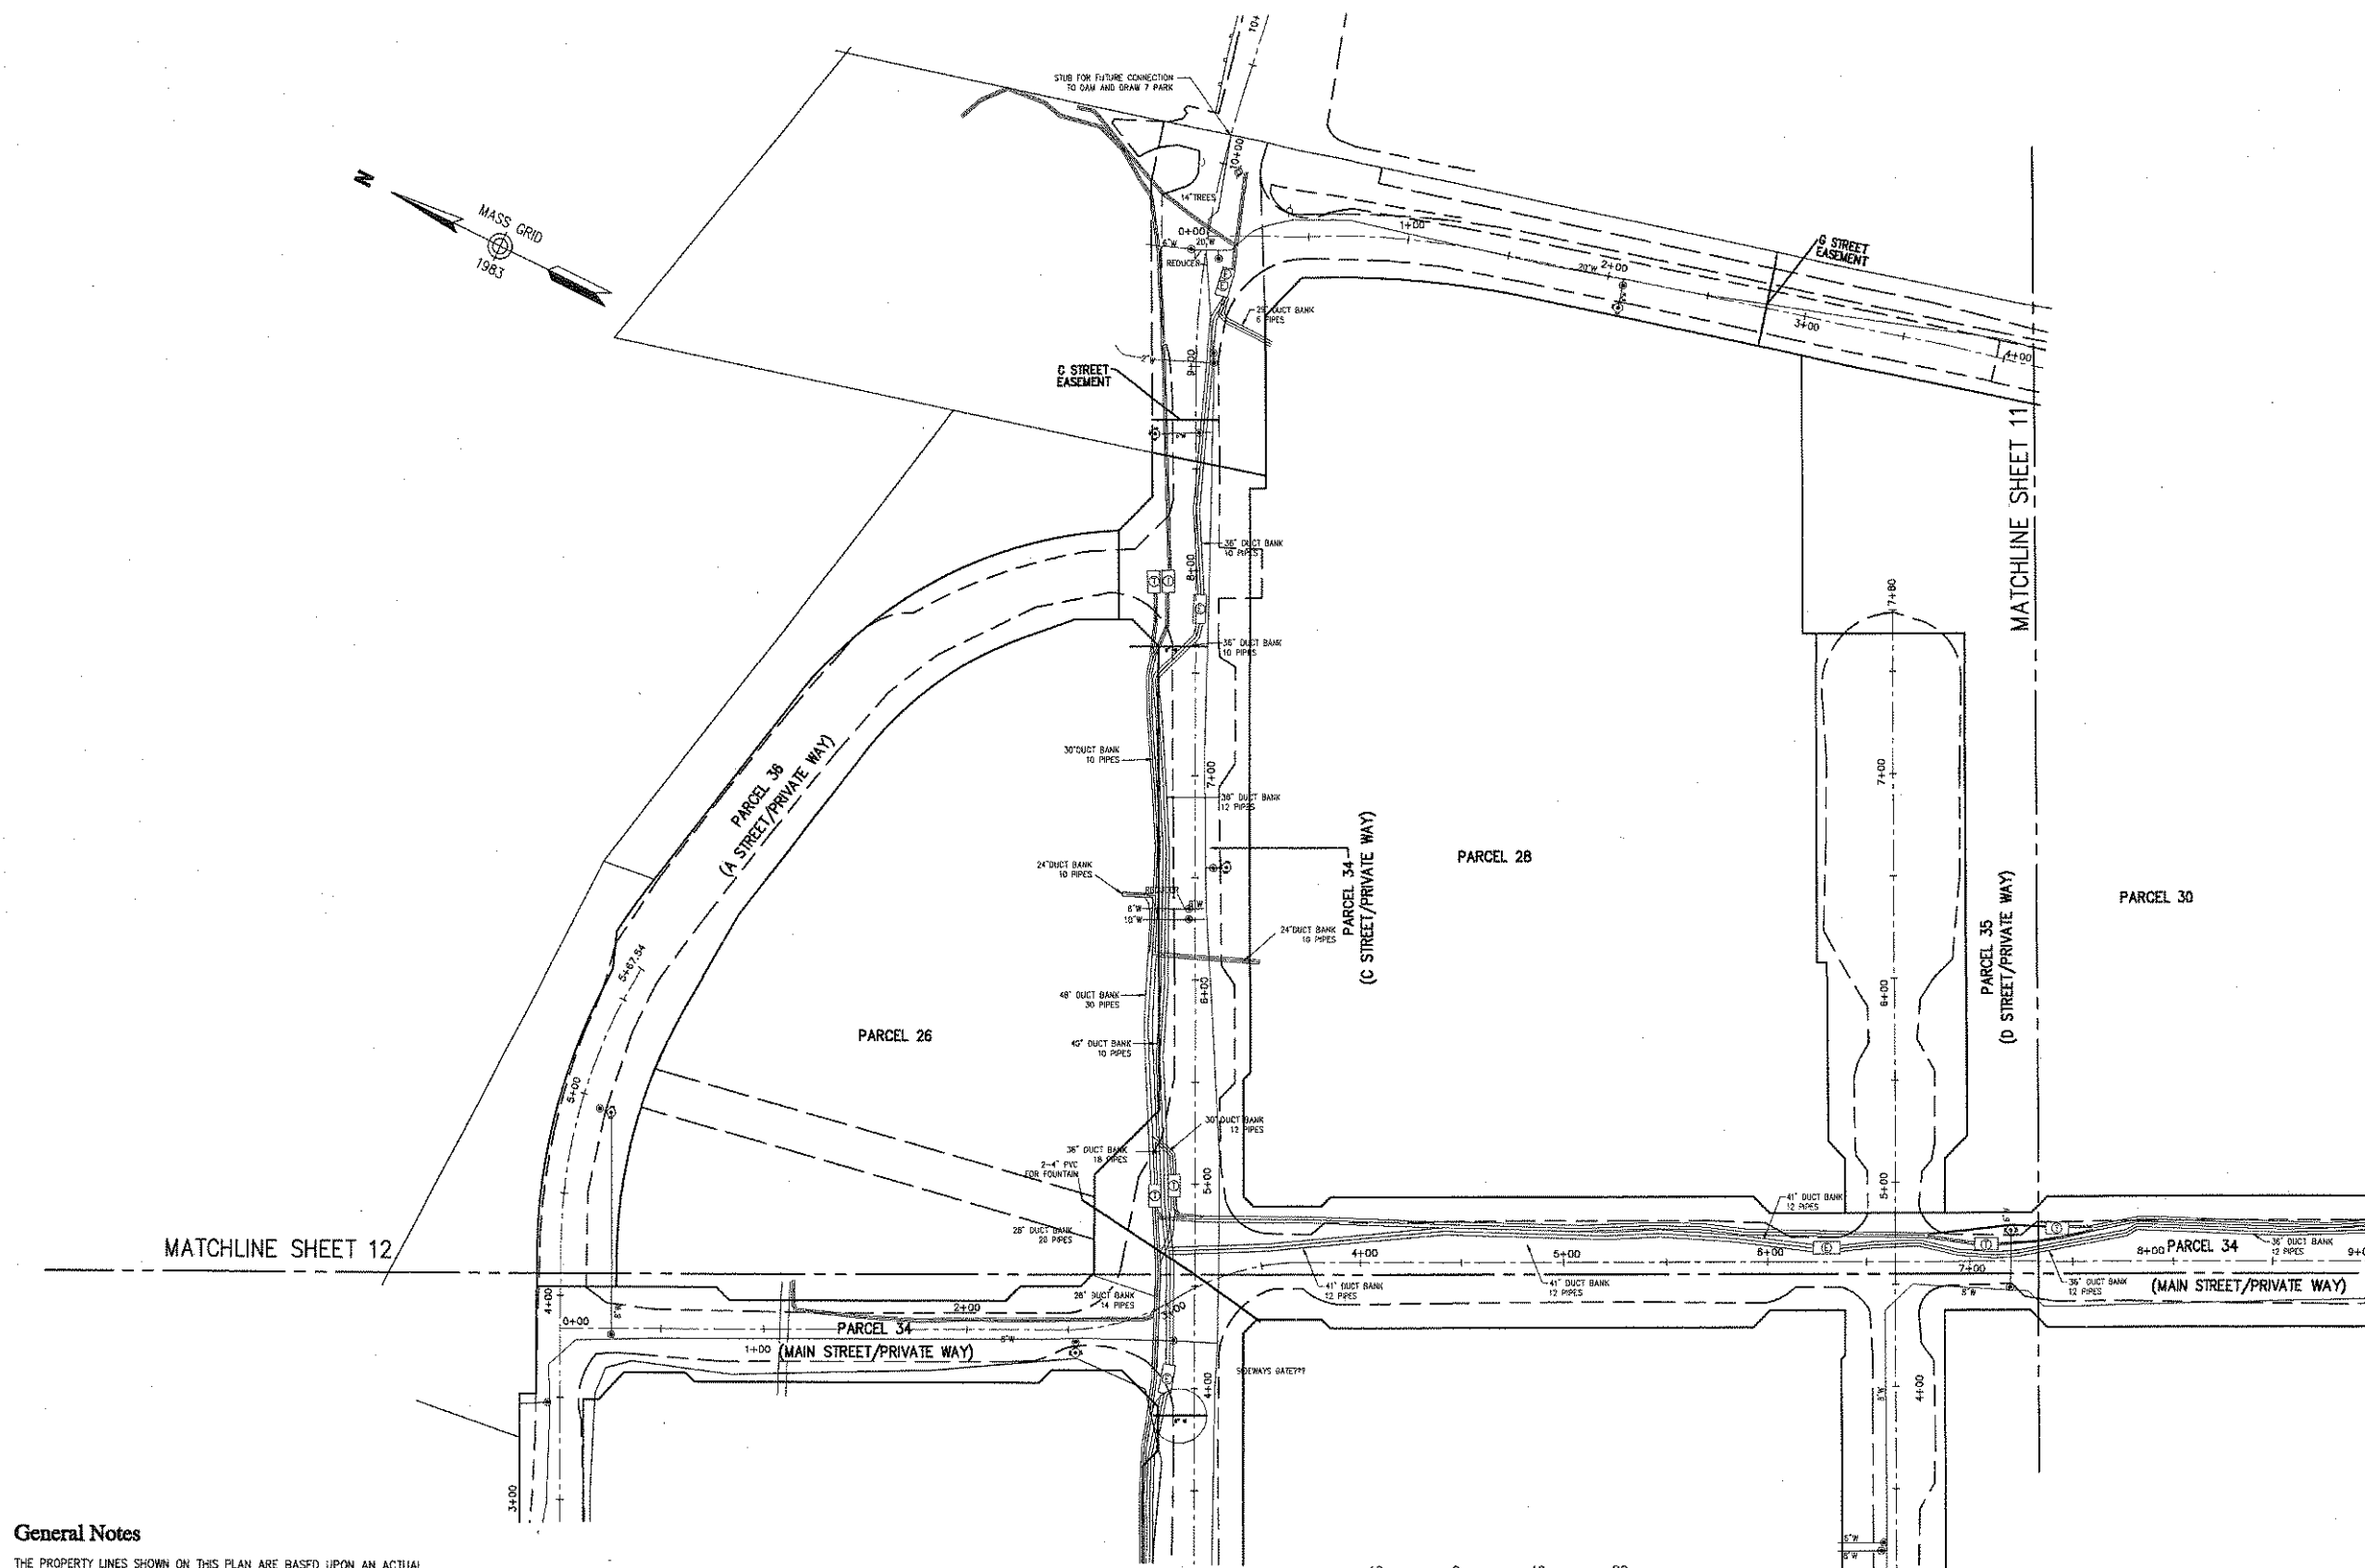

- General Notes
1. THE PROPERTY LINES SHOWN ON THIS PLAN ARE BASED UPON AN ACTUAL FIELD SURVEY CONDUCTED BY VANASSE HANGEN BRUSTLIN, INC. IN MARCH 2008 AND FROM DEEDS AND PLANS OF RECORD.
 2. THE EXISTING CONDITIONS OF WATER, SEWER DRAIN, TELEPHONE AND ELECTRIC DUCT BANKS SHOWN ON THIS PLAN ARE BASED UPON AN ACTUAL ON-THE-GROUND INSTRUMENT SURVEY PERFORMED BY VANASSE HANGEN BRUSTLIN, INC. IN SEPTEMBER THRU DECEMBER OF 2011.
 3. THE LOCATIONS OF THE UNDERGROUND UTILITIES SHOWN ON THIS PLAN ARE BASED ON FIELD OBSERVATIONS OF EXPOSED ANGLE POINTS AND PARTIAL INSTALLMENTS DURING CONSTRUCTION. VHB DID NOT OBSERVE ALL LOCATIONS OF UNDERGROUND LINES OR LINES OF SIGHT DURING INSTALLMENT.
 4. HORIZONTAL DATUM IS BASED ON MASS. GRID SYSTEM, NAD 1983. ELEVATIONS SHOWN ON THIS PLAN REFER TO NAVD OF 1988.



