


DAVID FLEMING & ASSOCIATES

LAND SURVEYOR
38 POND STREET FAX
(781) 438-0136 STONEHAM, MASS. (781) 279-0738

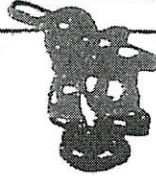

MORTGAGE INSPECTION PLAN

This plan was not done with an instrument error and is to be used for mortgage purposes only.


DATE: 12-29-02 SCALE: 1" = 20'

I certify that this dwelling is located approximately as shown and conformed to the zoning bylaws of the CITY of SOMERVILLE, MA when constructed and is not located in a flood plain hazard zone.

Deed & Plan Reference

MIDDLESEX County Reg. of Deeds
BOOK 3436 / PAGE 241
PLAN BOOK 53 PLAN 46


Community No. 250214 Effective 7-26-74 Revised 7-17-88

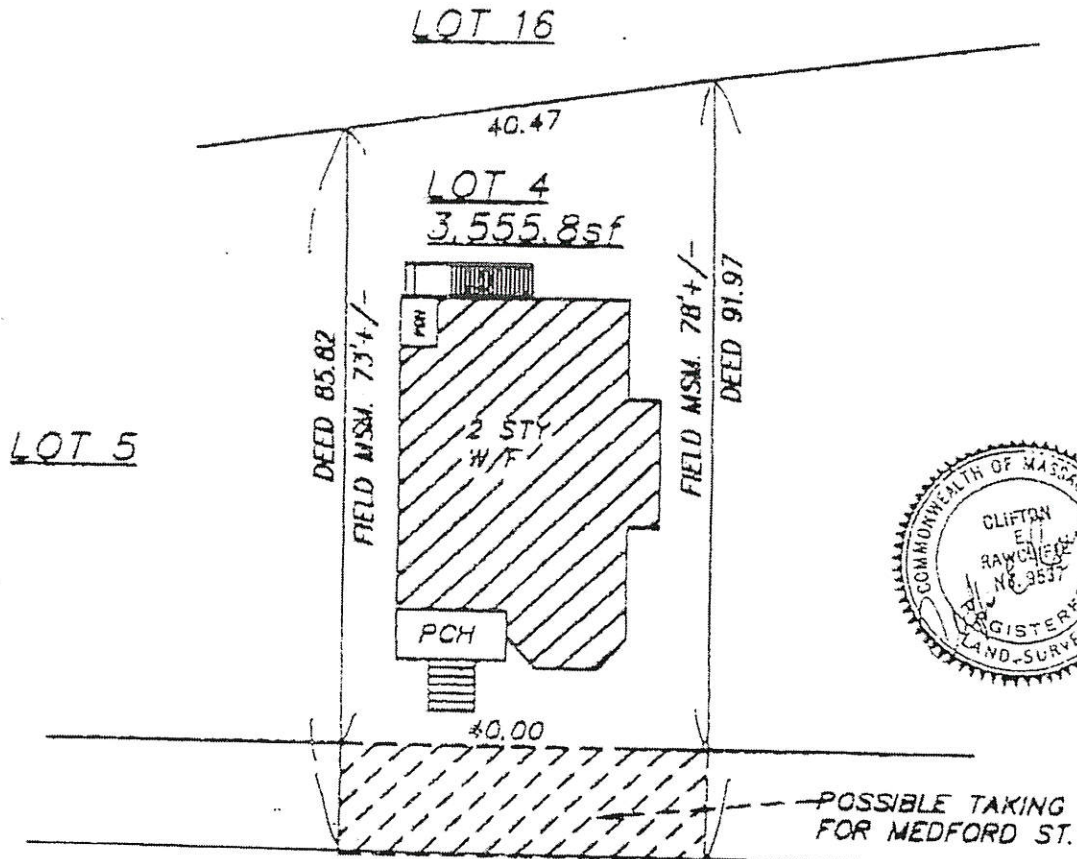

355 MEDFORD STREET

24


LOT 4
 UNIT ONE
 BASEMENT
 FIRST FLOOR
 UNIT TWO
 SECOND FLOOR
 THIRD FLOOR
 EXTERIOR STAIRS
 PORCHES

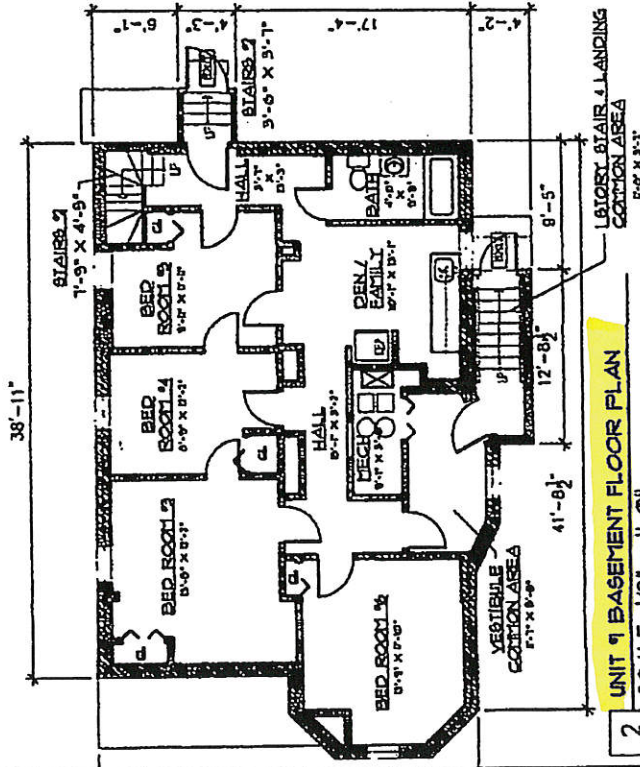

2 UNIT 1 BASEMENT FLOOR PLAN
 SCALE: 1/8" = 1'-0"

GMD DESIGNS
 100 W SELDEN ST
 MATTAHAN MA 02126
 781-414-8870

0 4' 8' 16'
 SCALE: 1/8" = 1'-0"

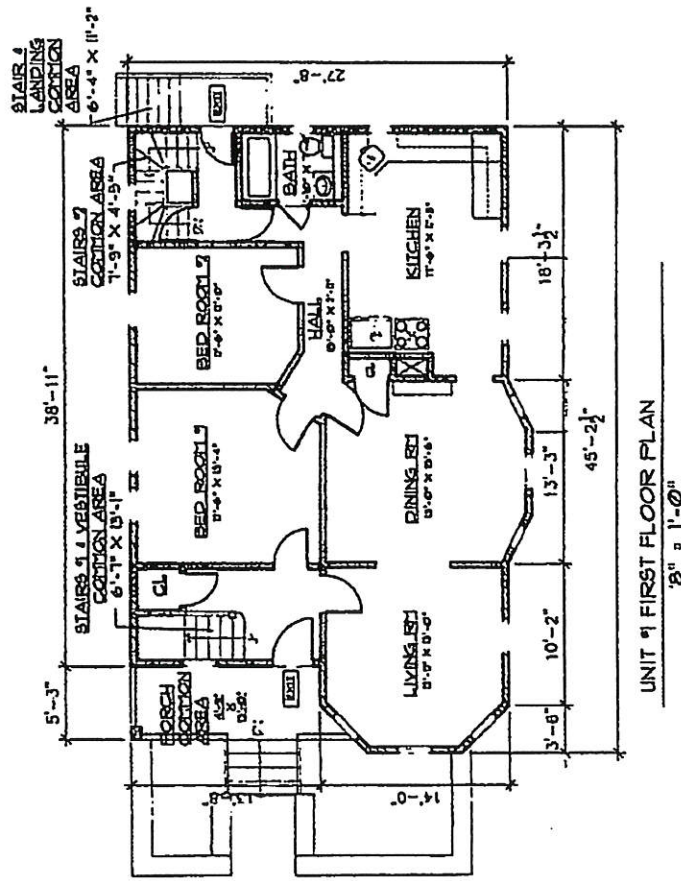

UNIT 1 FIRST FLOOR PLAN
 3/8" = 1'-0"

355 MEDFORD STREET CONDOMINIUM

SOMERVILLE, MASSACHUSETTS 02145 AS BUILT PLANS - NOVEMBER 21, 2007

A2