
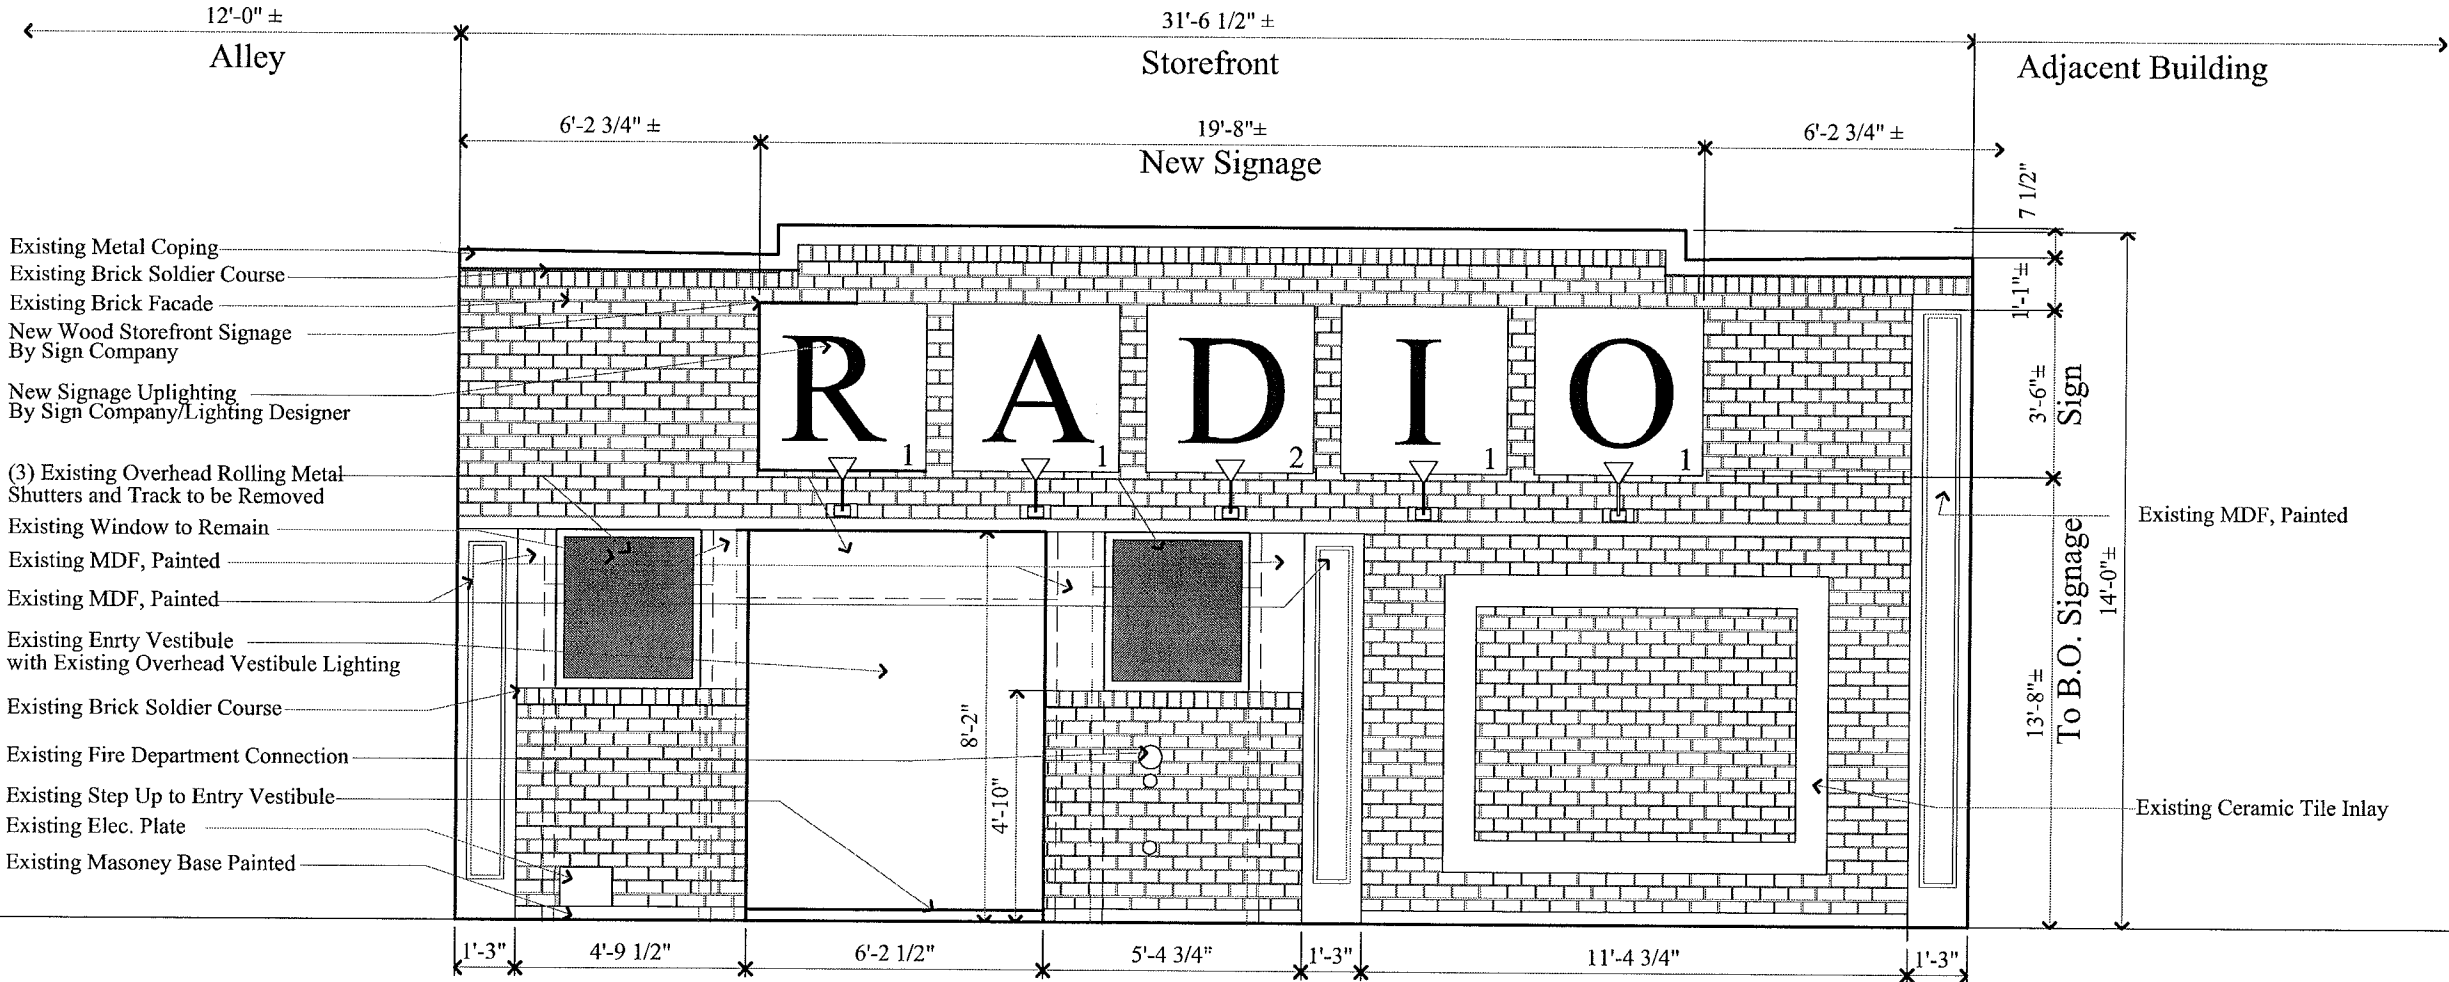


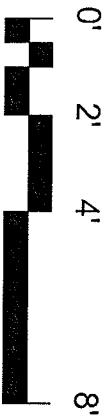

PROPOSED STOREFRONT ELEVATION
SCALE: 1/4"=1'-0"

Note: Existing "CHOICES" Awning to be Removed and Will be Replaced with New Storefront Signage as Shown Above. Signage by Sign Company

Project:
RADIO
379 SOMERVILLE AVE.
SOMERVILLE, MA


PROPOSED STOREFRONT ELEVATION

blanchardA+D, LLC
49 Cherry Street
Somerville, MA 02144

DESIGN AND USE OF DOCUMENTS
DRAWING AND SPECIFICATIONS ARE PREPARED BY ARCHITECTURAL, ENGINEERING AND DESIGN FIRM. ALL RIGHTS ARE RESERVED. THESE DOCUMENTS ARE NOT TO BE REPRODUCED OR TRANSMITTED IN ANY FORM OR BY ANY MEANS, ELECTRONIC OR MECHANICAL, WITHOUT PERMISSION IN WRITING FROM ARCHITECTURAL, ENGINEERING AND DESIGN FIRM.

Scale: 1/4"=1'-0"
Date: October 28, 2011

Sheet No.
A2.0

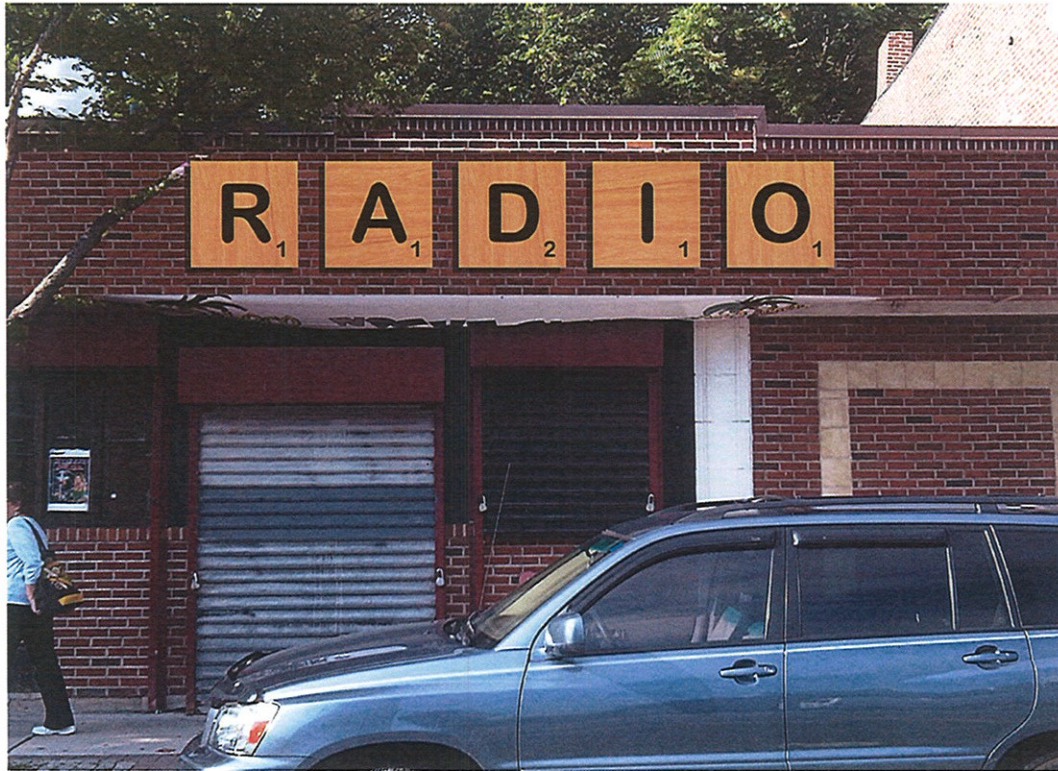

"RADIO" tiles carved wood
 Satin marine grade polyurethane finish
 24"H X24"W X3"D
 Stud mount & construction adhesive to brick facade



FRONT

3"




SIDE


**WILSON
SIGNS**

COPYRIGHT 2011. BY WILSON SIGN COMPANY. ALL DESIGNS ARE THE SOLE PROPERTY OF WILSON SIGN AND MAY NOT BE REPRODUCED IN PART OR WHOLE W/OUT WRITTEN PERMISSION OF WILSON SIGN

WWW.WIL-SIGN.COM
 BOSTON, MA 02122
 WILSONSIGN@GMAIL.COM
 617-671-8344

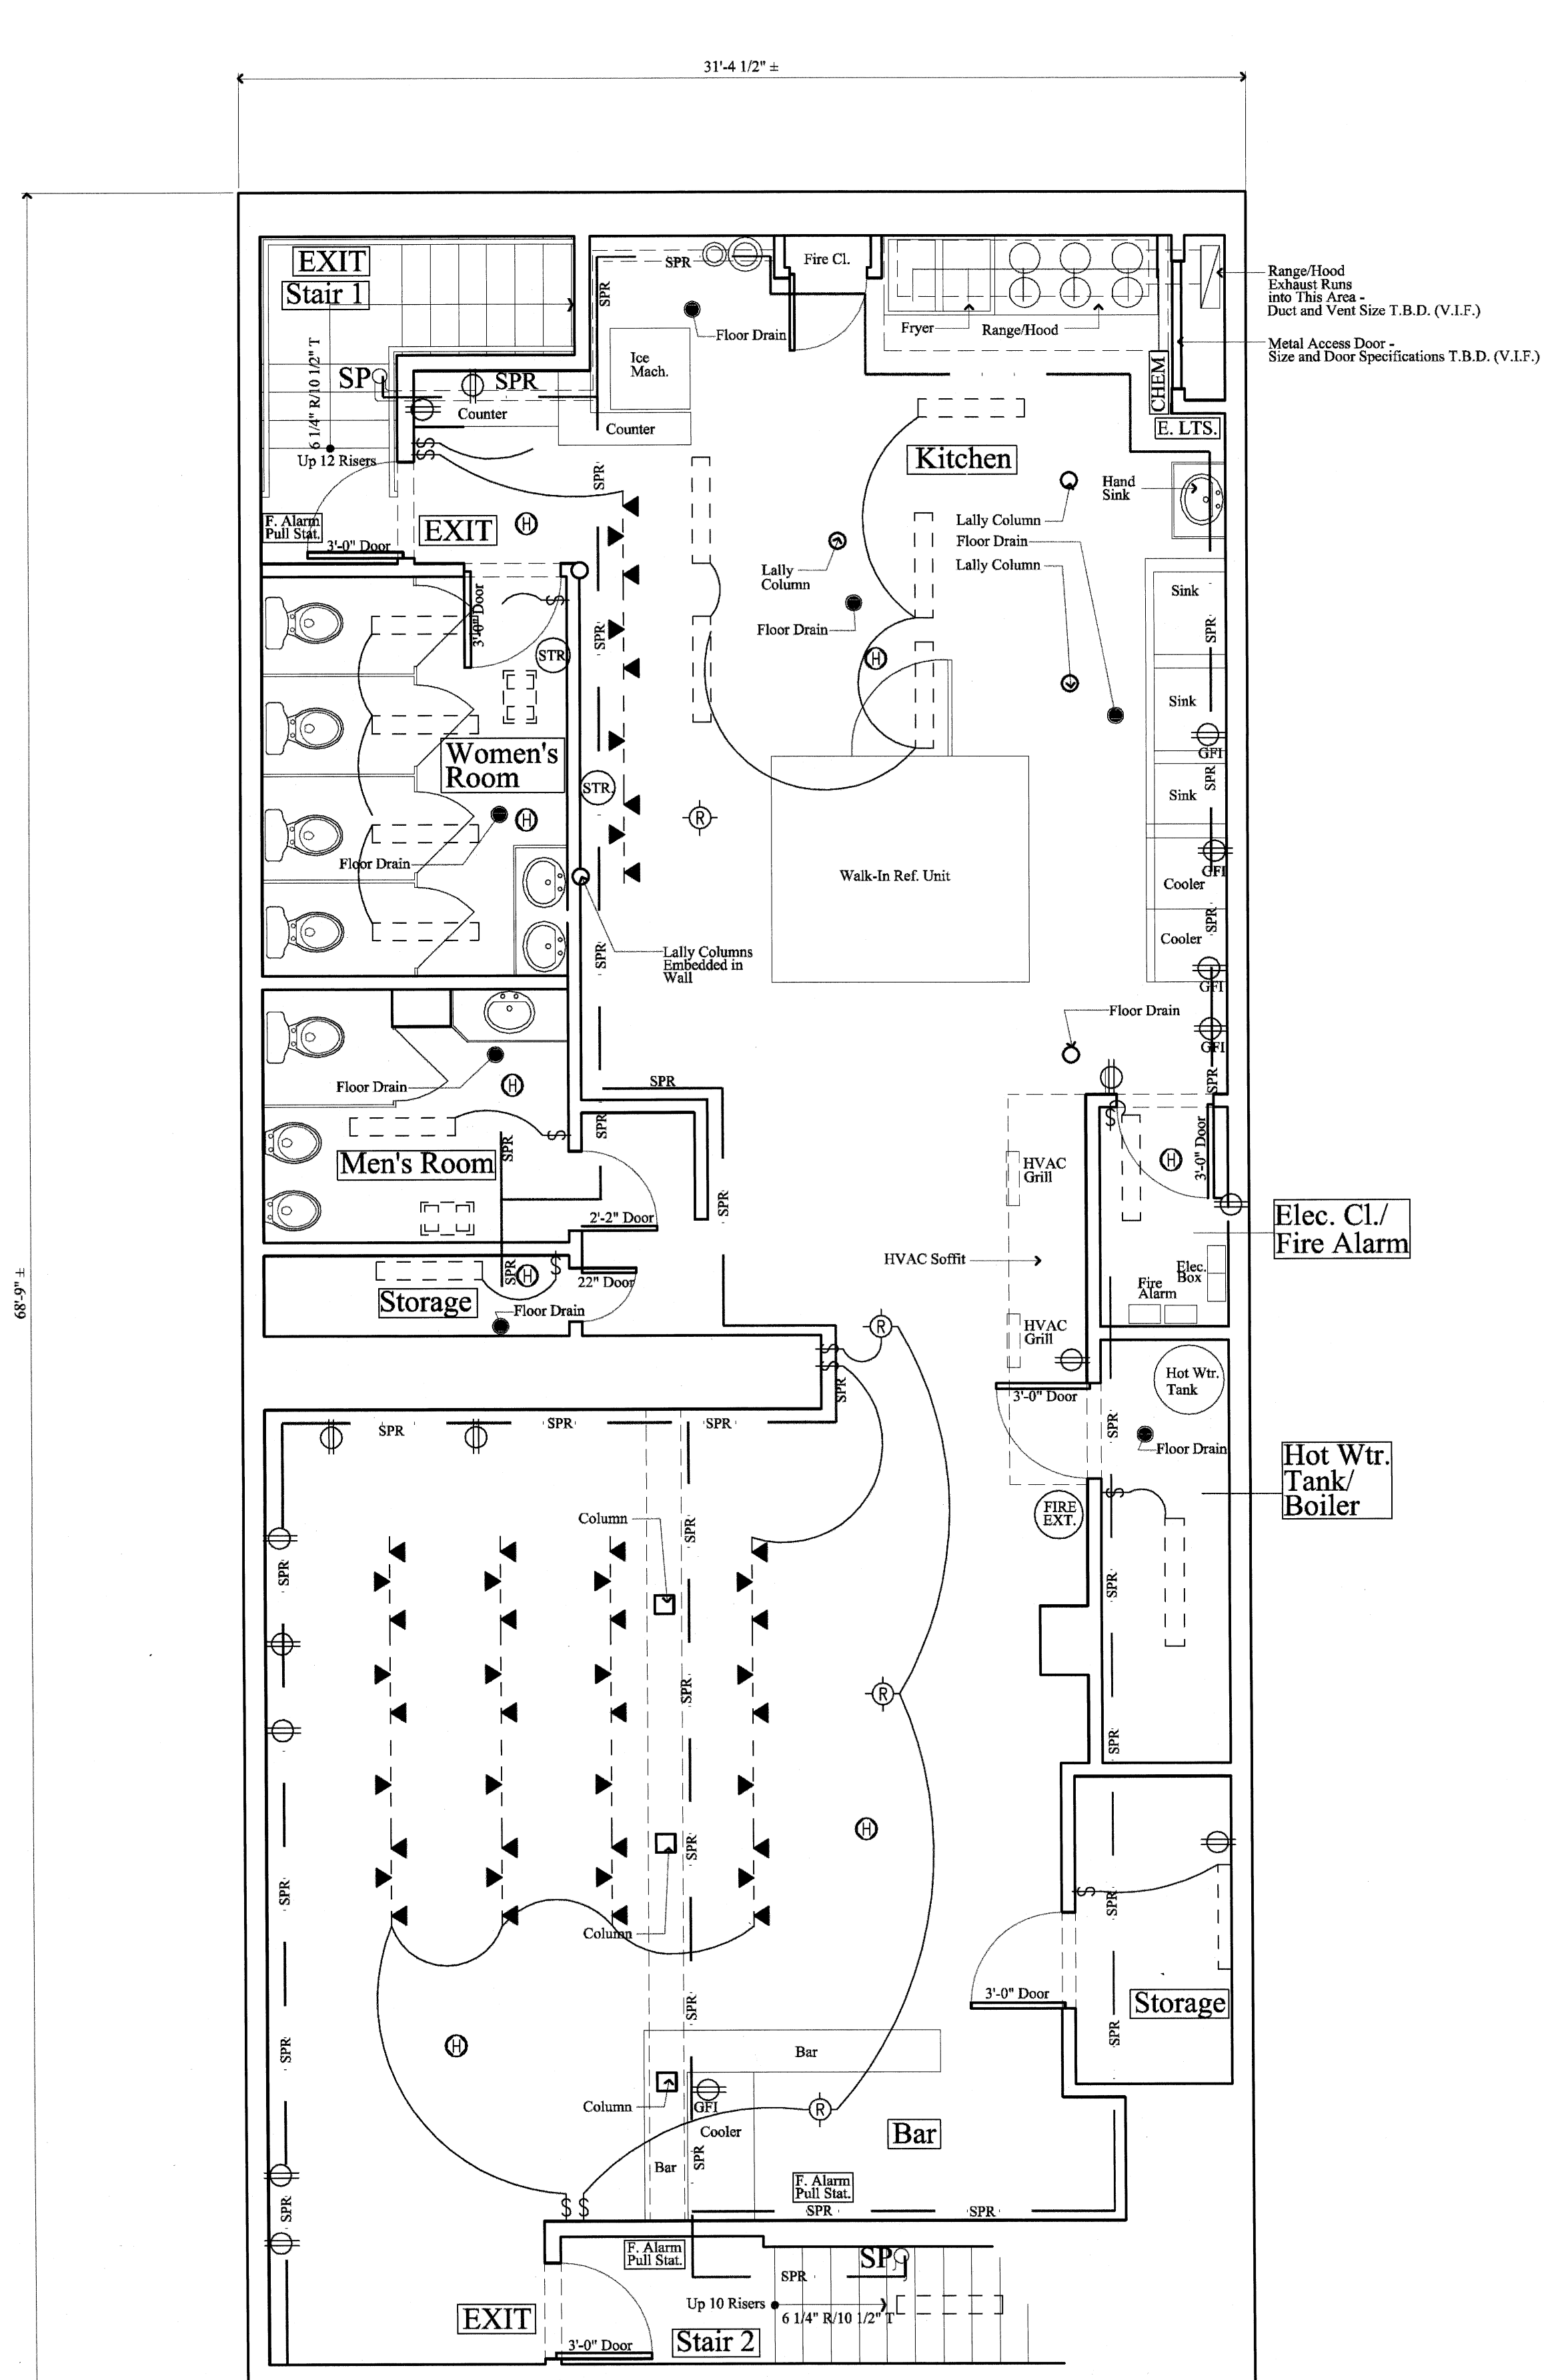

BASEMENT LEVEL
SCALE: 1/4"=1'-0"

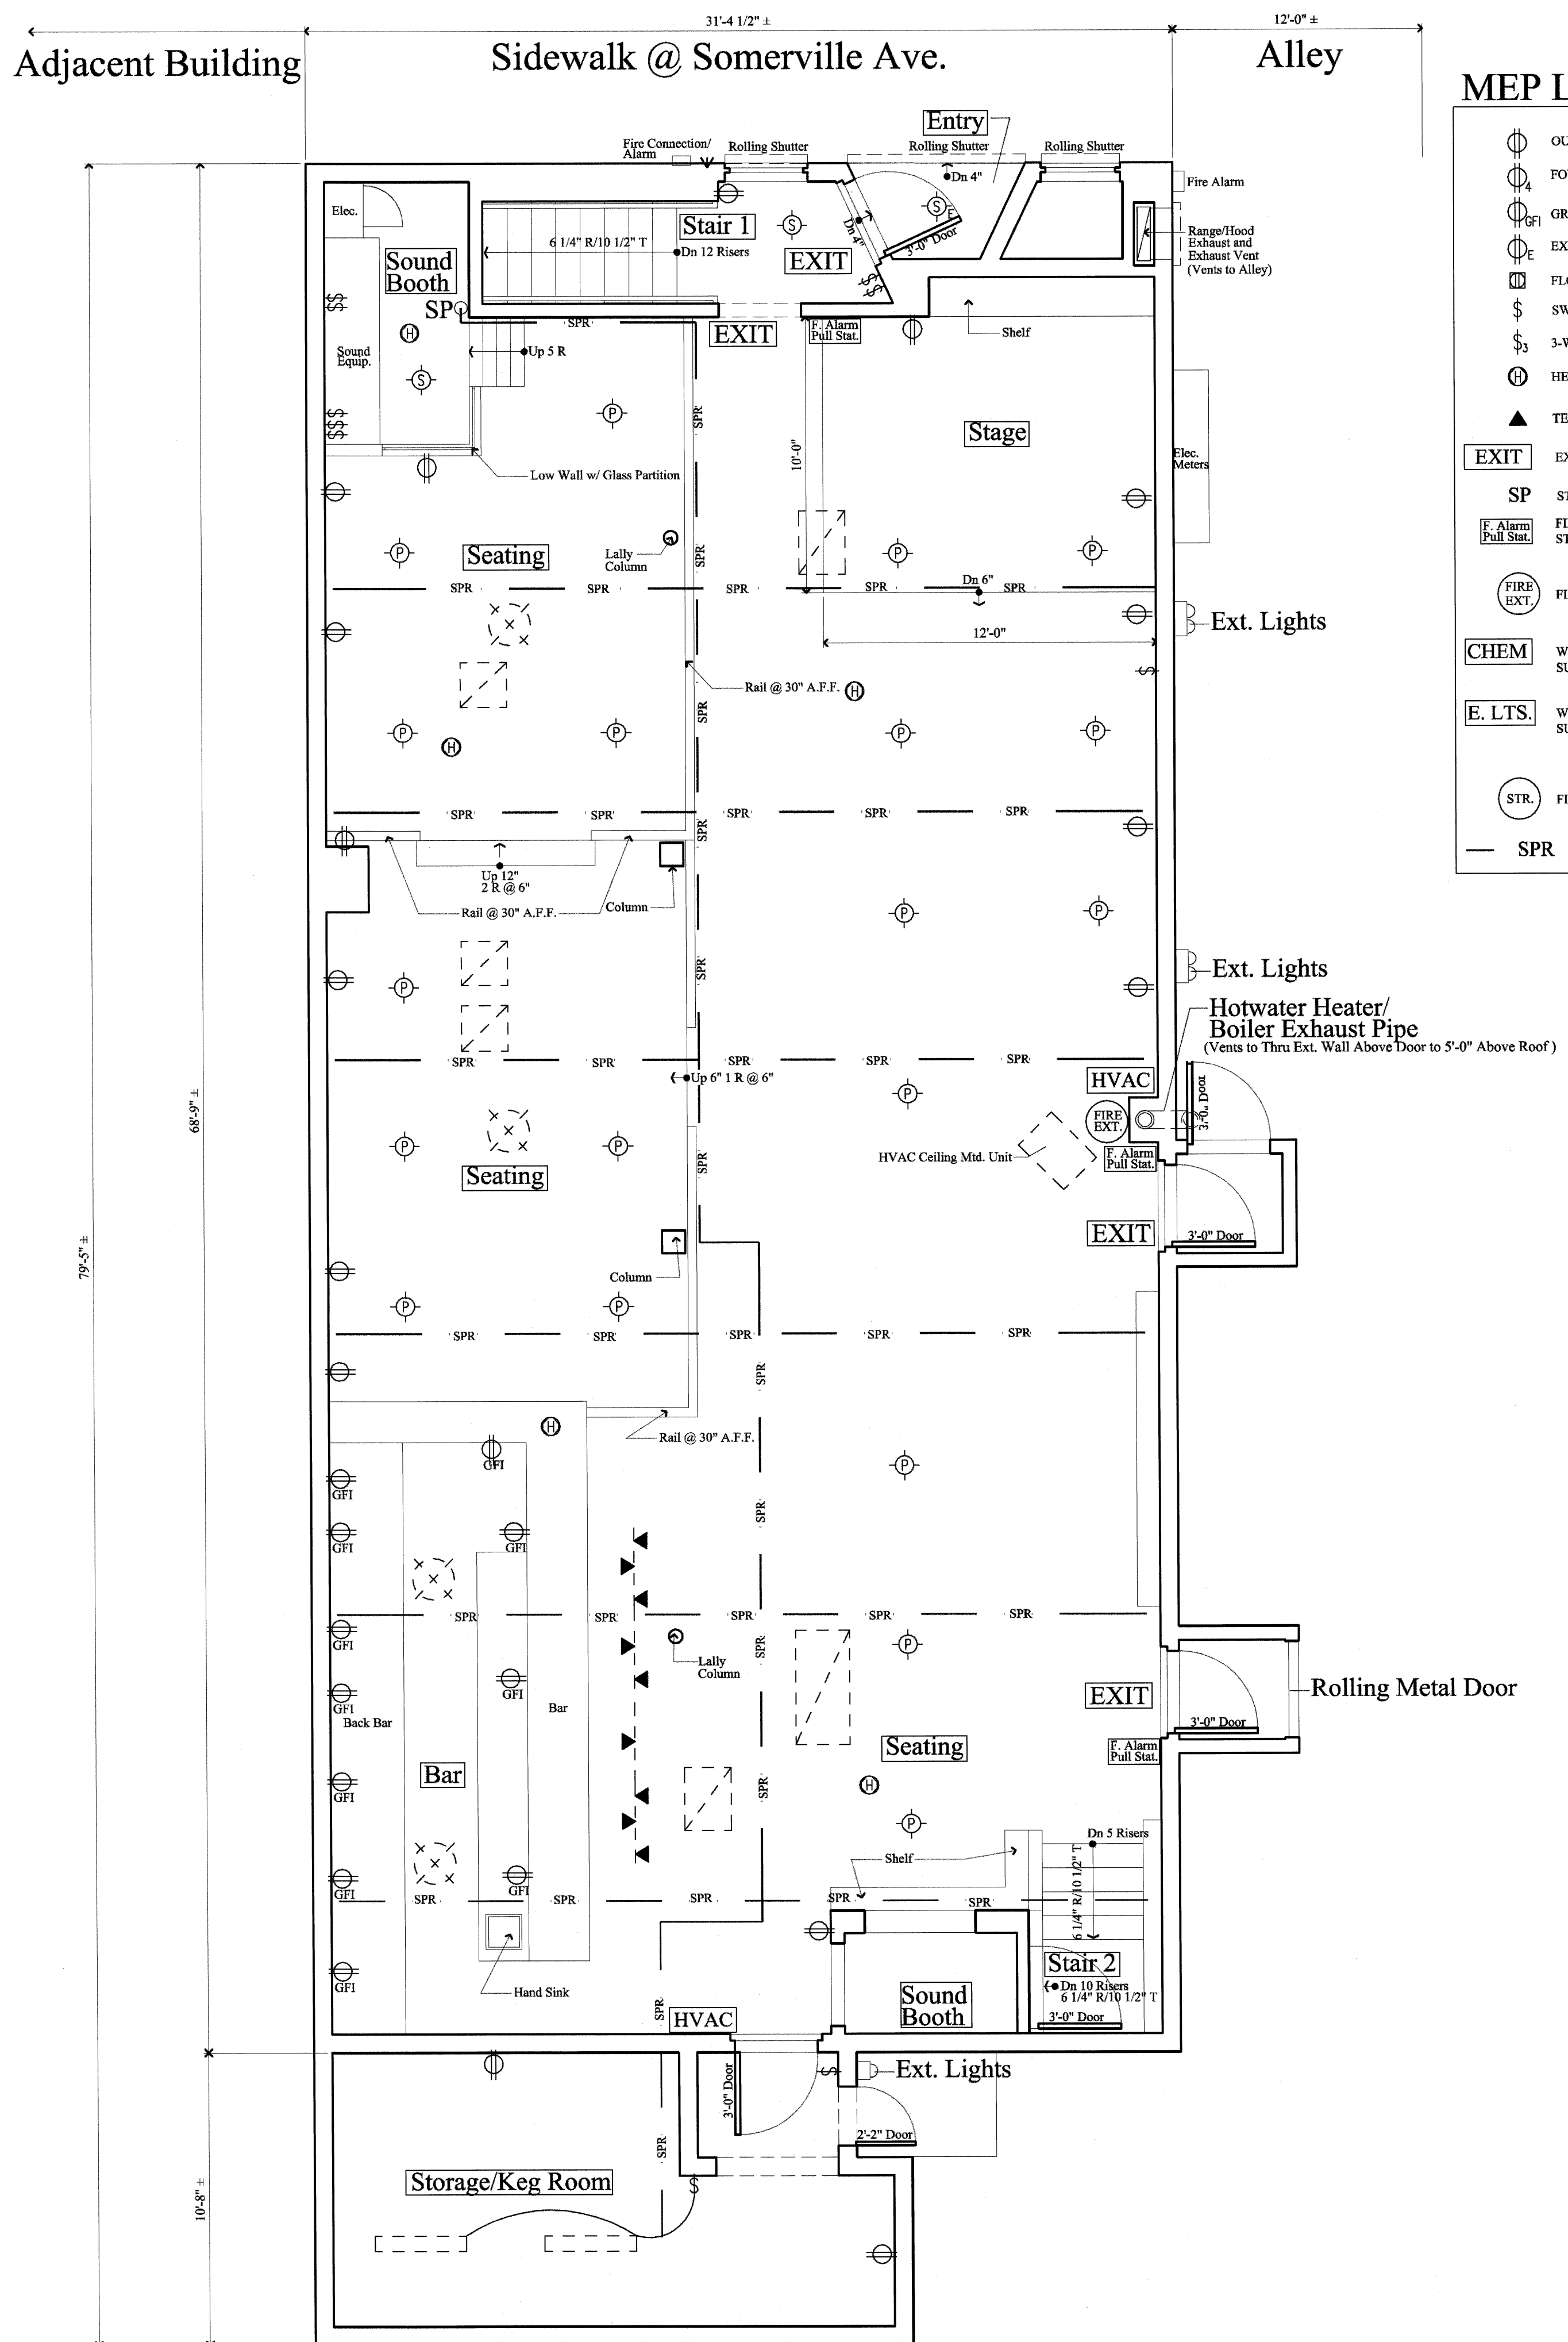

MAIN LEVEL
SCALE: 1/4"=1'-0"

MEP LEGEND

OUTLET	CABLE
FOURPLEX	PENDANT FIXTURE
GROUND FAULT	RECESSED FIXTURE
EXTERIOR OUTLET	EMERGENCY LIGHTING
FLOOR OUTLET	WALL-MOUNT FIXTURE
SWITCH	SURFACE FIXTURE
3-WAY SWITCH	SURFACE MOUNTED FLUORESCENT FIXTURE
HEAT DETECTOR	WALL-MOUNT FIXTURE EXTERIOR
TELEPHONE	PENDANT FIXTURE EXTERIOR
EXIT	EXIT SIGN w/ EMERG. LIGHT
SP	STAND PIPE
F. Alarm Pull Stat.	FIRE ALARM PULL STATION
FIRE EXT.	FIRE EXTINGUISHER
CHEM	WET CHEMICAL FIRE SUPPRESSION SYSTEM
E. L.T.S.	WET CHEMICAL FIRE SUPPRESSION SYSTEM
STR.	FIRE STROBE
SPR	FIRE SPRINKLER
	CABLE
	PENDANT FIXTURE
	RECESSED FIXTURE
	EMERGENCY LIGHTING
	WALL-MOUNT FIXTURE
	SURFACE FIXTURE
	SURFACE MOUNTED FLUORESCENT FIXTURE
	WALL-MOUNT FIXTURE EXTERIOR
	PENDANT FIXTURE EXTERIOR
	SURFACE MOUNTED FIXTURE EXTERIOR
	TOILET RM. EXHAUST/SURFACE MOUNT LIGHT
	TRACK LIGHTING
	EXTERIOR MOUNTED FLOOD LIGHT
	HVAC
	HVAC CONTROLS
	FLOOR DRAIN
	HVAC GRILL IN CEILING

blanchard A+D
architecture + design
49 CHERRY STREET
SOMERVILLE, MA 02144
1100 BROADVIEW AVE.
TELEPHONE 617-519-5434

Project:
RADIO
379 SOMERVILLE AVE.
SOMERVILLE, MA

Issue Dates and Revisions:

Not For Construction

General Notes:
General Contractor shall make all Subcontractors and Suppliers aware of the requirements of these notes.
All work shall be performed in compliance with all applicable Local, State and National Building, Life Safety and Electrical Codes.
General Contractor shall be responsible for securing all permits as necessary for the completion of work shown throughout the Contract Documents.
General Contractor shall lay out in the field the entire work to verify dimensional relationships before constructing any part, and shall verify all existing conditions and locations before proceeding.
Failure to verify dimensions and conditions before proceeding may subject the General Contractor to the required removal of completed work at General Contractor cost, if a discrepancy which could have been discovered causes modifications to the plans.
General Contractor shall coordinate the dimensional requirements between the work of the various trades.
Any discrepancies found in the plans, dimensions, existing conditions or any apparent error in the classifying or specifying of a product, material or means of assembly is to be pointed out to the Architect immediately.
Drawings shall not be scaled for dimensions and/or sizes. Owner and Architect assume no responsibility for use of incorrect scale.
Regardless of whether or not an item is shown or specified, General Contractor shall provide said item if it is necessary for the proper installation or function of an item shown or specified. Suppliers and Subcontractors shall inform the General Contractor of their requirements for the work of other trades, which may not be indicated, prior to bidding.
All dimensions to interior/exterior walls indicated are to face of stud wall or concrete, m.s. unless noted otherwise.

Copyright Note:
Blanchard A+D (Architect) expressly reserves the Common Law Copyrights and other Property Rights in these drawings. These drawings are the property of blanchard A+D and shall not be reproduced in any manner nor shall they be assigned for use to any third party without first obtaining the expressed written permission from blanchard A+D (Architect).
© 2011 blanchard A+D, LLC

Registration:

Drawing Title:
"As-Built" Plan
Main Level/Basement

Drawn: thblanchard@gmail.com
Checked: thblanchard@gmail.com
Project Number:
Date: October 28, 2011
Drawing Number:

A1.0