



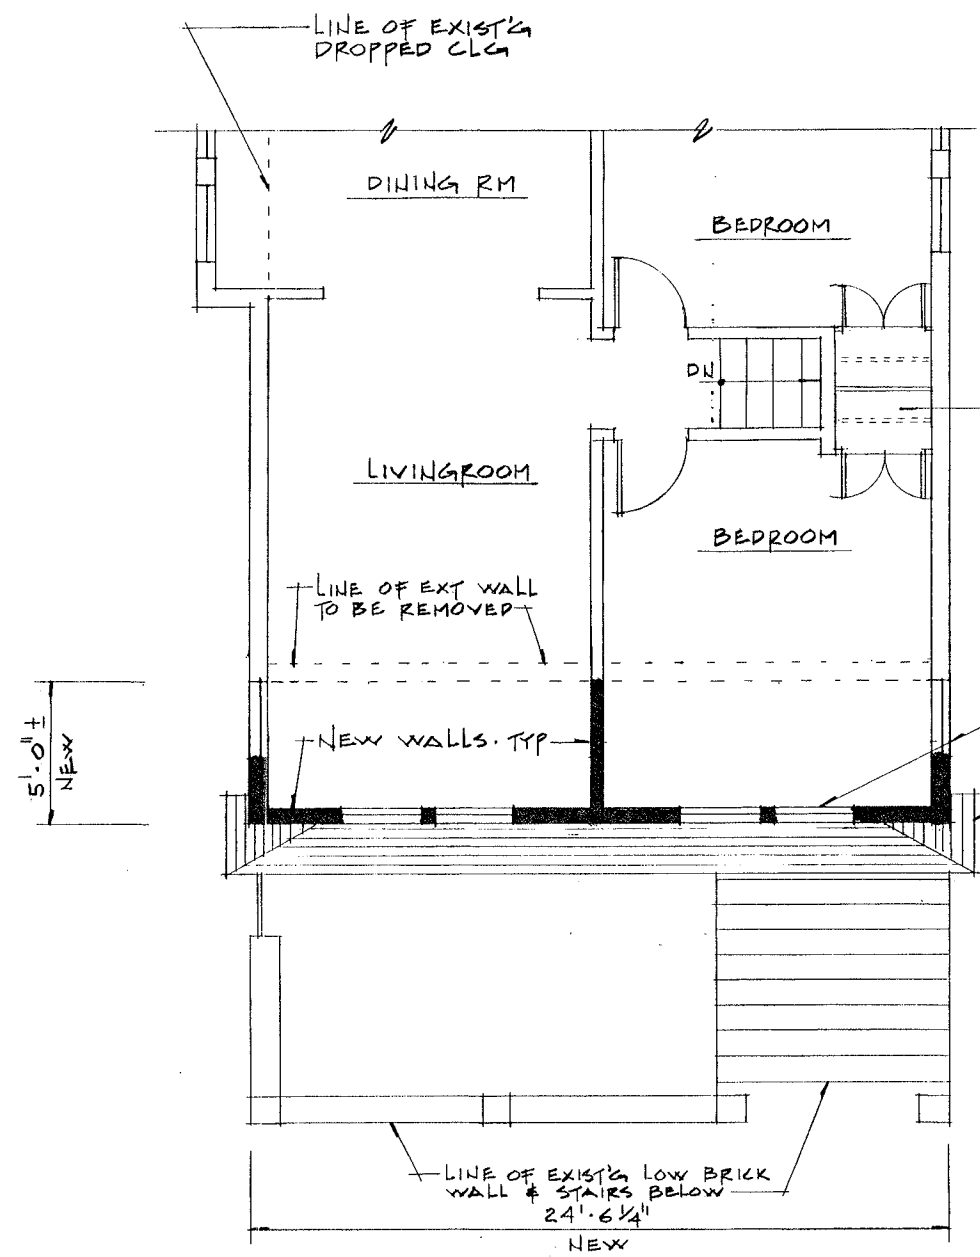

PARTIAL 2ND FLOOR PLAN
 SCALE : 1/4" = 1'-0"


NOTE: NEW CONSTRUCTION
 EQUALS 123 SQ FT

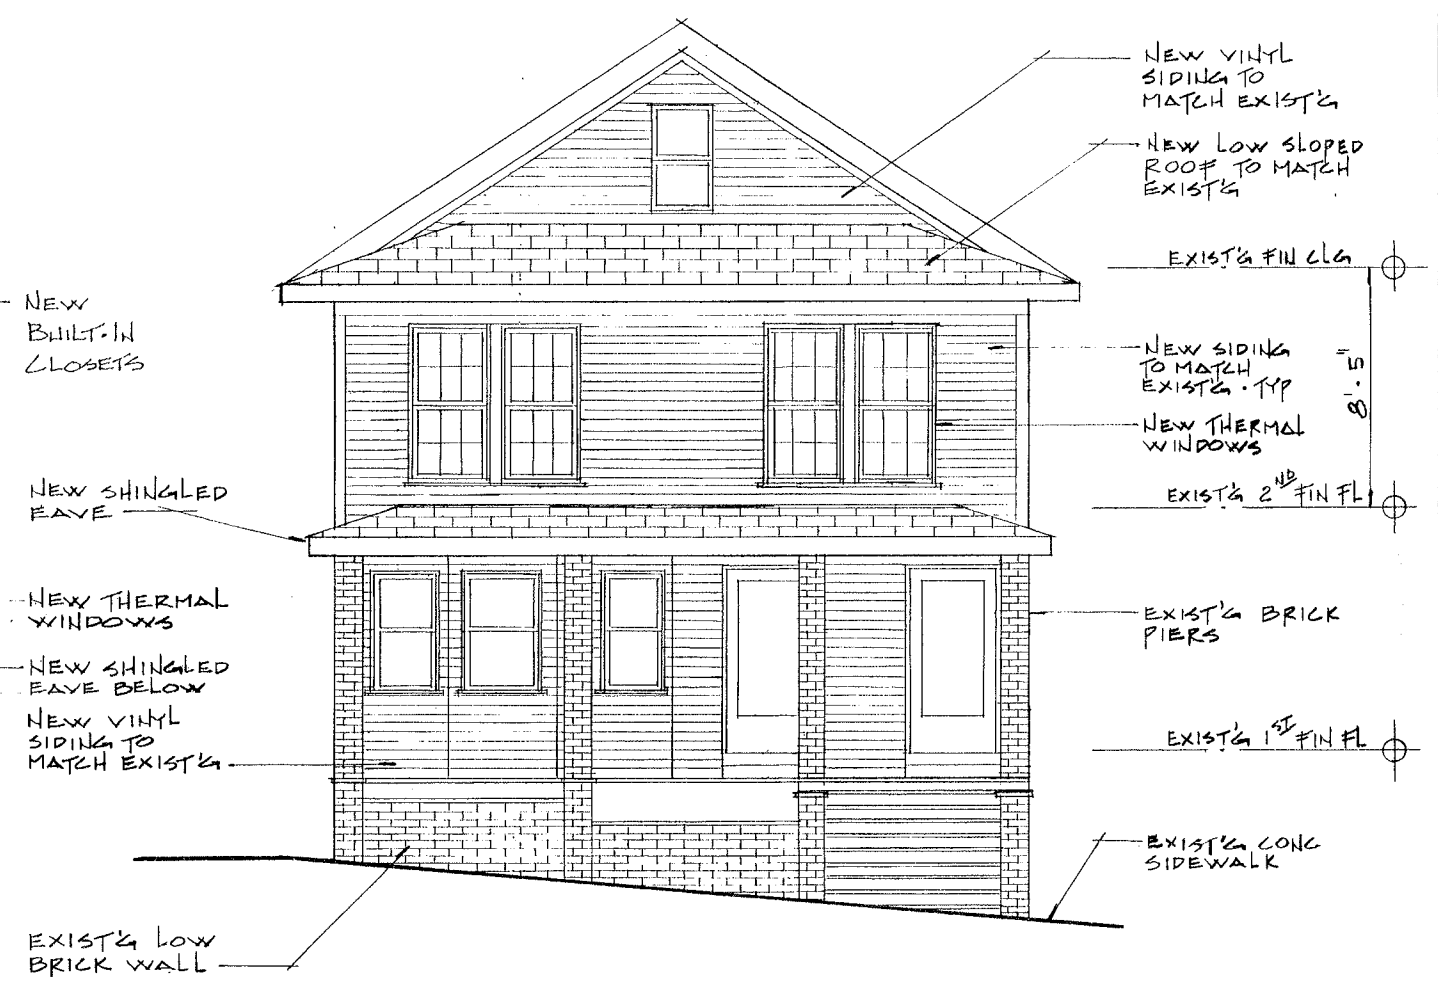


EAST ELEVATION
 SCALE : 1/4" = 1'-0"



ADDITIONS & RENOVATIONS FOR
 BREEN RESIDENCE
 34 FENWICK STREET
 SOMERVILLE, MA. 02143
 BY PHILIP RUSSO, R.A.
 131 NOTTINGHILL ROAD, BRIGHTON, MA. 02135
 TEL: 617-893-0238 3.14.2009
 REVISED 4.4.09, 4.16.09, 1.30.10

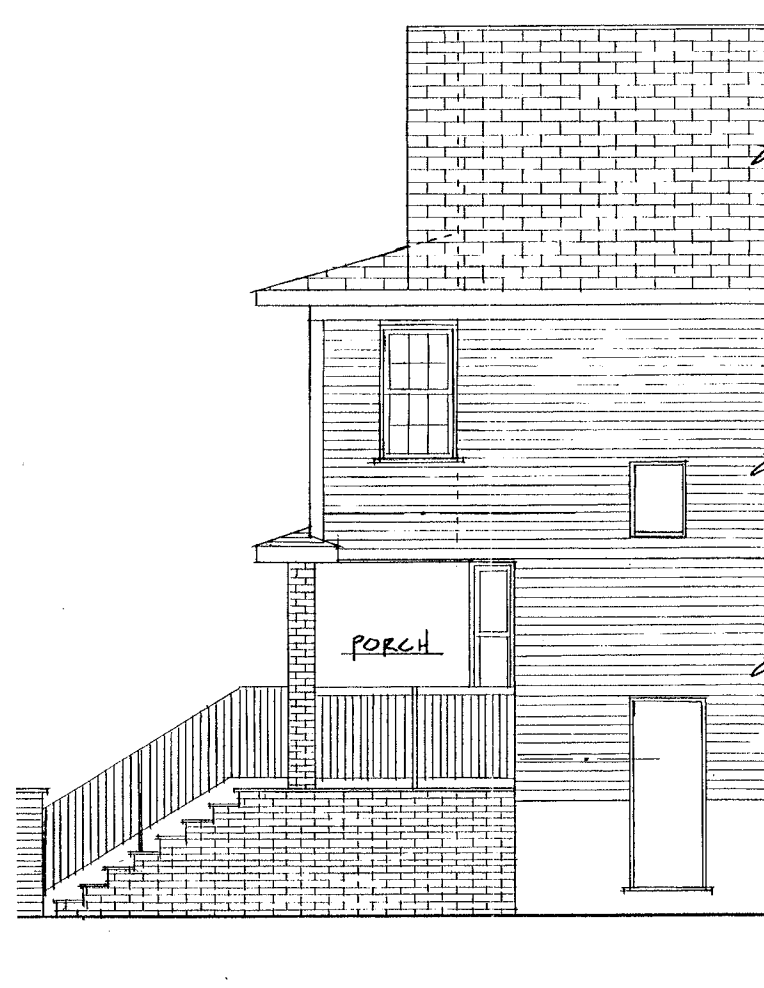


NORTH ELEVATION
SCALE: 1/4" = 1'-0"

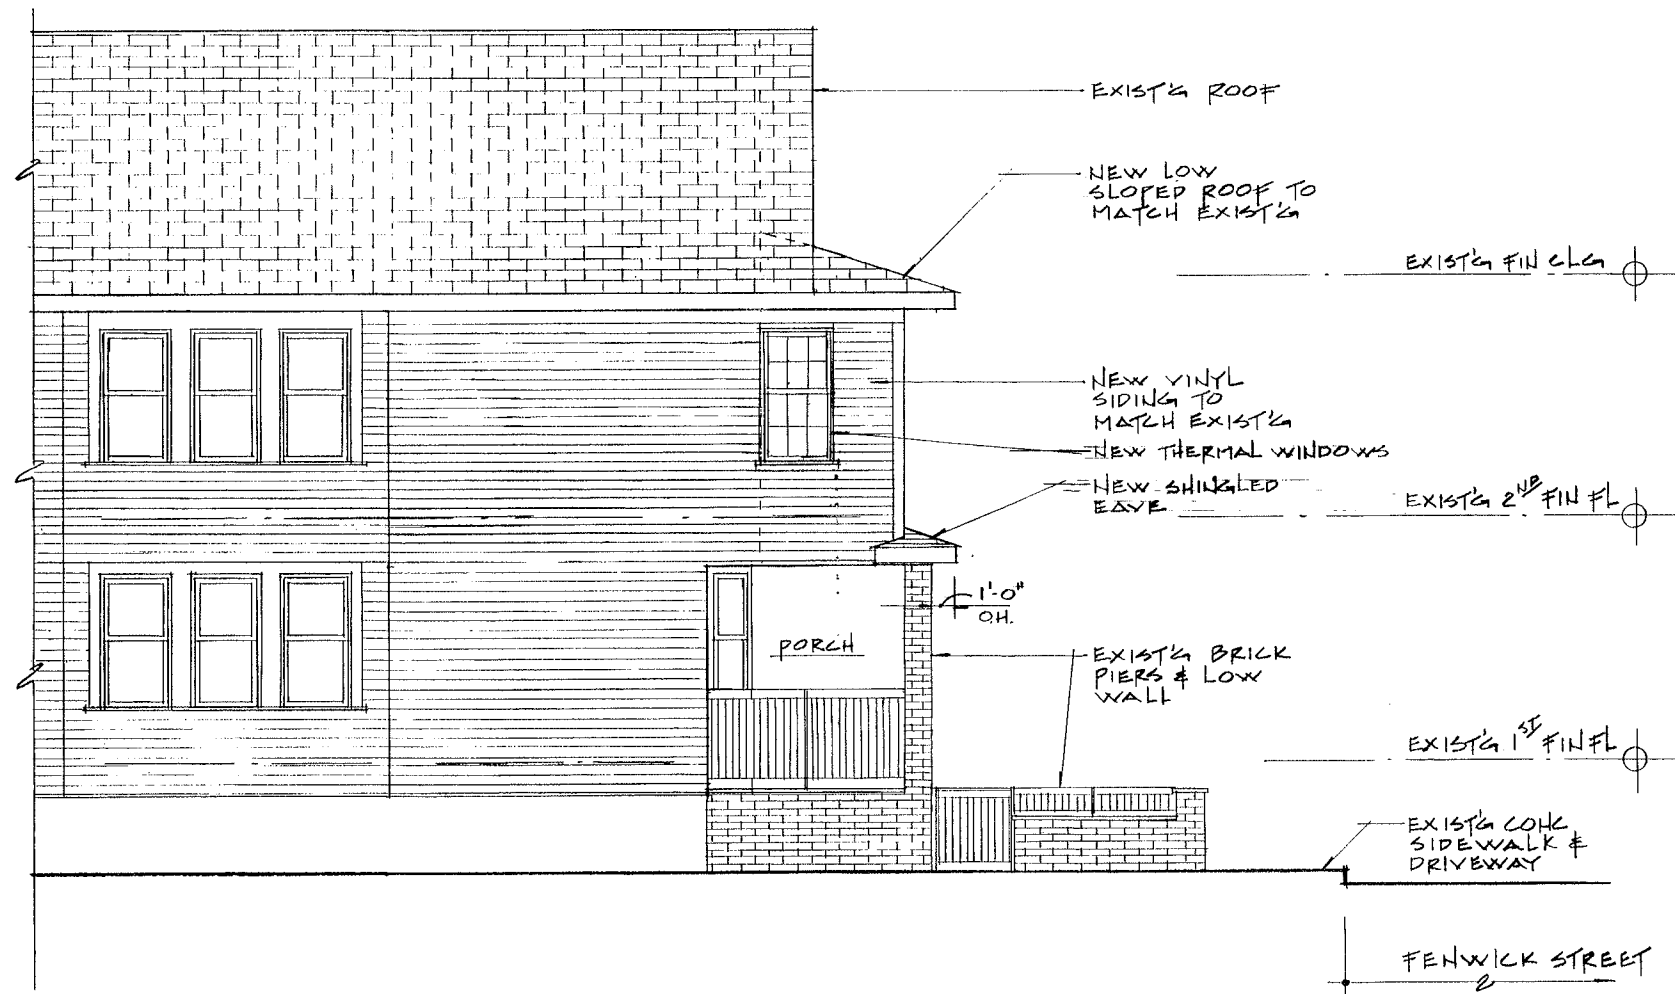

SOUTH ELEVATION
SCALE: 1/4" = 1'-0"



ADDITIONS & RENOVATIONS FOR
BREEN RESIDENCE
34 FENWICK STREET
SOMERVILLE, MA. 02143
BY PHILIP RUSSO, R.A.
131 NOTTINGHILL ROAD, BRIGHTON, MA. 02135
TEL: 617-893-0238 4.4.2009
REVISED 4.16.09 1.30.10

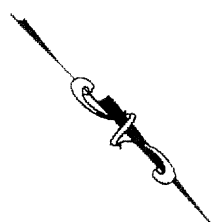

N/F
JOSEPHINE M. GALIMI


N/F
SANDRA NAZZARO

N/F
NANCY E. THOMPSON
&
LINDA J. THOMPSON

Middlesex Registry of Deeds
Southern District
Cambridge, Massachusetts
Plan No. 42542
Rec'd 1-26 2006
at 12 H 10 M 20 N

Attest
Agnes C. Brown
Register

FOR REGISTRY USE ONLY

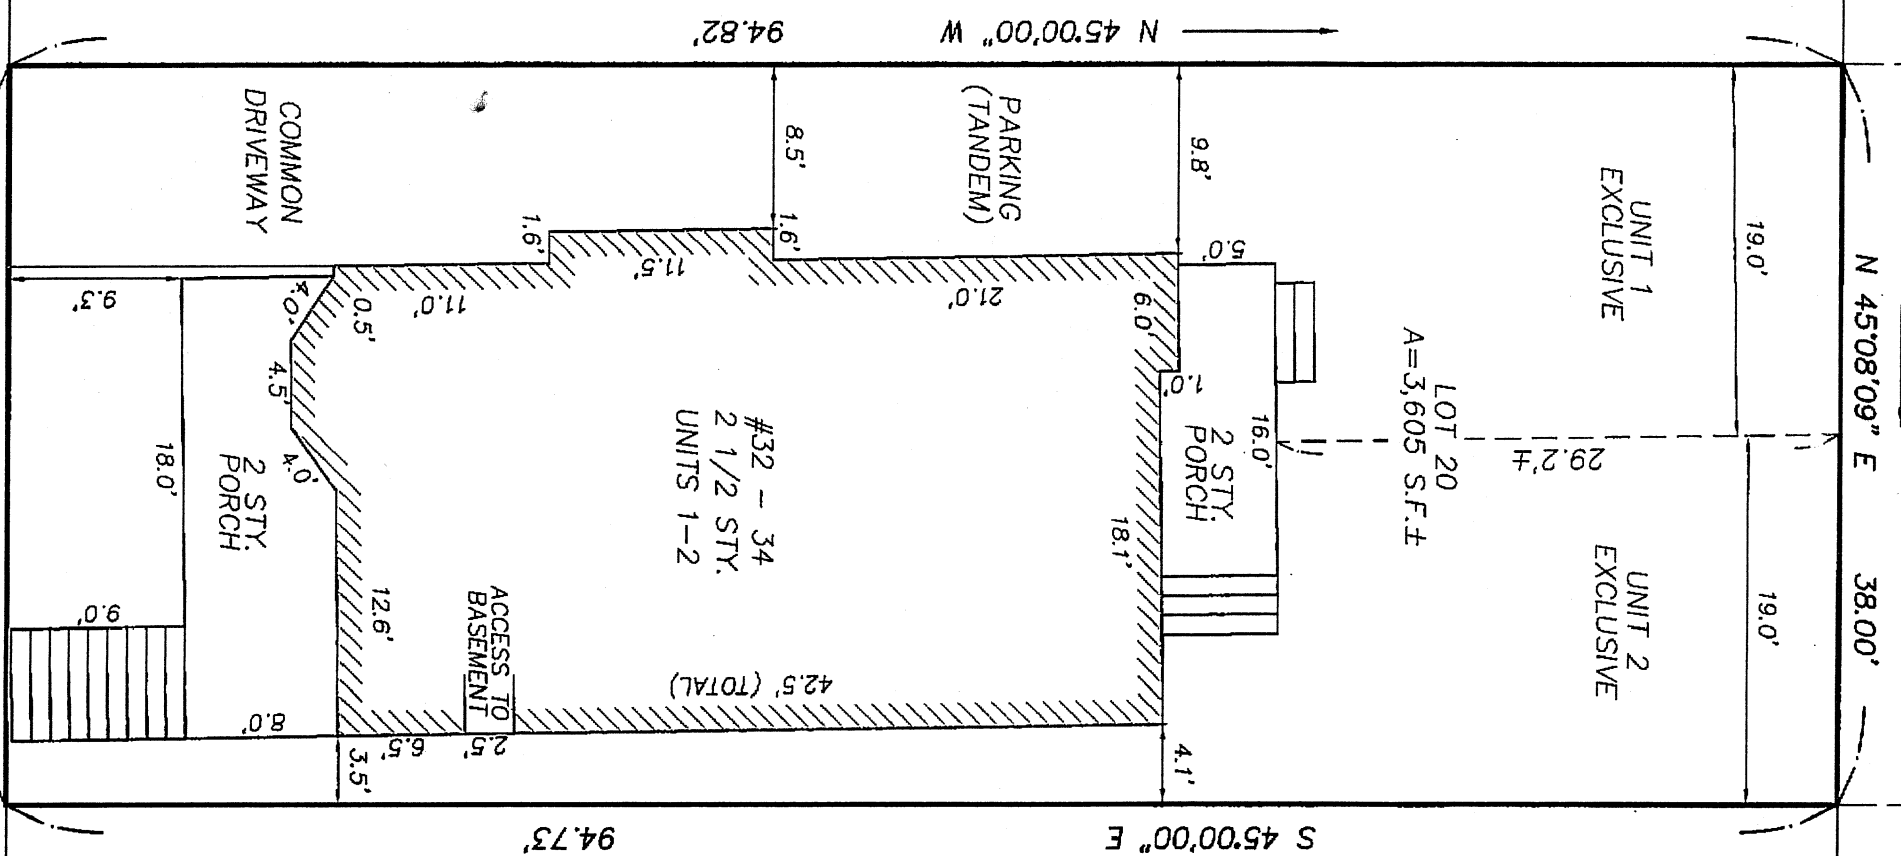

N/F
ELSIE NAVES
&
NORMA LORENZO

N/F
MOHAMMAD ABOUCHLEIH

I HEREBY CERTIFY THAT:


THIS PLAN WAS PREPARED IN ACCORDANCE WITH THE RULES AND REGULATIONS OF THE REGISTERS OF DEEDS DATED JANUARY 1, 1976 AND REVISED JANUARY 12, 1988.

ACCORDING TO DEEDS AND PLANS OF RECORD THE PROPERTY LINES SHOWN HEREON ARE THE LINES DIVIDING EXISTING OWNERSHIP AND THE LINES OF STREETS AND WAYS SHOWN ARE THOSE OF PUBLIC OR PRIVATE STREETS AND WAYS ALREADY ESTABLISHED AND NO NEW LINES FOR THE DIVISION OF EXISTING OWNERSHIP OR FOR NEW STREETS OR WAYS ALREADY ESTABLISHED.

THIS PLAN FULLY AND ACCURATELY DEPICTS THE LOCATION AND DIMENSION OF THE BUILDING, AS BUILT, AND FULLY LISTS THE UNITS CONTAINED THEREIN.

EDWARD J. FARRELL

PLS.

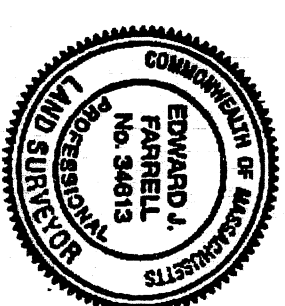

SITE PLAN

For

**32 - 34 FENWICK STREET
CONDOMINIUM ASSOC.**

**32 - 34 FENWICK STREET
SOMERVILLE, MASSACHUSETTS**

SCALE: 1" = 10' JUNE 30, 2006

Prepared By

EDWARD J. FARRELL

PROFESSIONAL LAND SURVEYOR

110 WINN STREET ~ SUITE 203 ~ WOBURN, MA.

(781) - 933 - 9012

GRAPHIC SCALE

1" = 10'



9/2/06