




101 Walnut Street, P.O. Box 9151
Watertown, Massachusetts 02471
617.924.1770 • FAX 617.924.2286

1. SEE SHEET C1.01 FOR REFERENCES AND SHEET C2.01 FOR LEGEND.
2. LOCATIONS OF UNDERGROUND UTILITIES SHOWN HEREON WERE COMPILED FROM AVAILABLE RECORD PLANS OF UTILITY COMPANIES AND ARE APPROXIMATE AND ASSUMED. BEFORE COMMENCING SITE WORK, CONTRACTOR SHALL CALL "DIG SAFE" AT 1-800-344-7238 AND LOCAL MUNICIPAL UTILITY DEPARTMENTS TO ACCURATELY LOCATE UNDERGROUND UTILITIES. THE CONTRACTOR SHALL NOTIFY APPROPRIATE UTILITY AGENCIES / DEPARTMENTS OF ANY UTILITIES DAMAGED DURING CONSTRUCTION. ANY COSTS RELATED TO THE REPAIR OF UTILITIES DAMAGED AS A RESULT OF CONSTRUCTION ACTIVITY SHALL BE THE CONTRACTOR'S RESPONSIBILITY. NO EXCAVATION SHALL BE PERFORMED UNTIL ALL UTILITY COMPANIES HAVE BEEN NOTIFIED.
3. PRIOR TO CONSTRUCTION AN EROSION CONTROL BARRIER (ECB) SHALL BE INSTALLED AS SHOWN ON THE PLANS. THE CONTRACTOR SHALL BE RESPONSIBLE FOR MAINTAINING THE ECB THROUGHOUT ALL PHASES OF CONSTRUCTION AS WELL AS COMPLYING WITH ANY OTHER CONDITIONS ESTABLISHED IN THE CONDITIONS OF THE JULY 2008 ZBA DECISION.
4. ALL DISTURBED AREAS SHALL BE LOANED AND SEEDED UNLESS OTHERWISE SPECIFIED ON THE PLANS.
5. EXISTING PAVEMENT SHALL BE SAW CUT, AND NEW PAVEMENT SHALL BE BLENDED SMOOTHLY TO MEET CUT EDGES.
6. ALL UTILITY COVERS, GRATES, HATCHES, ETC., SHALL BE FLUSH WITH THE PAVEMENT FINISHED GRADE AND SHALL MEET THE SPECIFICATIONS OF THE CITY OF SOMERVILLE.
7. FINAL GRADES SHALL BE PITCHED EVENLY BETWEEN SPOT ELEVATIONS.
8. ALL GRADES IN HANDICAPPED ACCESSIBLE PARKING SPACES SHALL NOT EXCEED 2% IN ANY DIRECTION (PER 321 CHR 234.5).
9. ALL GRADES IN HANDICAPPED ACCESSIBLE WALKWAYS SHALL NOT EXCEED 5% (PER 321 CHR 22.9) AND SHALL NOT HAVE A CROSS PITCH OF MORE THAN 2% (PER 321 CHR 22.9).
10. THE PROPOSED IMPROVEMENTS SHOWN HEREON ARE SUBJECT TO THE COMPLETION OF THE SITE PLAN SPECIAL PERMIT CONDITIONAL APPROVAL ISSUED BY THE ZONING BOARD OF APPEALS IN JULY 2008.

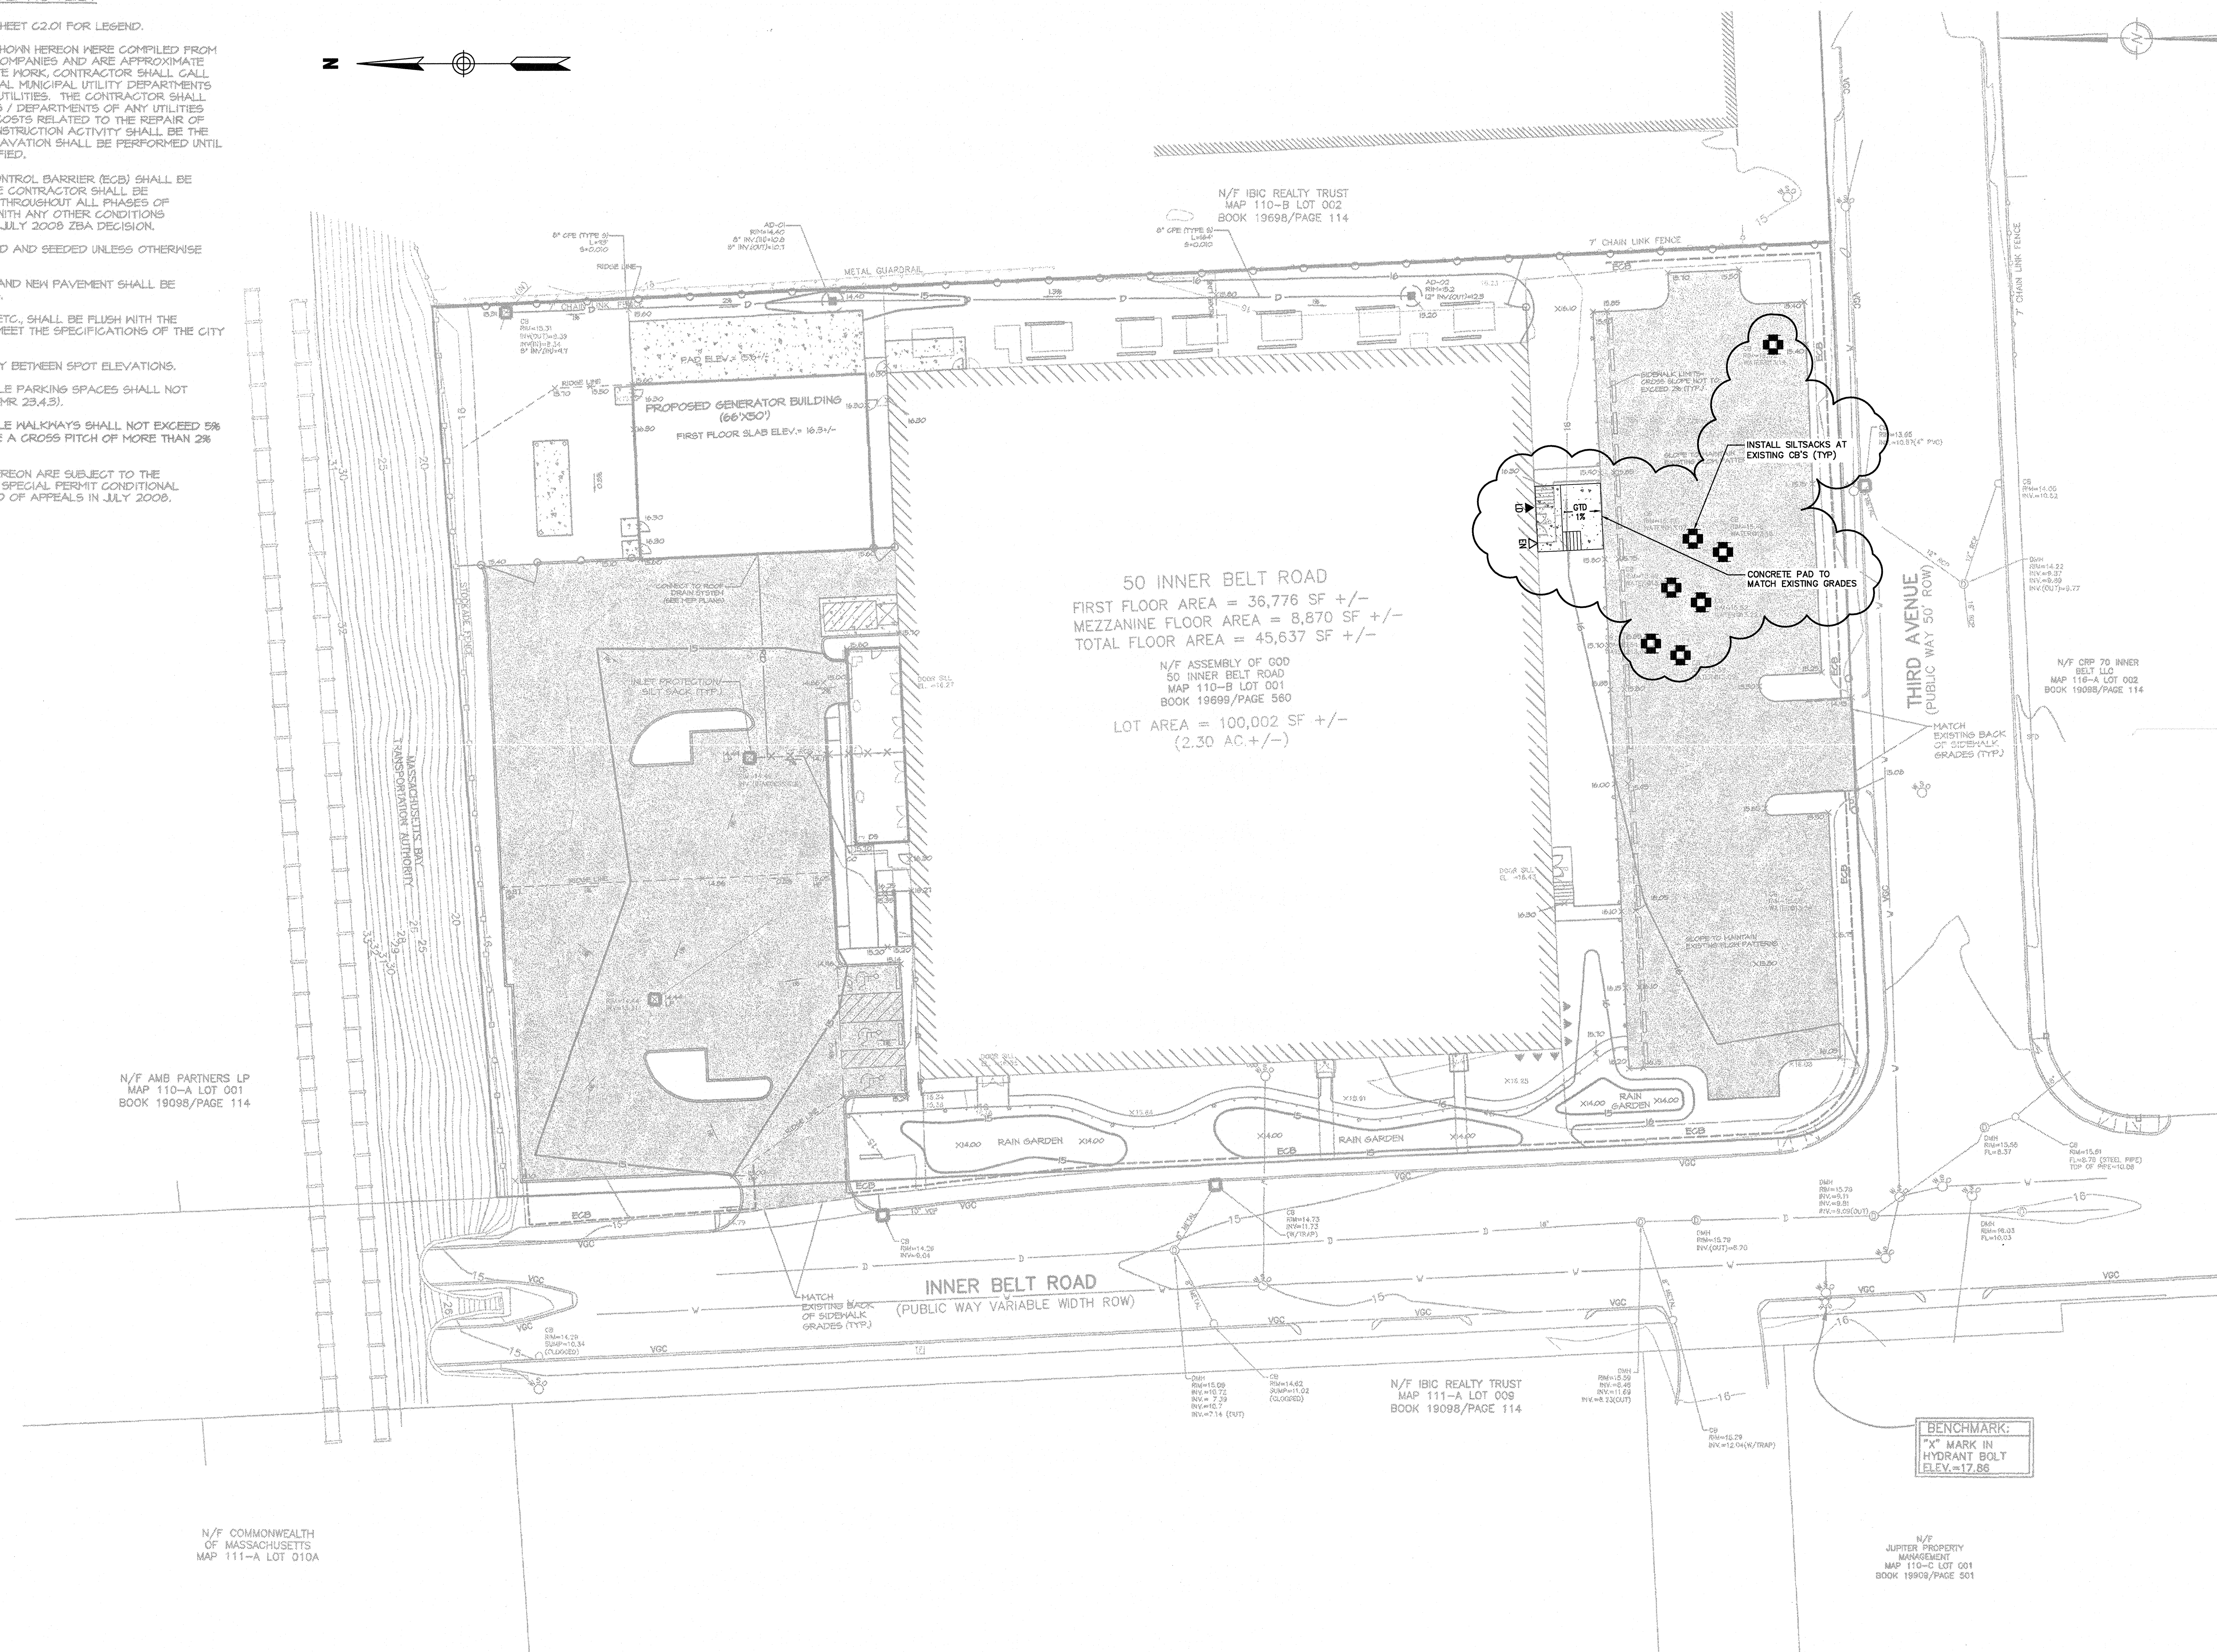

1	Loading Dock and Door	2/14/13	HGH
No.	Revision	Date	Approv
Designed by	DAG	Drawn by	DAG
CAD checked by	DAG	Checked by	HGH
Scale	1"=20'	Approved by	HGH
		Date	February 14, 2013



InterNAP Network Services Loading Dock/Door

50 Inner Belt Road
Somerville, MA

Special Permit with
Site Plan Review

Not Approved for Construction

Grading & Drainage Plan

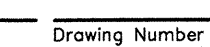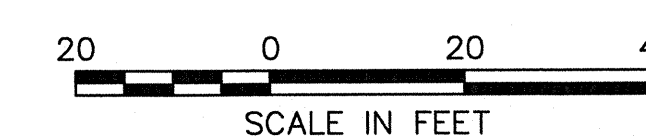

C-2

Sheet 2 of 5

Project Number
12265 00

THIS DRAWING IS NOT FOR CONSTRUCTION UNLESS SPECIFICALLY NOTED OTHERWISE.
CONSTRUCTION BY WATERMAN DESIGN ASSOCIATES, INC.